



AS BUILT ISSUE

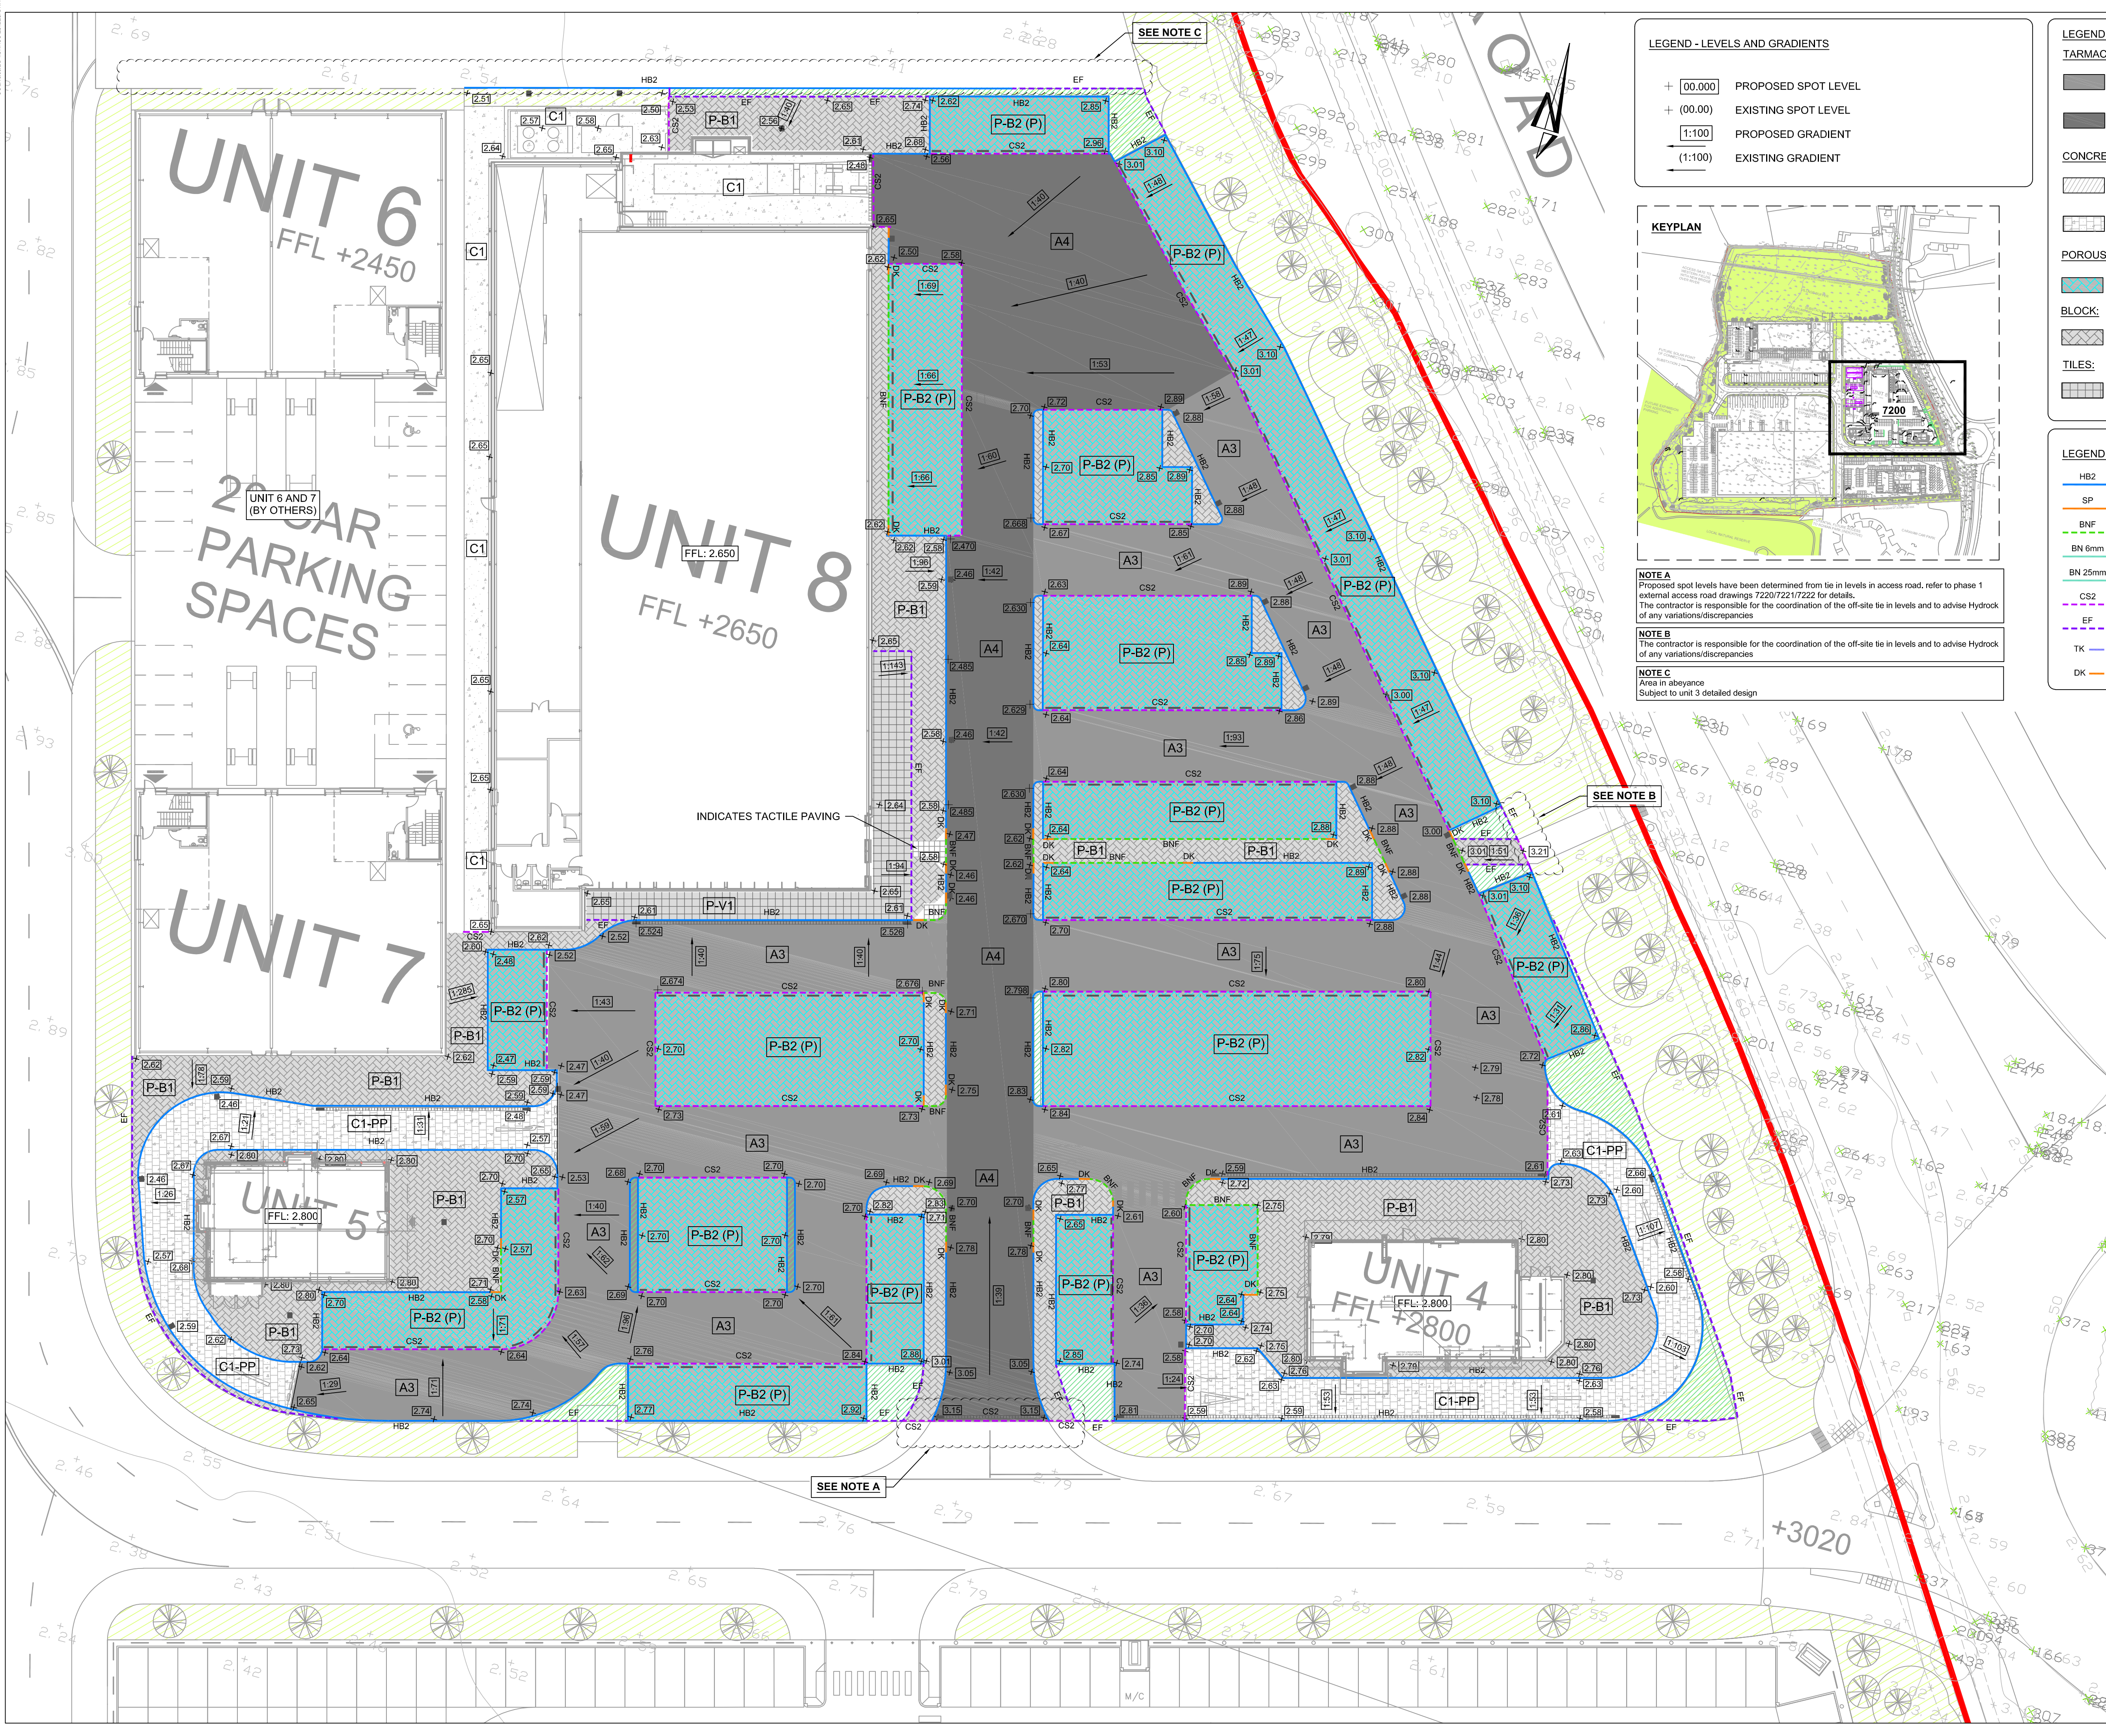

LEGEND - LEVELS AND GRADIENTS

+ [00.00] PROPOSED SPOT LEVEL
+ (00.00) EXISTING SPOT LEVEL
[1:100] PROPOSED GRADIENT
(1:100) EXISTING GRADIENT

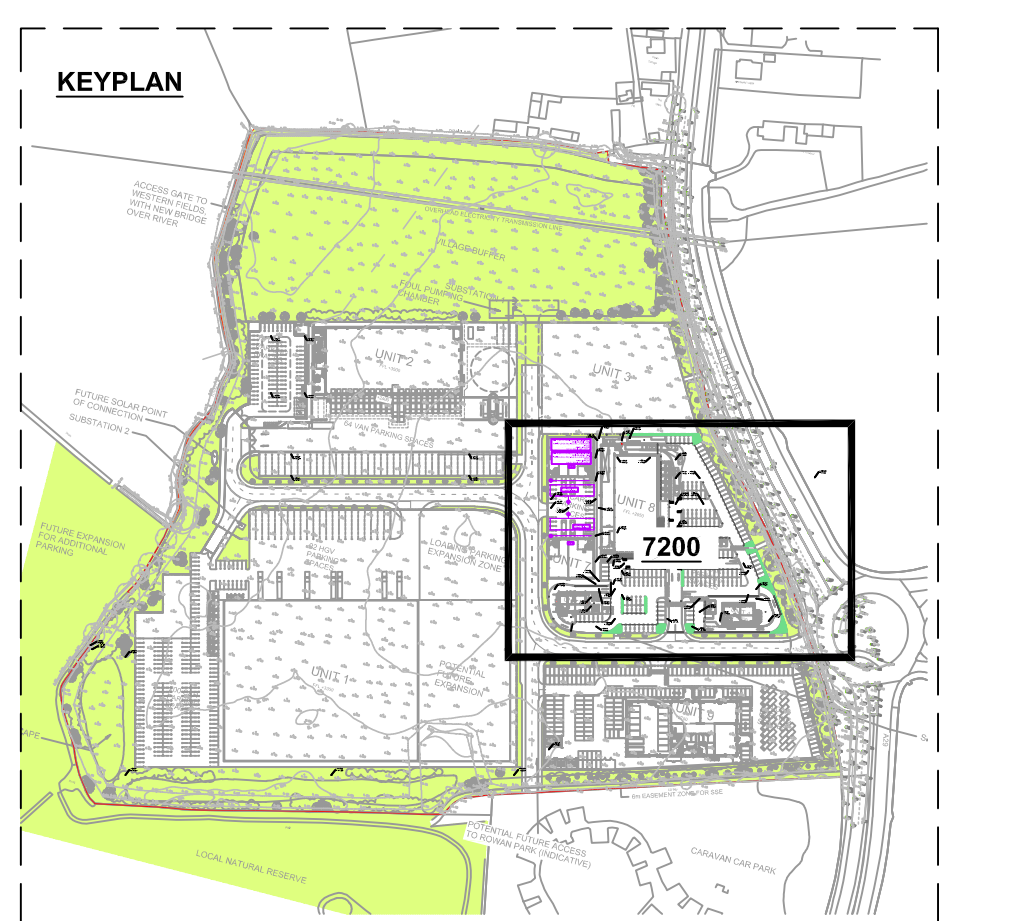

NOTE A
Proposed spot levels have been determined from tie in levels in access road, refer to phase 1 external access road drawings 7220/7221/7222 for details. The contractor is responsible for the coordination of the off-site tie in levels and to advise Hydrock of any variations/discrepancies

NOTE B
The contractor is responsible for the coordination of the off-site tie in levels and to advise Hydrock of any variations/discrepancies

NOTE C
Area in abeyance
Subject to unit 3 detailed design

LEGEND - SURFACE TYPES

TARMAC:

- TYPE A3:** ASPHALT PAVING CONSTRUCTION -
 - CARS, LIGHT VEHICLES & OCCASIONAL HGV'S
- TYPE A4:** ASPHALT PAVING CONSTRUCTION -
 - FREQUENT HGV AND COMMERCIAL VEHICLES

CONCRETE:

- TYPE C1:** CONCRETE
- TYPE C1-PP:** PATTERN IMPRINTED CONCRETE (BY PICSPAVE)
 - GREGGS AND STARBUCKS DRIVE THRO

POROUS BLOCK:

- TYPE P-B2 (P):** POROUS BLOCK PAVING CONSTRUCTION -
 - CARS, LIGHT VEHICLES, NO COMMERCIAL VEHICLES

BLOCK:

- TYPE P-B1:** BLOCK PAVING CONSTRUCTION -
 - PEDESTRIAN LOADING ONLY

TILES:

- TYPE P-V1:** VITRIFIED TILES -
 - PEDESTRIAN LOADING ONLY

LEGEND - KERB TYPES

- HB2** HALF BATTERED KERB (TYPE HB2: 125mm UPSTAND)
- SP** SPLAY KERB (TYPE SP: 125mm UPSTAND)
- BNF** BULLNOSED KERB (TYPE BN: LAID FLUSH)
- BN 6mm** BULLNOSED KERB (TYPE BN: 6mm UPSTAND)
- BN 25mm** BULLNOSED KERB (TYPE BN: 25mm UPSTAND)
- CS2** CHANNEL SQUARE KERB (TYPE CS2: LAID FLUSH)
- EF** FLAT TOP EDGING KERB (TYPE EF: LAID FLUSH)
- TK** TRANSITION KERB (TYPE TK: UPSTAND KERB TO DROPPED KERB)
- DK** DROPPER KERB (TYPE DK: UPSTAND KERB TO DROPPED KERB)

- NOTES**
- All dimensions are to be checked on site before the commencement of works. Any discrepancies are to be reported to the Architect & Engineer for verification. Figured dimensions only are to be taken from this drawing.
 - The DWG file is issued for the purposes of coordination only and do not represent formal drawing issue and are not to be reprinted in any form. Formal issue of drawings is via DWG, Adobe PDF files and/or hard copies and their associated information issue sheets.
 - Note that all care has been taken with the export of DWG files and their content, but we recommend that you make due dimensional checks before using any DWG file information. Any errors found are to be reported to Hydrock immediately.
 - All levels are shown in metres above Ordnance Datum (m AOD).
 - In the event of any contradiction between this drawing and the specification, then the contractor shall seek clarification from the engineer before proceeding.
 - Refer to landscape architects drawings for extent of external surfaces and kerbing.
 - The works on site affect statutory undertakers apparatus, where the contractor is required to verify the location and depth of all such apparatus prior to commencement of work and to take any precautions necessary when working in the vicinity of apparatus.

REV	AS BUILT ISSUE	DATE	BY	CHECKED BY	DATE	APPROVED BY	DATE
C06	J.SHIMMIN	27.07.21	D.GALLIMORE	27.07.21	J.MAGEE	27.07.21	
C05	D.GALLIMORE	28/06/21	J.MAGEE	28/06/21	M.GRIFFIN	28/06/21	
C04	D.GALLIMORE	17/05/21	M.GRIFFIN	17/05/21	M.GRIFFIN	17/05/21	
C03	D.GALLIMORE	13/01/21	M.GRIFFIN	13/01/21	M.GRIFFIN	13/01/21	
C02	D.GALLIMORE	21/08/20	D.GALLIMORE	21/08/20	M.GRIFFIN	21/08/20	
C01	D.GALLIMORE	24/07/20	D.GALLIMORE	24/07/20	M.GRIFFIN	24/07/20	

REV	REVISION NOTES/COMMENTS	DATE	BY	CHECKED BY	DATE	APPROVED BY	DATE
-----	-------------------------	------	----	------------	------	-------------	------

Hydrock

Merchants' House North
Wapping Road
Bristol
BS1 4RW
t: +44 (0)117 945 9225
e: bristolcentral@hydrock.com

CLIENT		LANDLINK ESTATES	
PROJECT		SALTBOX BOGNOR REGIS	
TITLE		UNITS 4,5 AND 8 EXTERNAL WORKS	
HYDROCK PROJECT NO. C-13319-C		SCALE @ A1 1:250	
STATUS DESCRIPTION AS BUILT ISSUE		STATUS A	
DRAWING NO. (PROJECT CODE-ORIGINATOR-ZONE-LEVEL-TYPE-ROLE-NUMBER) SAL-HYD-PH2-ZZ-DR-C-7200		REVISION C06	