


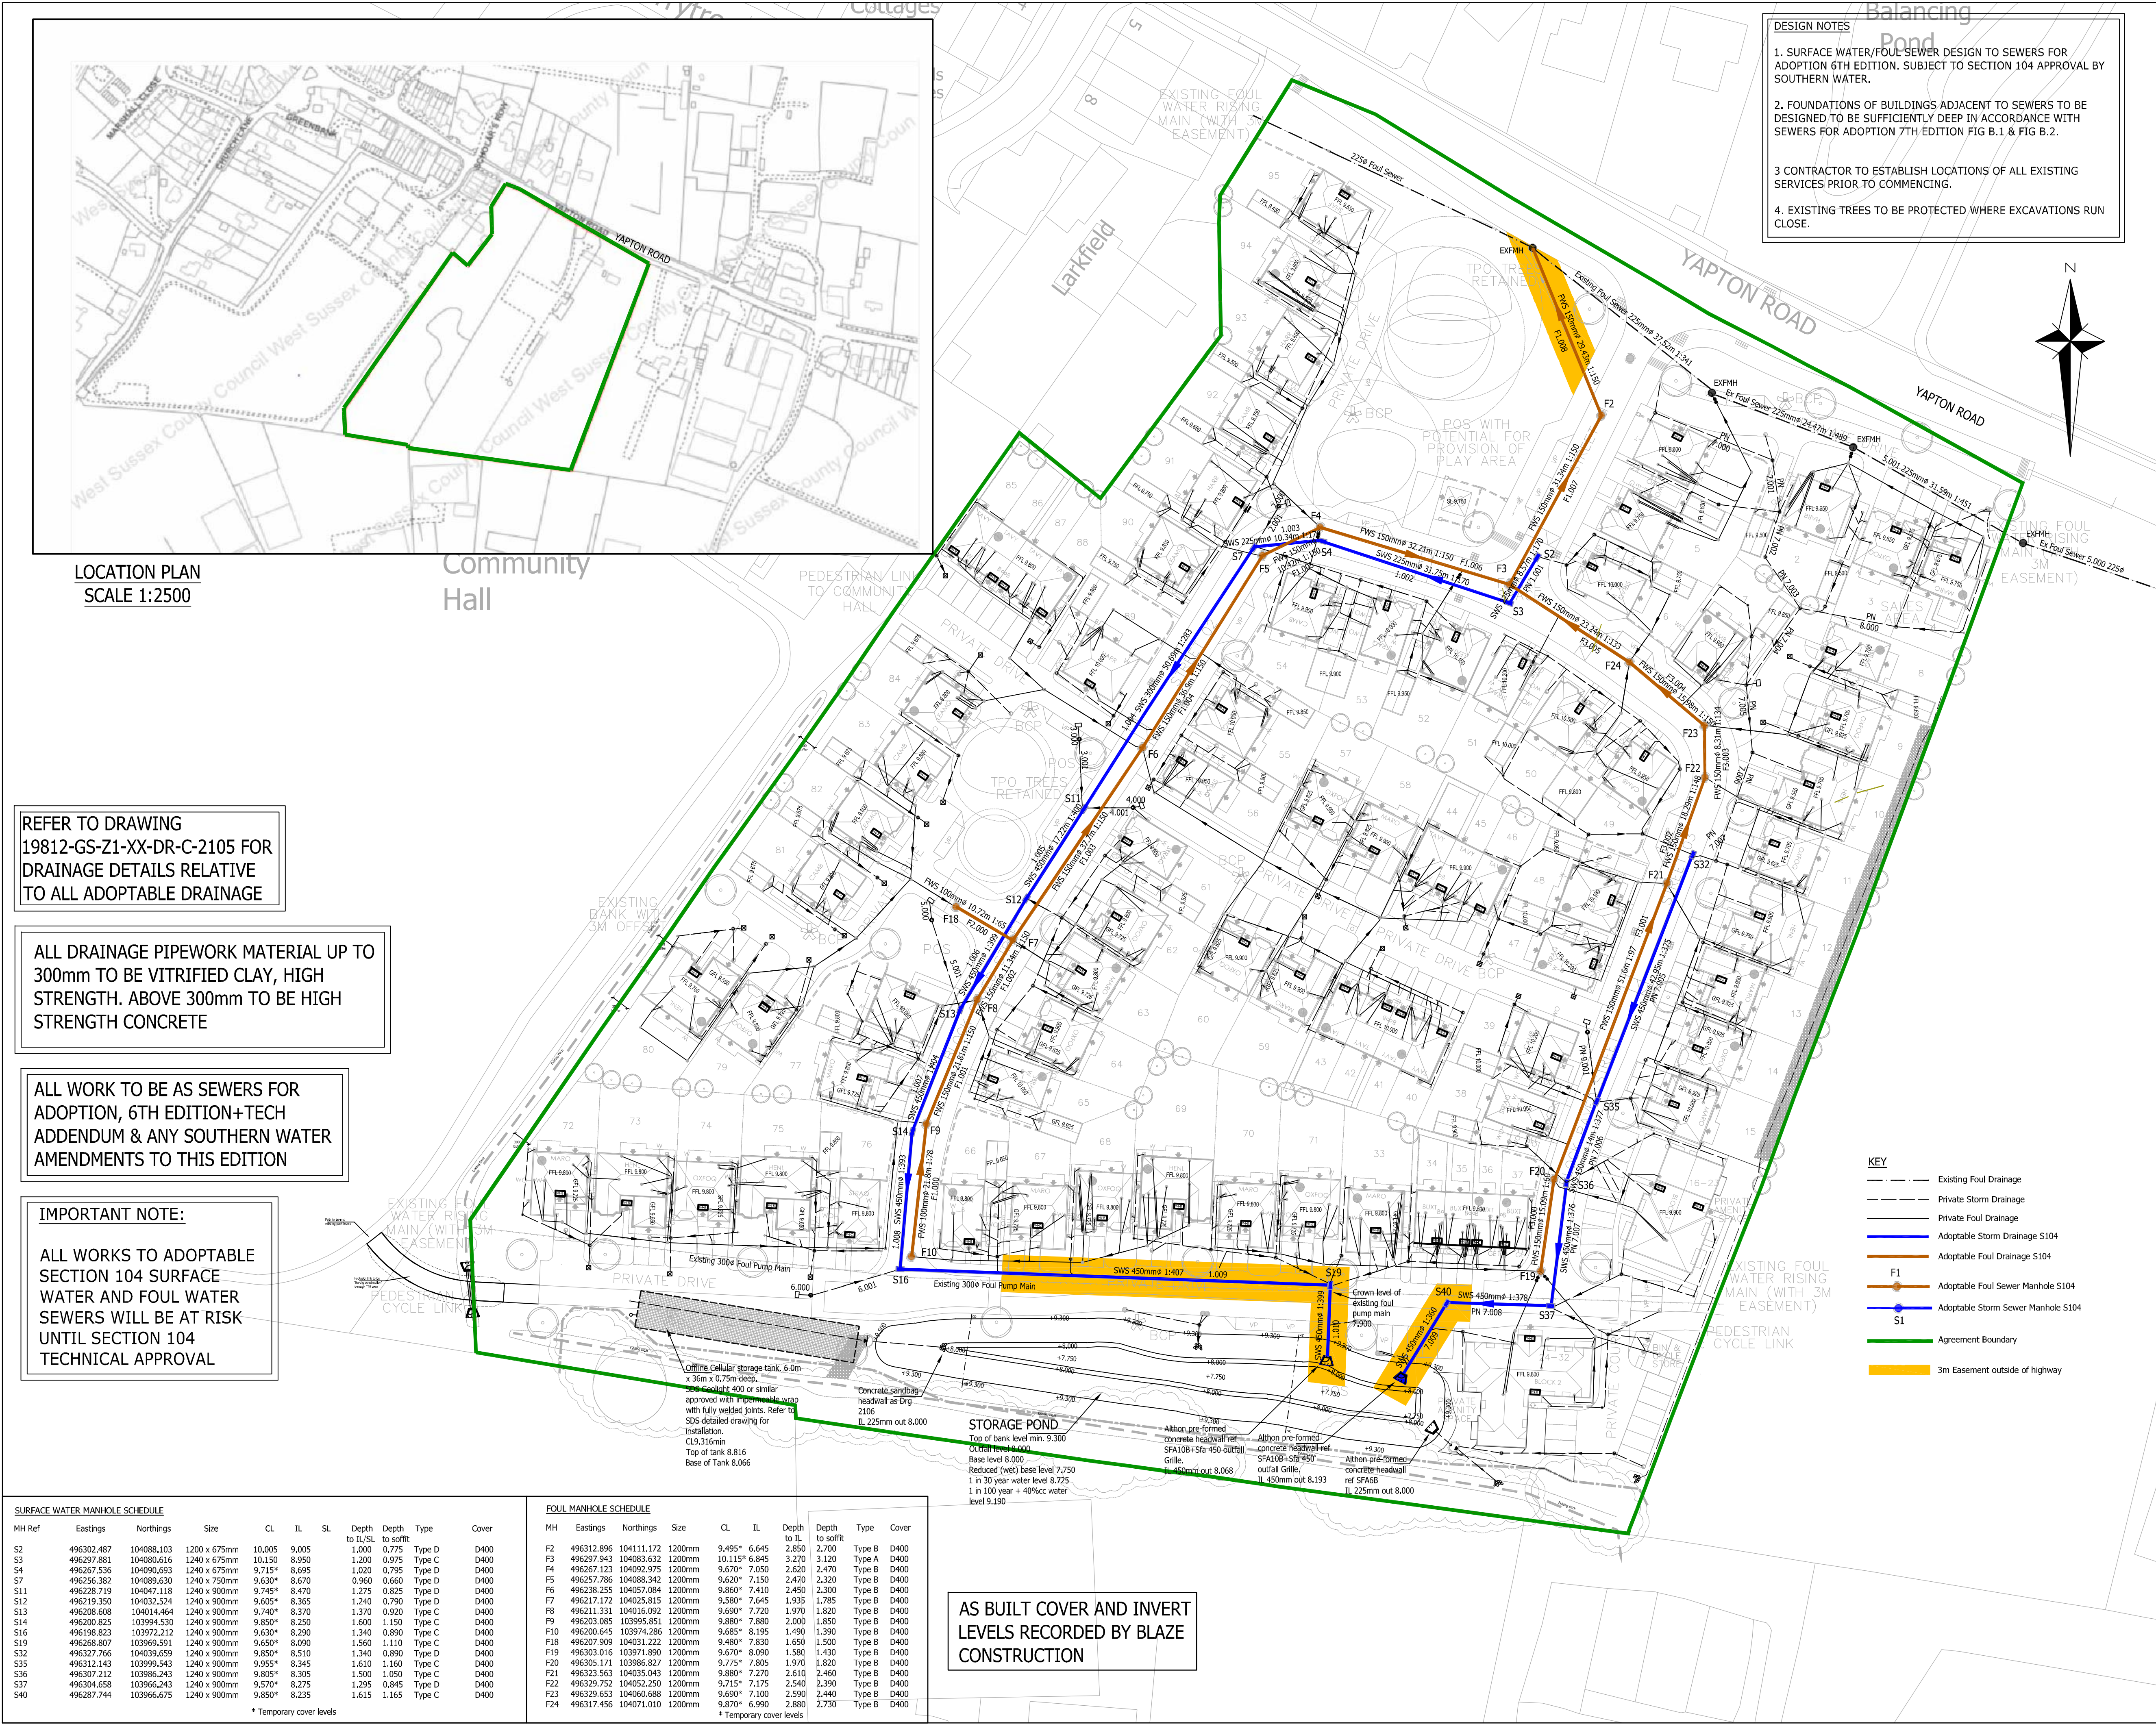

A1	AS BUILT ISSUE	25/01/22	KW	SDL
C4	Updated to GTA Title Block	09/12/21	NG	MR
C3	Revised to Southern Water comments	09/11/20	SDL	MR
C2	Revised to Southern Water comments	15/10/20	SDL	MR
C1	CONSTRUCTION ISSUE	17/09/20	MR	SDL
P4	Updated to Client comments	21.2.20	GS	SDL
P3	Revised to latest site layout	31.1.20	MR	SDL
P2	Revised to updated site layout	20/12/19	MR	SDL
P1	INITIAL ISSUE	06/11/18	MR	SDL
Rev	Amendments	Date	Don	Chk
Status AS BUILT				
Client	 REDROW			
Architect	RH PARTNERSHIP			
Project	ANGEL & HYDE NURSERIES YAPTON ROAD, BARNHAM			
Title	AS BUILT SECTION 104 LAYOUT			
Date	NOVEMBER 2019	Scale @ A1	1:500	
Clients Ref.	Project Ref.		7033	
 gta Civils & Transport Gloucester House, 66a Church Walk, Burgess Hill, West Sussex, RH15 9AS Tel 01444 871444 Web: www.gtacivils.co.uk				
Drawing Number			Rev.	
19812-GS-Z1-XX-DR-C-2020				A1