




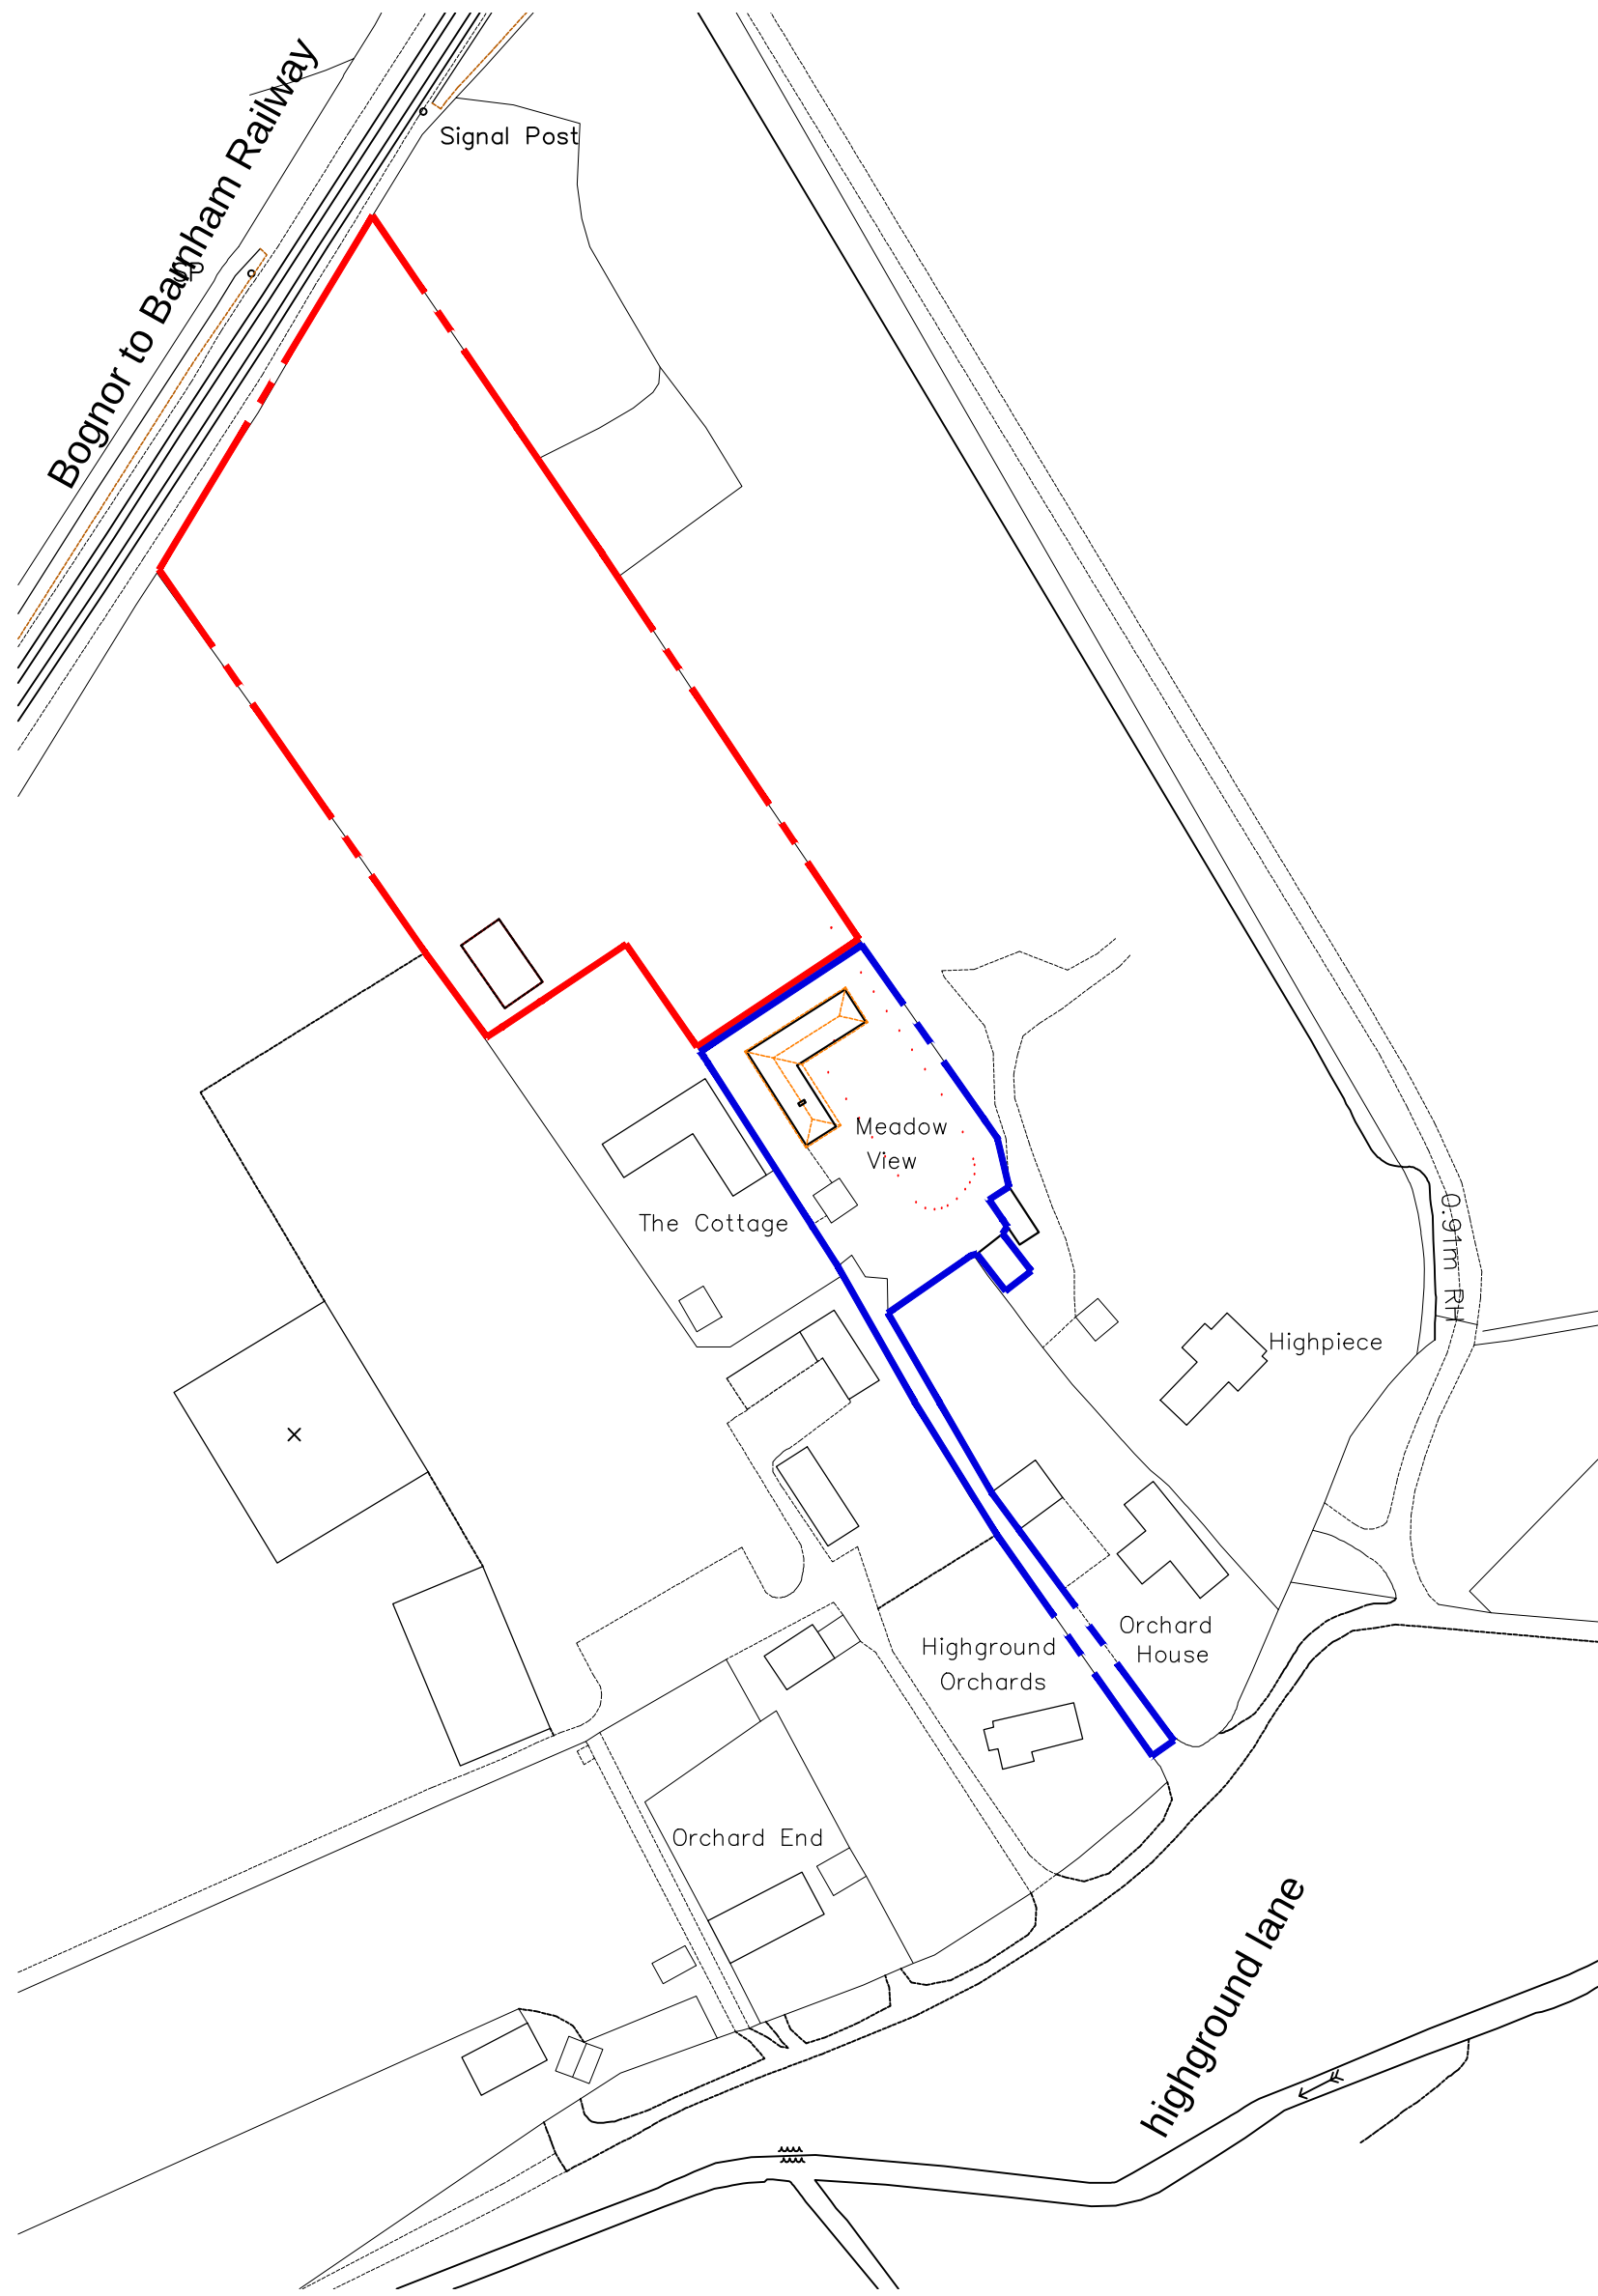


Site Location @ 1:1250
© Crown Copyright 2013.
All rights reserved. Licence number 100020449

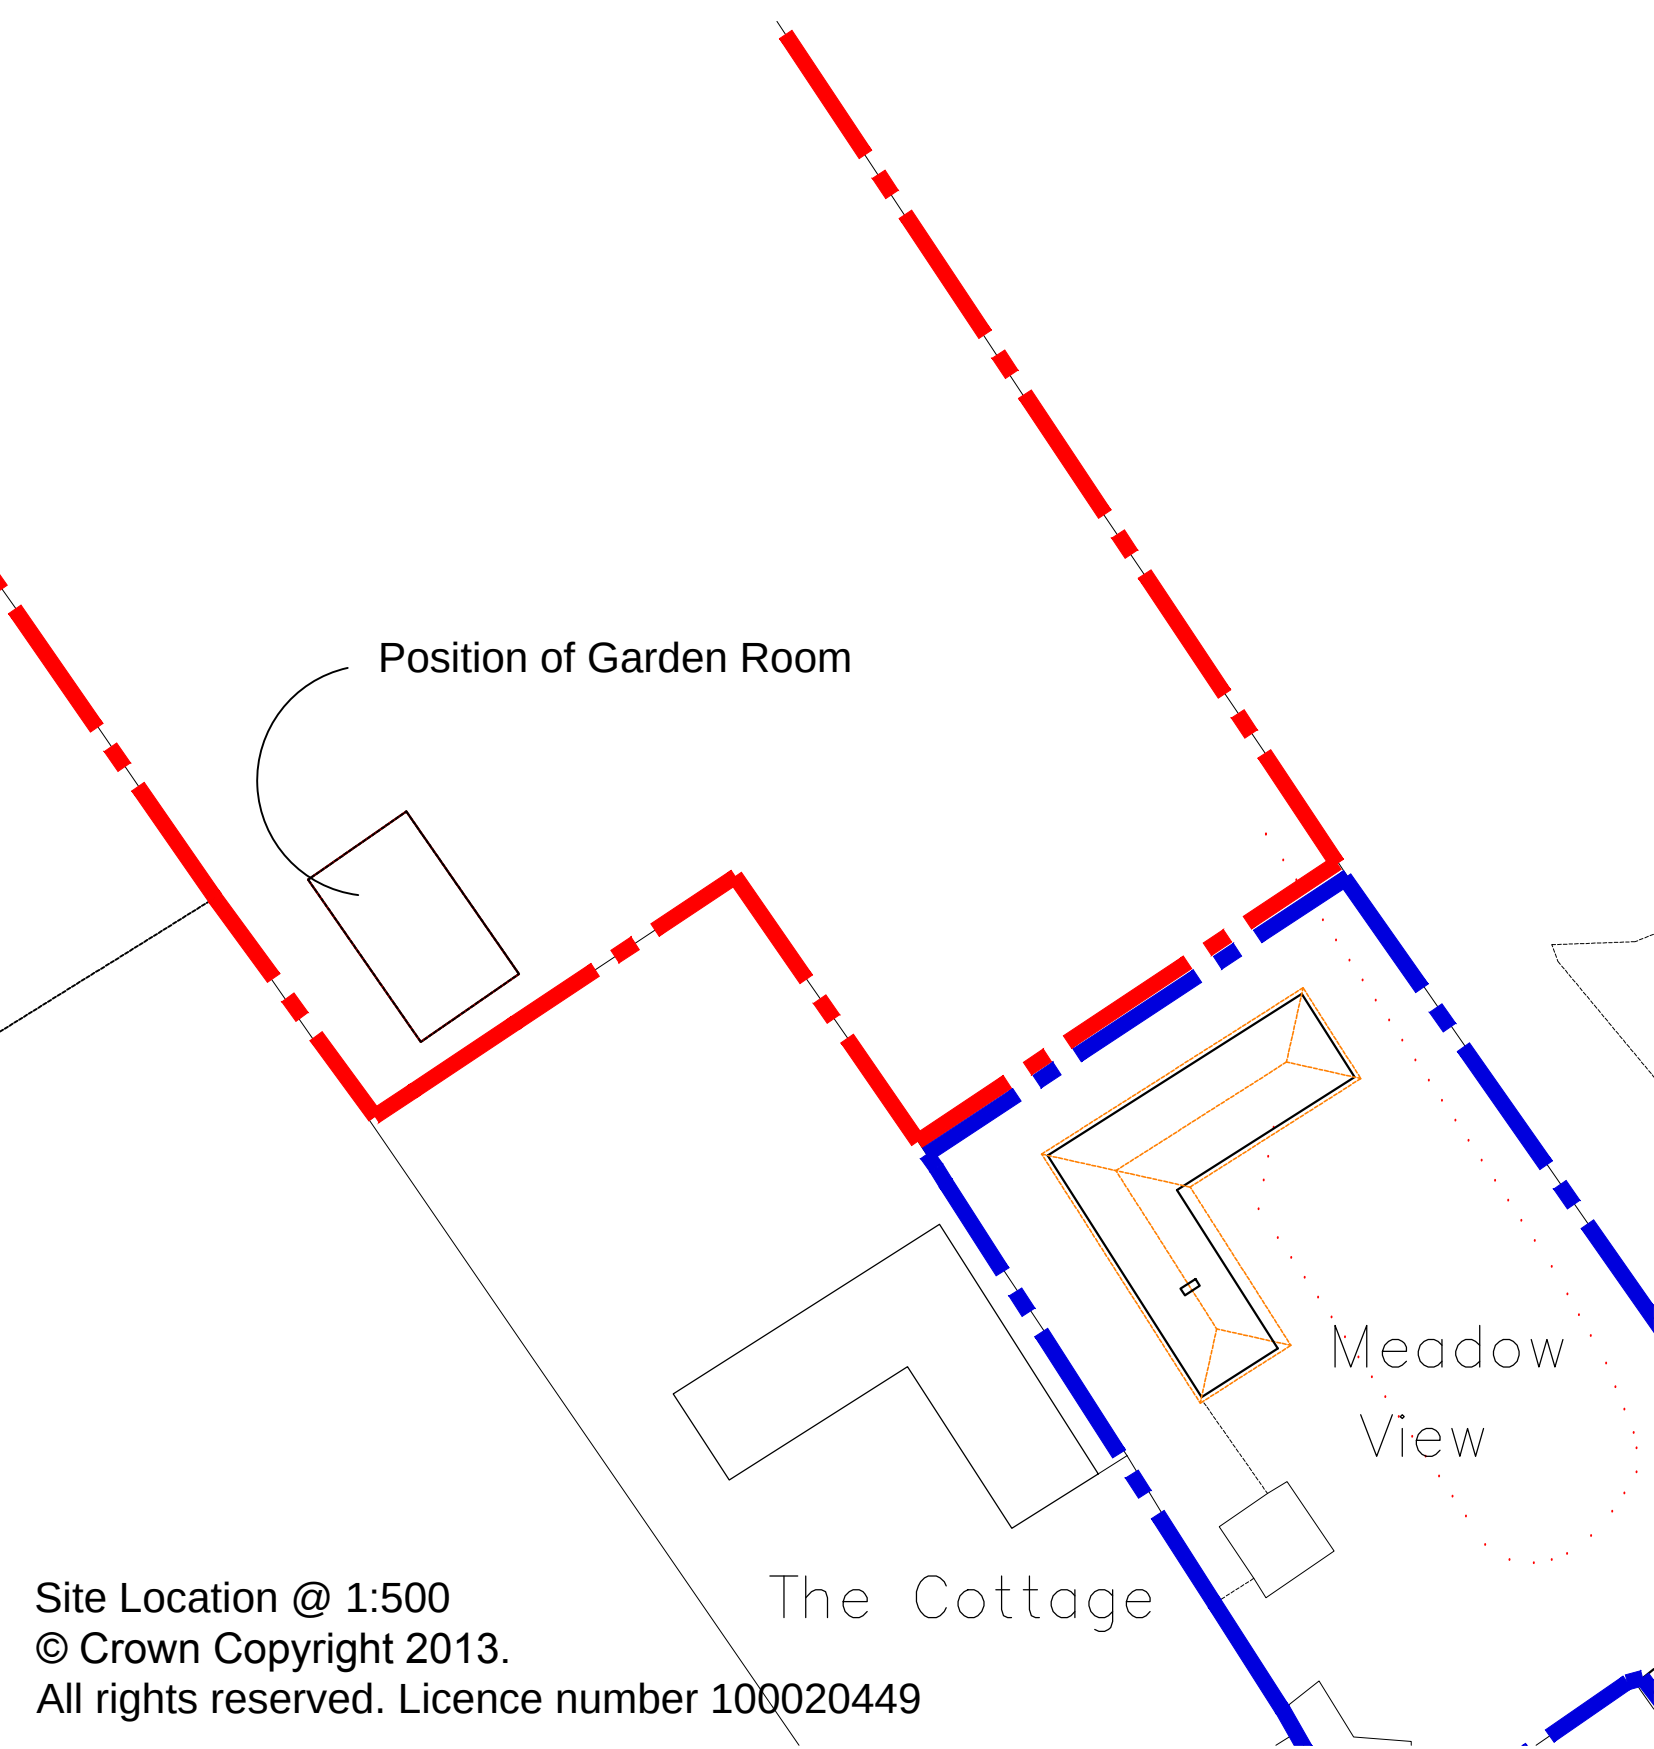


Site Location @ 1:500
© Crown Copyright 2013.
All rights reserved. Licence number 100020449

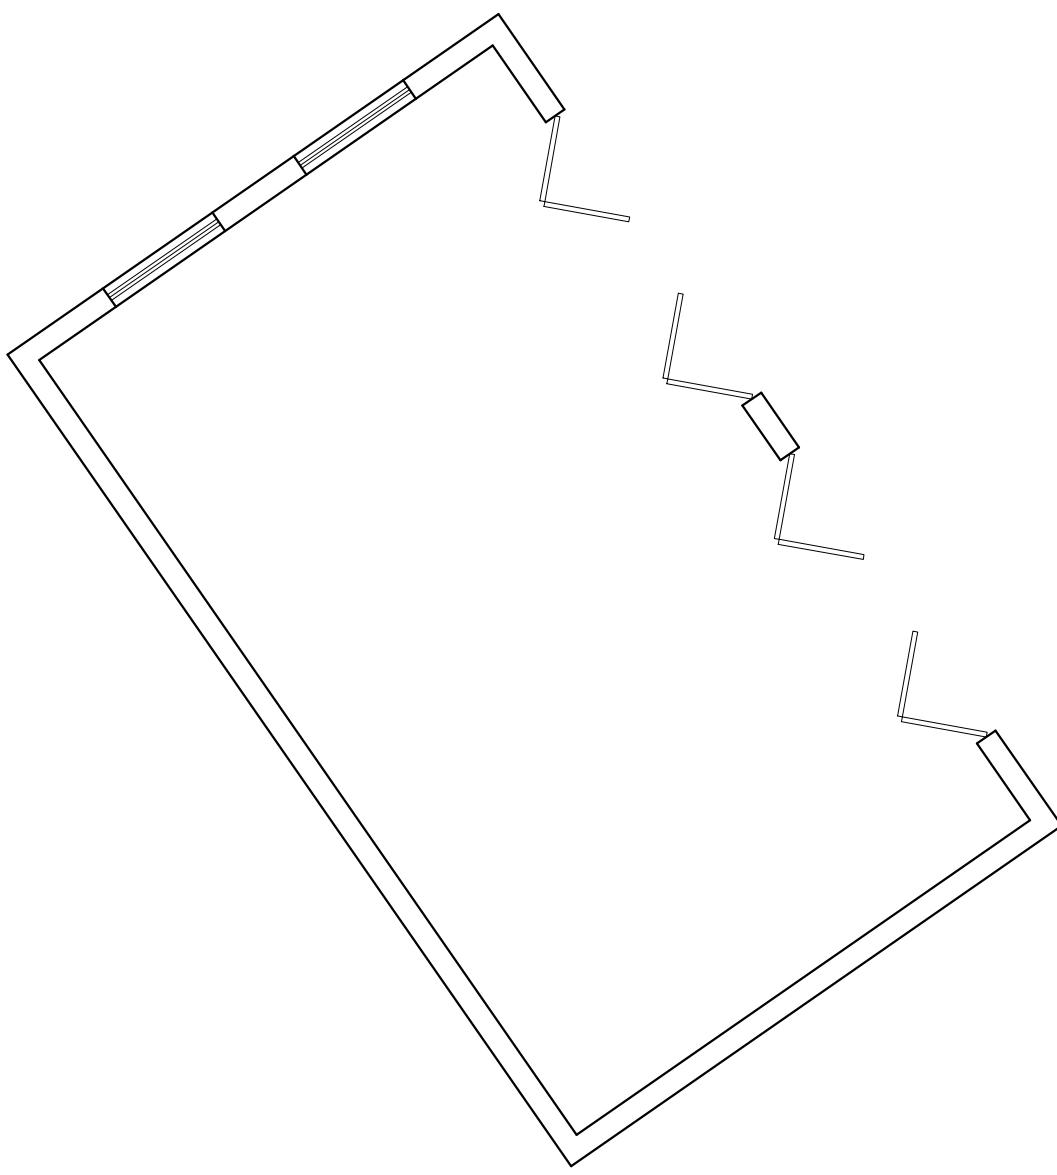


Floor Plan @ 1:100

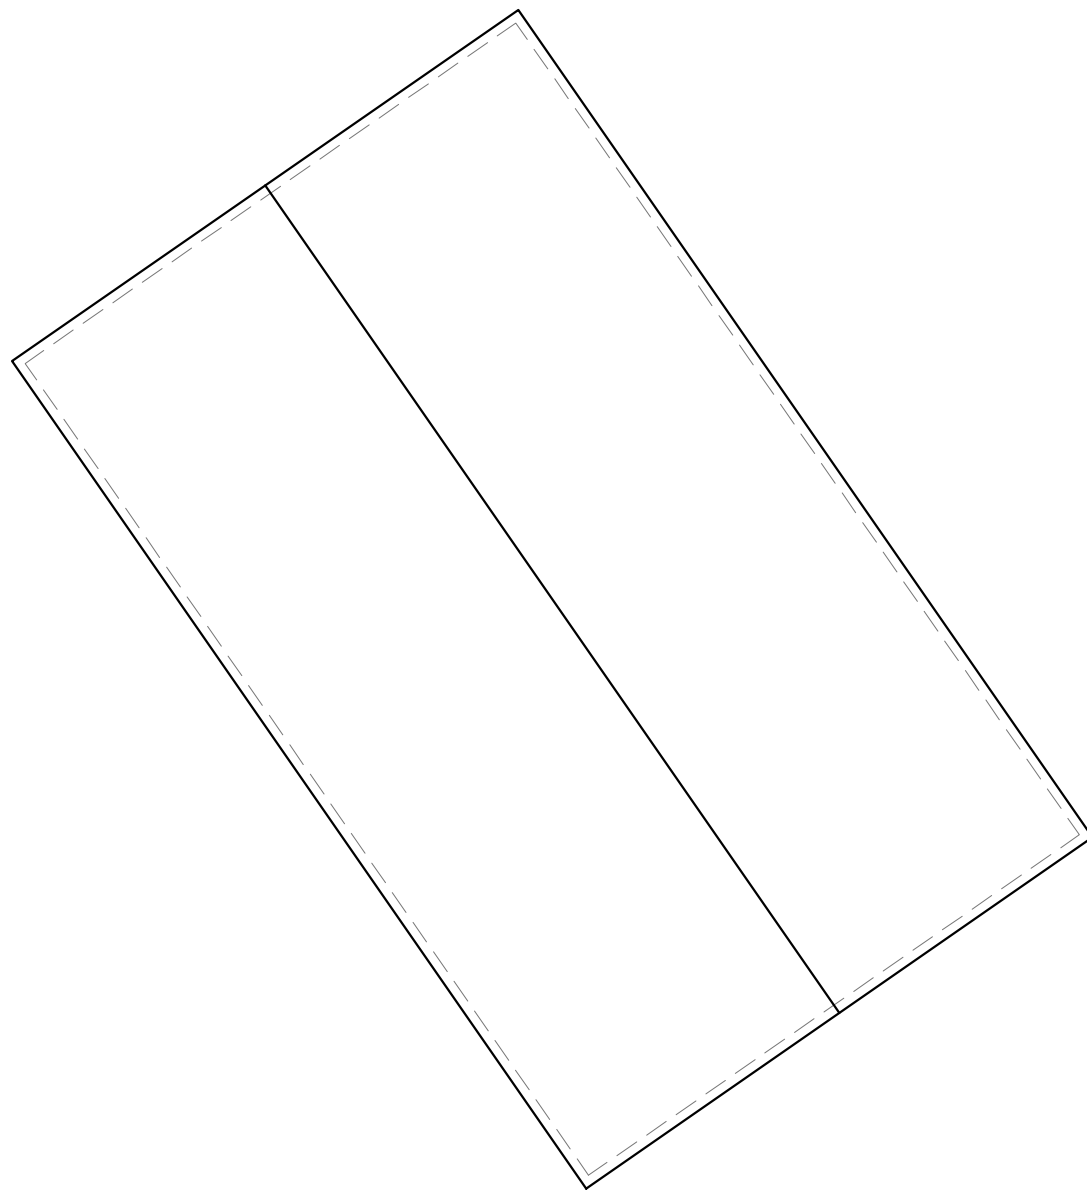


Roof Plan @ 1:100

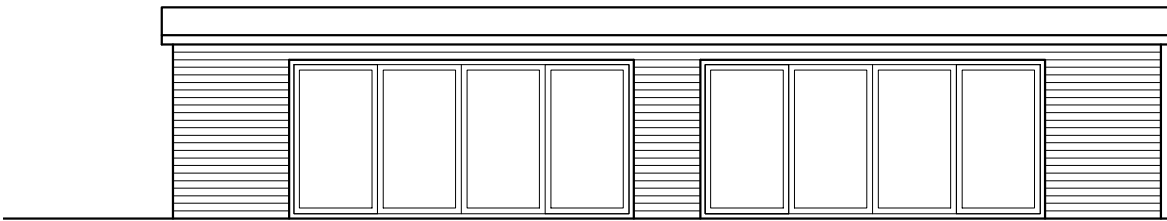


North East Elevation @ 1:100

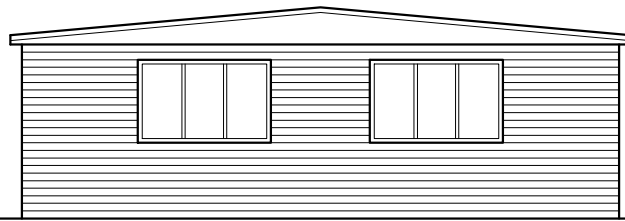

North West Elevation @ 1:100

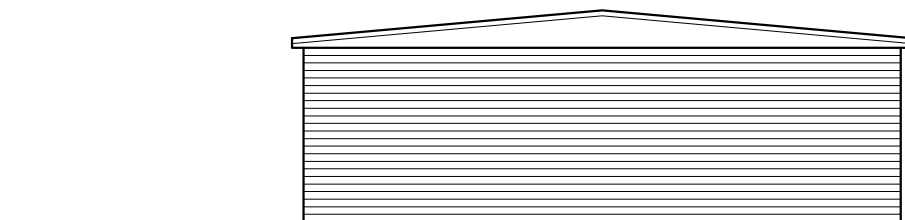

South East Elevation @ 1:100

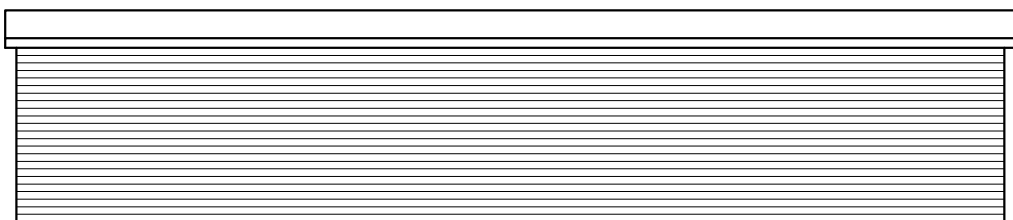

South West Elevation @ 1:100




Photograph 1 of Proposals in context.



Photograph 2 of Proposals in context.

NOTES:
Dimensions to be checked on site before commencing work. Any discrepancies shall be reported to the architect immediately.
Do not scale from these drawings except for planning purposes. Use figured dimensions only.
Where applicable this drawing is to be read in conjunction with other consultants' drawings.
All drawings to be read in conjunction with specification and all other drawings including structural engineer and mechanical and electrical drawings / specification

NOTE THIS HAS BEEN PRODUCED FROM CLIENT SUPPLIED INFORMATION. NO SURVEY OR ANY OTHER FORM OF INVESTIAGIVE WORKS/ DESIGN / SPECIFYING HAVE BEEN CARRIED OUT BY HELYER DAVIES LTD,

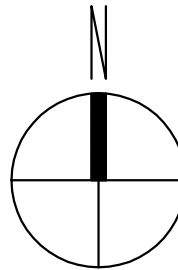

REV	DATE	AMENDMENT	DRAWN

hd
architects

Helyer Davies Architects Ltd
1 The Old Flour Mill,
Emsworth, PO10 7BT
01243 370 715
www.hdarchitects.co.uk mail@hdarchitects.co.uk

CLIENT
Mr Danny Keet.

PROJECT
Proposed Garden Room.
Meadow View
High Ground Lane
Barnham
West Sussex

DRAWING	SCALE
General Arrangement Proposed / As built	As Noted

DATE 10.06.13.	DRAWN MRH
DRAWING NUMBER 13079/001	REVISION