


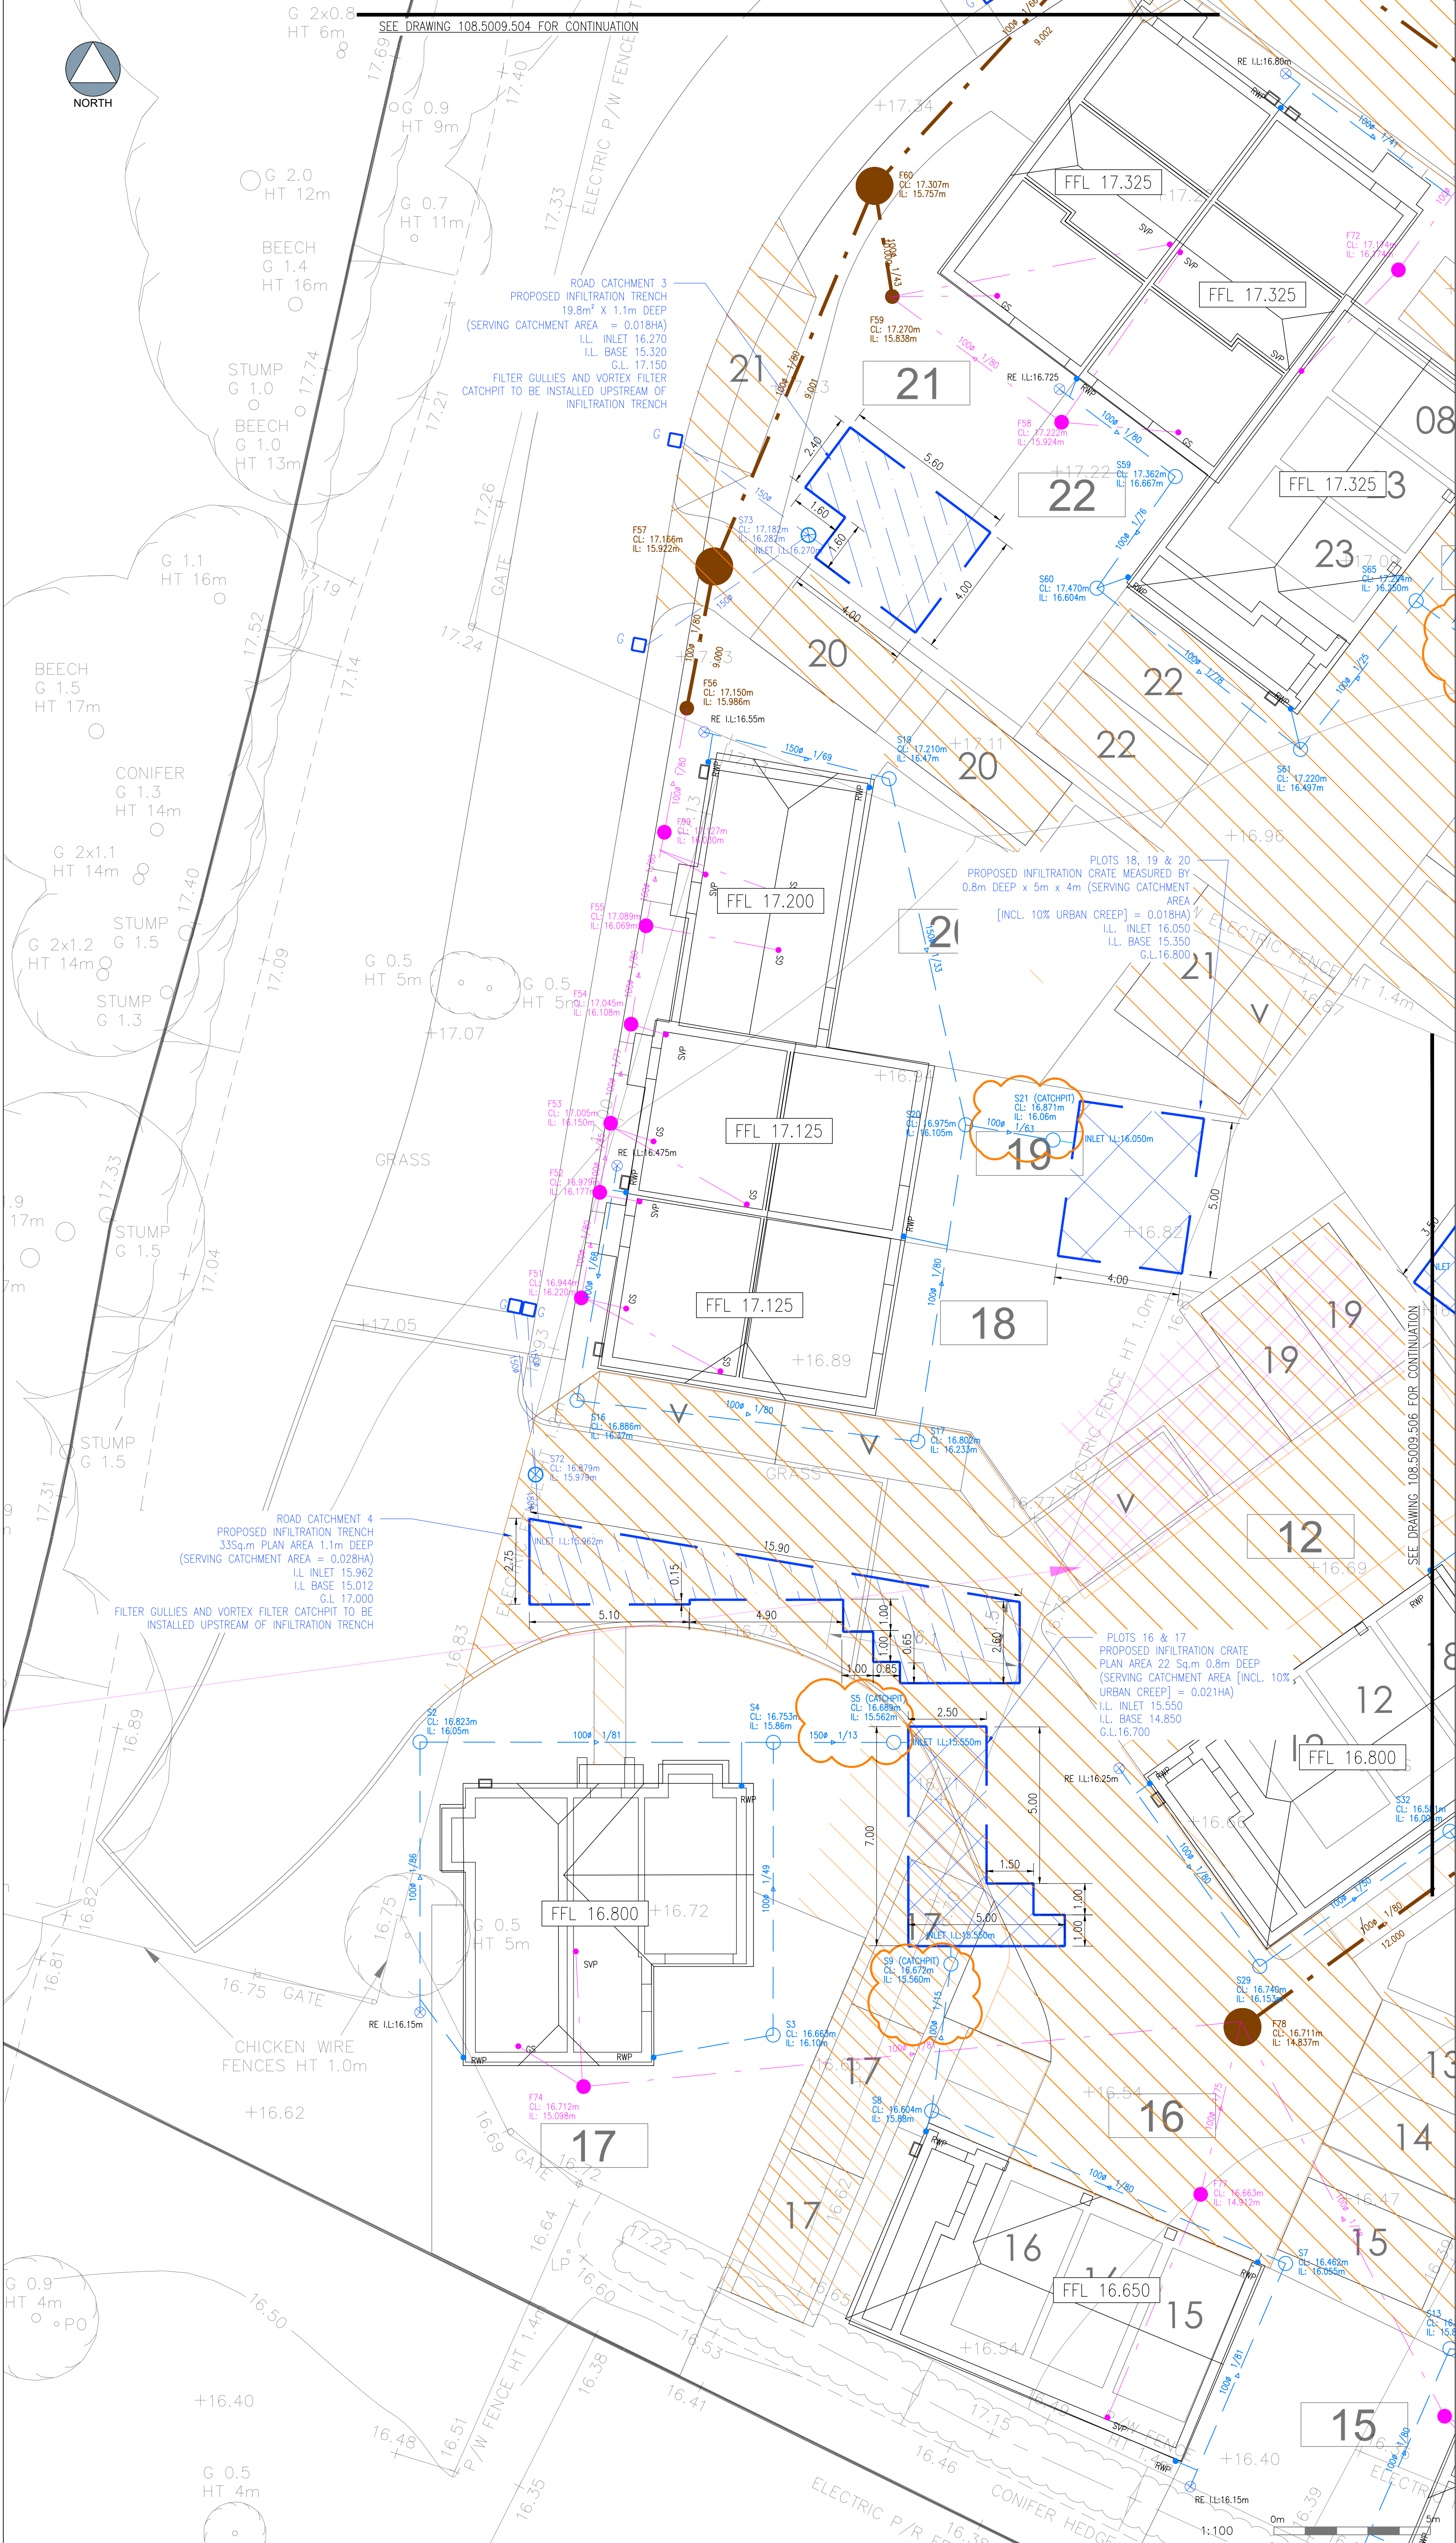


The drawings, information and data recorded in this document ("the information") is the property of Paul Basham Associates. This document and the information are solely for the use of the authorized recipient and this document may not be used, copied or reproduced in whole or part for any purposes other than which it was supplied by Paul Basham Associates. Paul Basham Associates makes no representation, undertakes no duty and accepts no responsibilities to any third party who may use or rely upon this document or the information.

GENERAL NOTES

- THIS DRAWING IS INTENDED TO BE VIEWED IN COMBINATION WITH ALL RELEVANT ARCHITECTS, ENGINEERS, SERVICES AND SPECIALIST DRAWINGS AND SPECIFICATION.
- ANY VARIATIONS OR DISCREPANCIES BETWEEN THESE DRAWINGS IN TERMS OF DIMENSIONS OR DETAILS SHOULD BE DRAWN TO THE ATTENTION OF THE ARCHITECT AND/OR THE ENGINEER FOR CLARIFICATION.
- PAUL BASHAM ASSOCIATES ACCEPTS NO RESPONSIBILITY FOR THE ACCURACY OF BACKGROUND INFORMATION PRODUCED BY THIRD PARTIES - THIS MUST BE TREATED AS INDICATIVE ONLY.
- ALL DIMENSIONS AND LEVELS ARE IN METRES. DO NOT SCALE THIS DRAWING, PRINT, PLOT OR DISK.
- THIS DRAWING SHOULD ONLY BE USED FOR CONSTRUCTION IF THE PROJECT PHASE IN THE TITLE FRAME BELOW IS SHOWN AS "CONSTRUCTION". PAUL BASHAM ASSOCIATES TAKE NO RESPONSIBILITY FOR CONSTRUCTION WORKS UNDERTAKEN TO DRAWINGS WHICH ARE NOT MARKED UNDER THIS PHASE.

LEGEND

- EXISTING FOUL SEWER TO BE ABANDONED
- EXISTING FOUL SEWER TO REMAIN
- PRIVATE FOUL WATER SEWER, Ø AS NOTED
- FOUL WATER SEWER, Ø AS NOTED
- PRIVATE STORM WATER SEWER, Ø AS NOTED
- ADOPTABLE FOUL WATER MANHOLE (CL/L AS SHOWN)
- PRIVATE FOUL WATER CHAMBER (L AS SHOWN)
- PRIVATE SURFACE WATER INSPECTION CHAMBER (L AS SHOWN)
- PRIVATE SURFACE WATER CATCHPIT (L AS SHOWN)
- ROAD GULLY WITH 150mmØ OUTLET PIPE
- VORTEX FILTER CATCHPIT, RIDGISTORMS[®] Separate Advanced Silt Trap or Similar. (PRODUCT CODE:FSMST160/15)
- RODDING EYE (L AS SHOWN)
- RAINWATER PIPE.
- SOIL AND VENT PIPE
- GROUND SOCKET CONNECTED TO IC OR AC.
- SUB STACK WITH AAV
- FOUL WATER PLOT CONNECTION PIPE 100Ø U.N.O
- SURFACE WATER PLOT CONNECTION PIPE 100Ø U.N.O
- INFILTRATION CRATES (SEE 108.5009.501 FOR FULL DETAILS)
- GRAVEL INFILTRATION TRENCH (SEE 108.5009.501 FOR FULL DETAILS)
- PROPOSED 6m SOUTHERN WATER MAINTENANCE EASEMENT
- PERMEABLE BLOCK PAVING 80 THK. AQUAFLOW CONCRETE BLOCKS (OR SIMILAR) ON, 50 THK. 2-6mm CLEAN CRUSHED STONE ON, 80 THK. DENSE BASE COURSE ASPHALT OVER CLEAN CRUSHED STONE ON, 150 THK. SUBBASE TYPE 3 (30% VOIDS) ON, 350 THK. PERMEABLE CAPPING LAYER TO CONSIST OF CRUSHED STONE 10-63mm
- REVISION 15.09.21

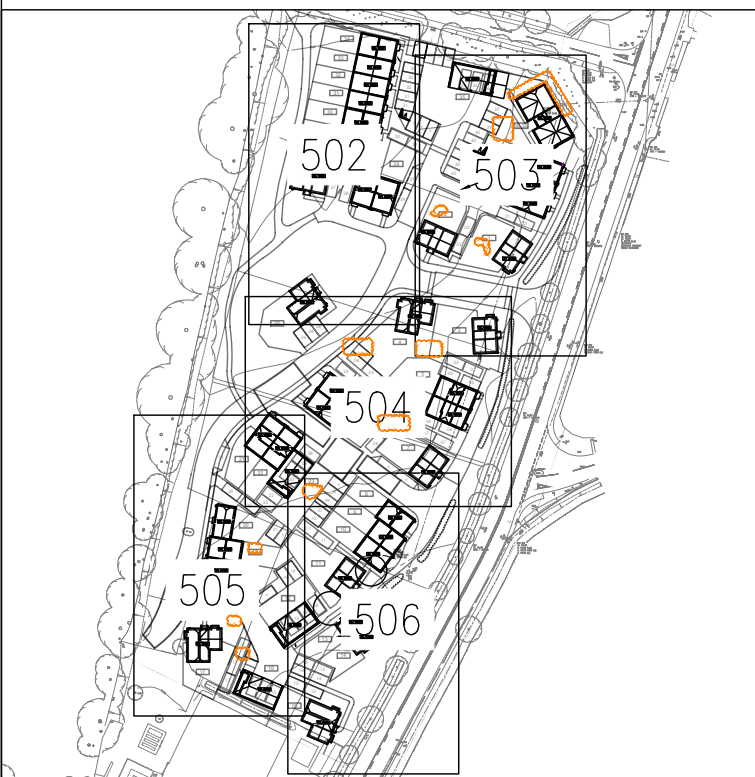

KEY PLAN SCALE 1:2000

FOR APPROVAL

D	UPDATED AS PER ADC COMMENTS	15.09.21	RD	RW
C	DRAWING STATUS UPDATED TO FOR CONSTRUCTION	31.08.21	RD	RW
B	REFINEMENTS MADE TO DRAINAGE SYSTEM	19.08.21	CLP	RW
A	REFINEMENTS MADE TO DRAINAGE SYSTEM	09.07.21	RD	RW
Rev	Description	Date	By	Chkd

Paul Basham Associates Ltd
The Belfry, Cornhill Estate, Farnham, PO16 8UT
01252711000
info@paulbashamassociates.com www.paulbashamassociates.com

HAMPSHIRE HOMES

Client

Project Name
FONTWELL AVENUE
EASTERGATE

Project Phase
CONSTRUCTION

Checked By RW	Checked Date 07.05.21	Drawn By RD	Drawn Date 07.05.21
------------------	--------------------------	----------------	------------------------

Client Drawing No. -	Scale 1:100	(AT A1 SIZE)
-------------------------	----------------	--------------

PBA Drawing No. 108.5009.505	Revision D
---------------------------------	---------------