




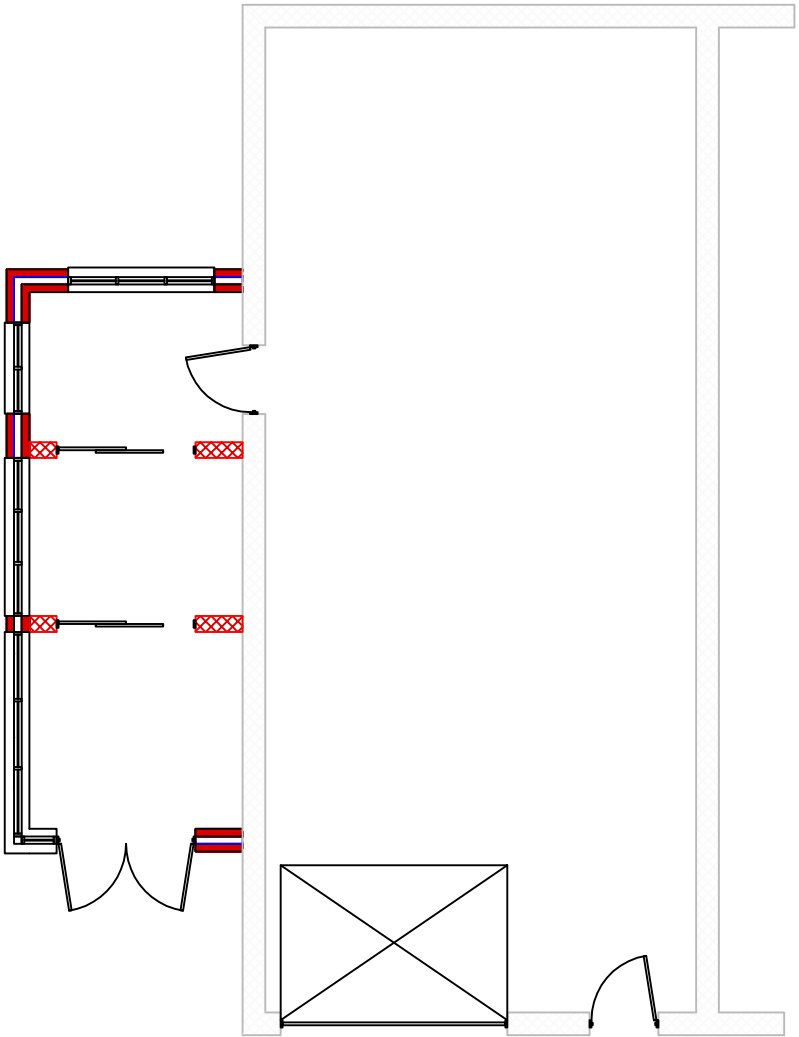


FLOOR PLAN

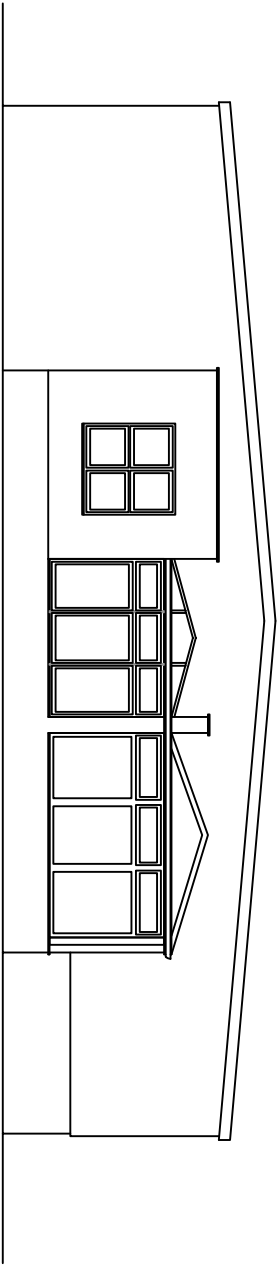

SOUTH ELEVATION

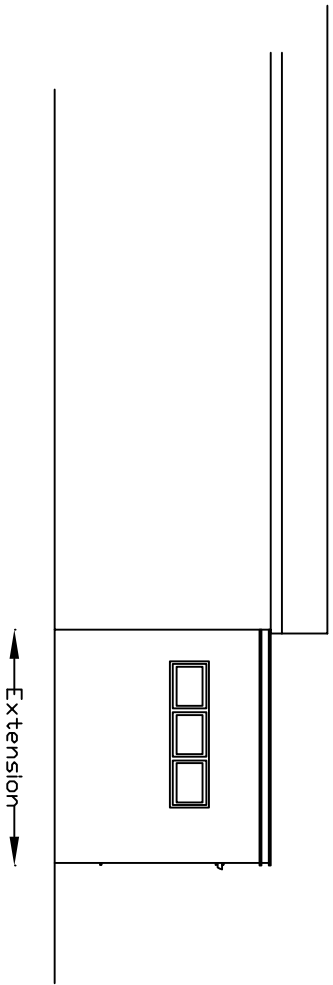

WEST ELEVATION

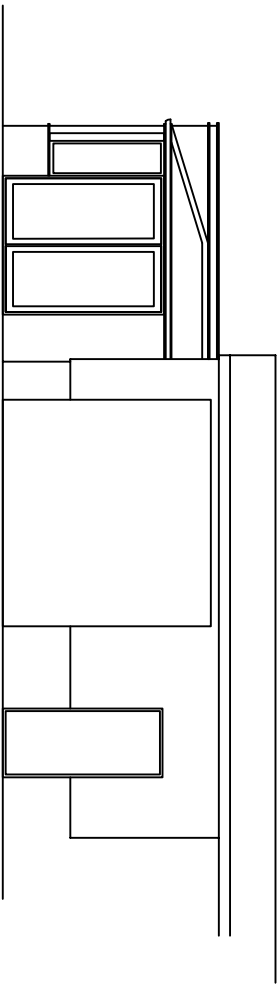

EAST ELEVATION

Drawing 4 – Unit S6
As Built Floor Plan and Elevations
Scale 1:100 @ A3