


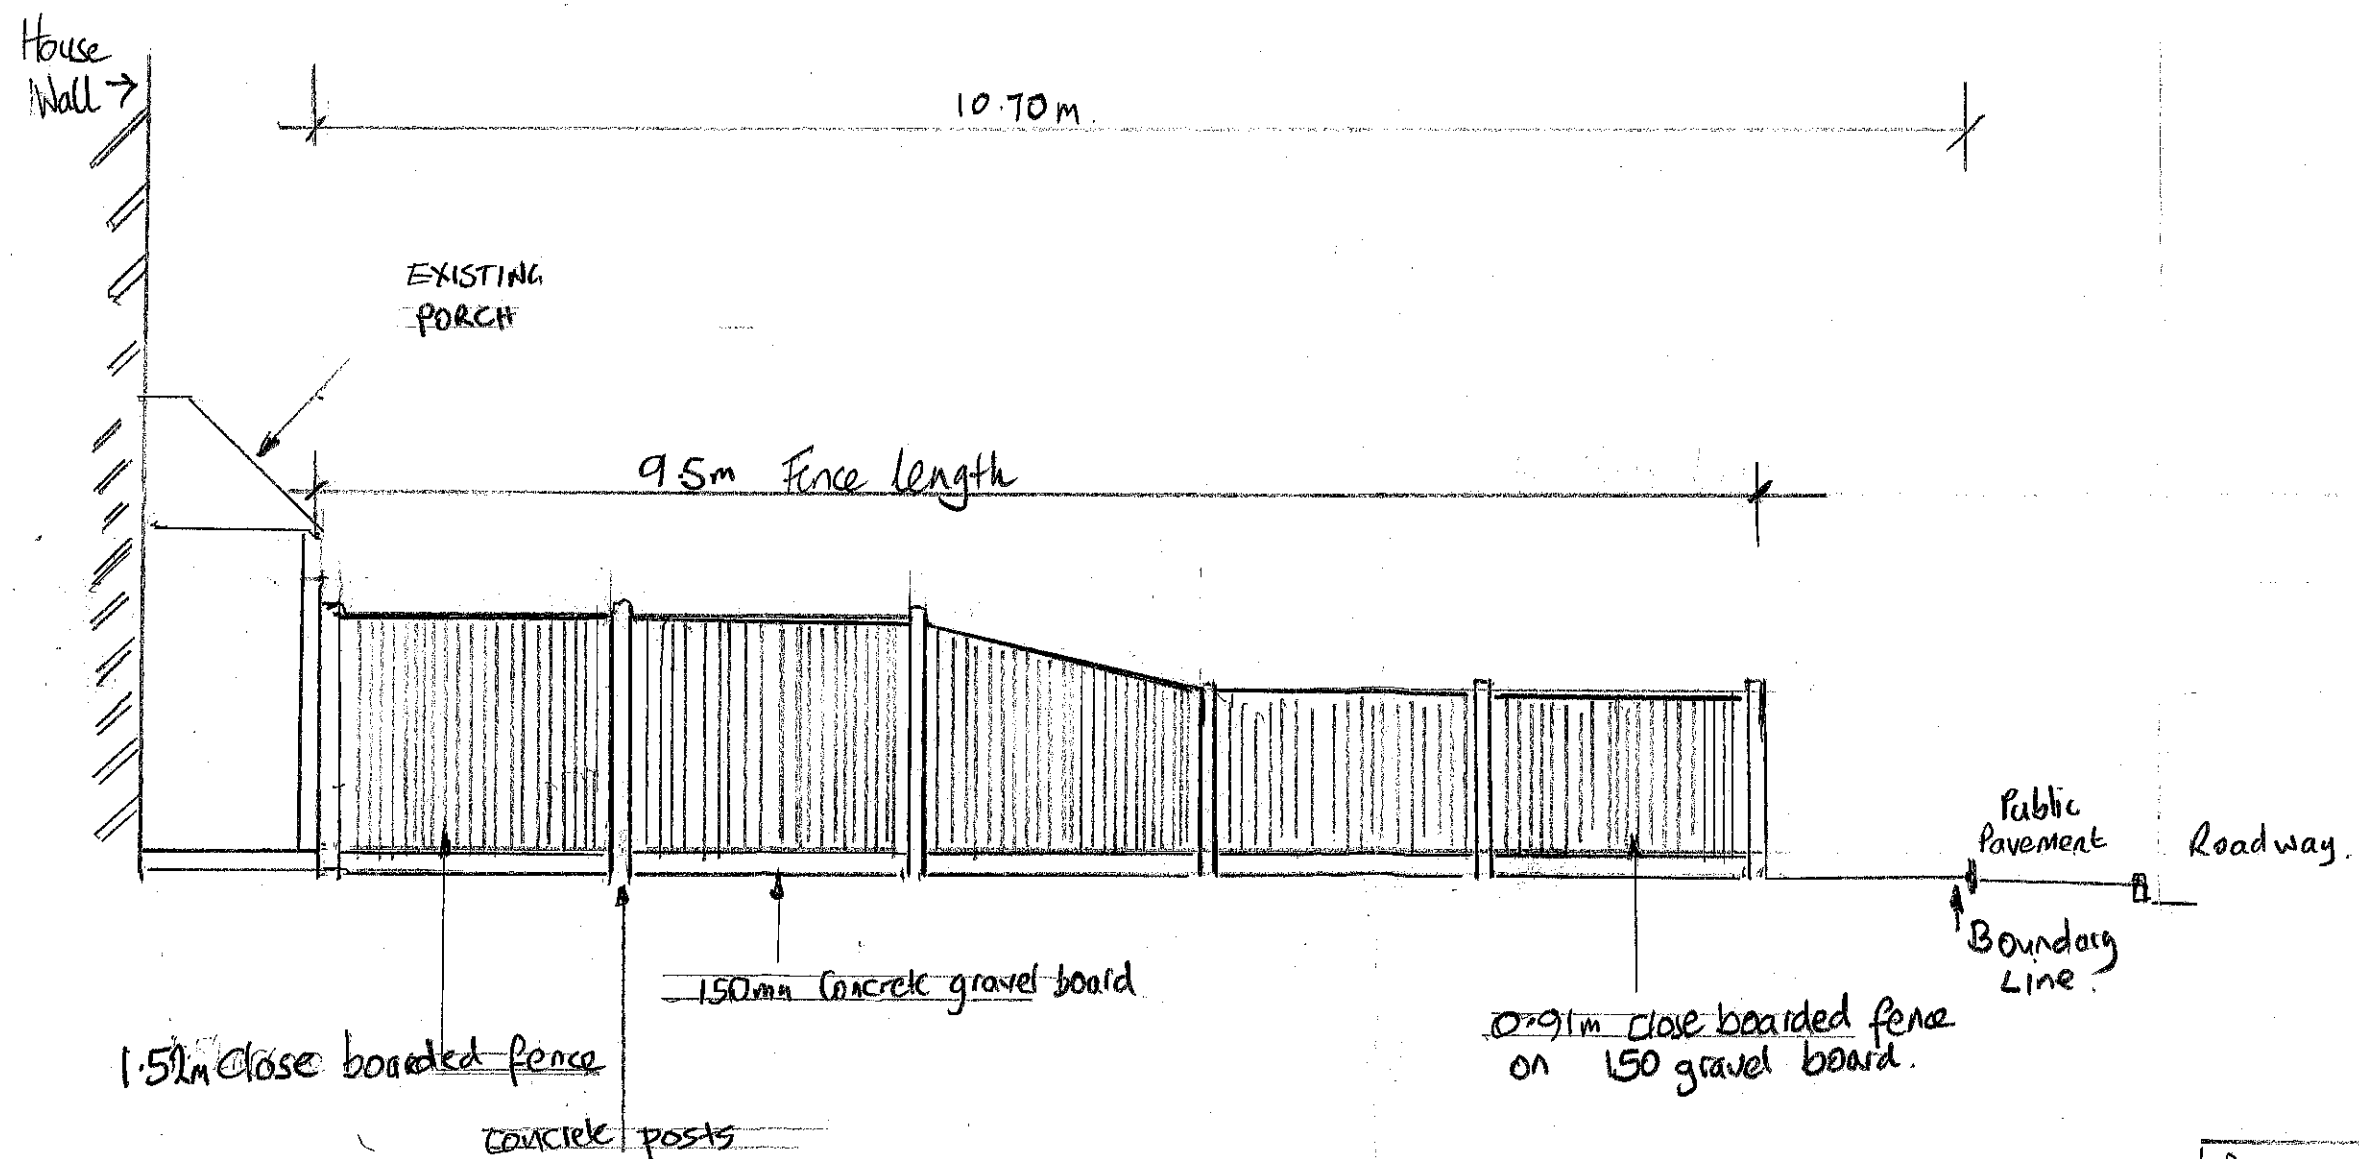

PROPOSED FENCE ELEVATION	REV A
38 HEDGE END BARNHAM	
CLIENT: MR & MRS BAGNELL	
SCALE 1:50 @ A3	
DRAWING N° PDW 1 HE	
REV B. Marked up fence length.	