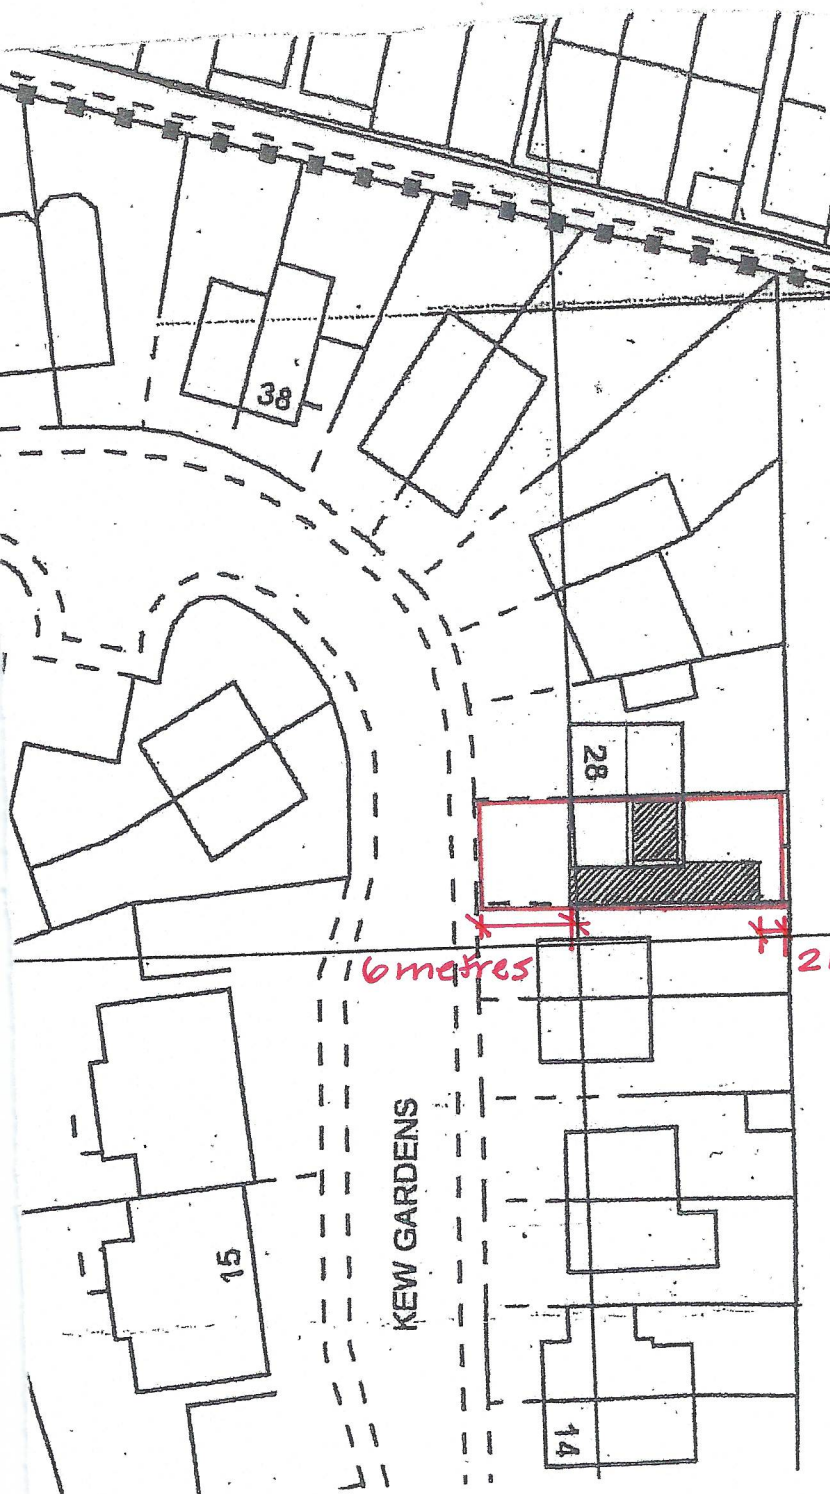


BLOCK PLAN 1/500

Application site shown in red edging and
proposed extensions shown shaded

This drawing is the copyright of the Architect and must not be reproduced or used without the Architect's permission. Figured dimensions are to take precedence over scaled dimensions. The Contractor is responsible for checking all figured dimensions on drawings against actual site dimensions. Scaled dimensions are not to be used for construction and setting out purposes. Any discrepancies are to be reported to the Architect. This drawing should be read in conjunction with schedules, specifications and engineers drawings and details where applicable.

DAVID BENNETT ARCHITECT
THE OLD COTTAGE, 10 VICARAGE LANE
FELPHAM, WEST SUSSEX PO22 7EA
07932 757144
Email: davidkbennett47@gmail.com

CLIENT

MR AND MRS COURCIER

PROJECT

**PROPOSED ALTERATIONS SINGLE STOREY
AND LOFT EXTENSIONS
26 KEW GARDENS PO21 5RD**

DRAWING TITLE

LOCATION PLAN AND BLOCK PLAN

SCALE

1/1250 and 1/500 at A3

REFERENCE

11806.01