

Notes:

----- DOTTED LINES, SHOWN IN RED, TO BE REMOVED

SSE ©

3rd floor the Pinnacle
Central Court Station Way
Crawley, West Sussex
RH10 1JH

t: 01323 325354
t: 01932 506111
e:office@sussexstructuralengineers.co.uk

NOTES:
This drawing is to be read in conjunction with
all relevant Architects and Engineers drawings
Only figured dimensions are to be used for
construction
All dimensions are to be verified on site prior
to work commencing


No.	Description	Date

Client: Vlad Novak

Address: Picturedrome
Cinema, 51 Canada
Grove, Bognor Regis,
PO21 1DW

Project: Proposed Alterations

Drawing title:	Proposed Plans
Project No	SSE_167
Date	12-07-19
Drawn by	IA
Drawing No	P02
Scale	1:100@A3

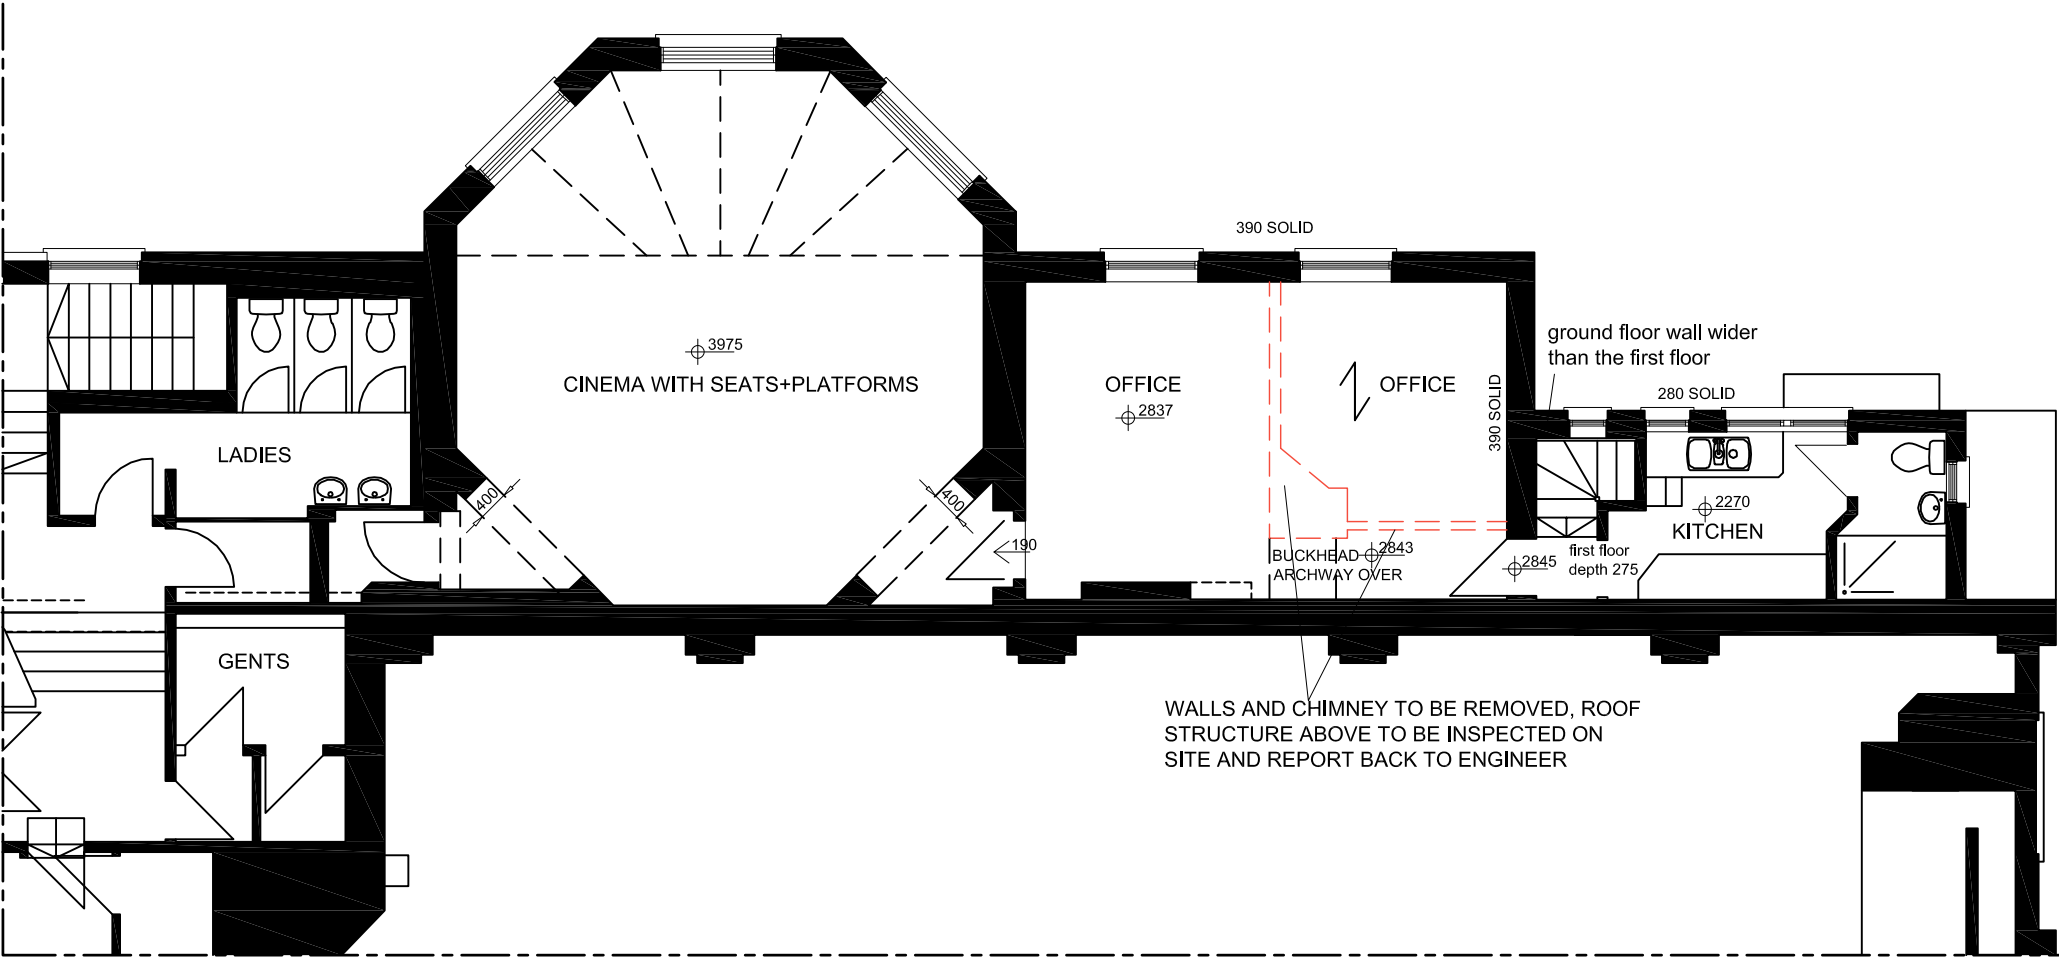

PART OF FIRST FLOOR PLAN

