


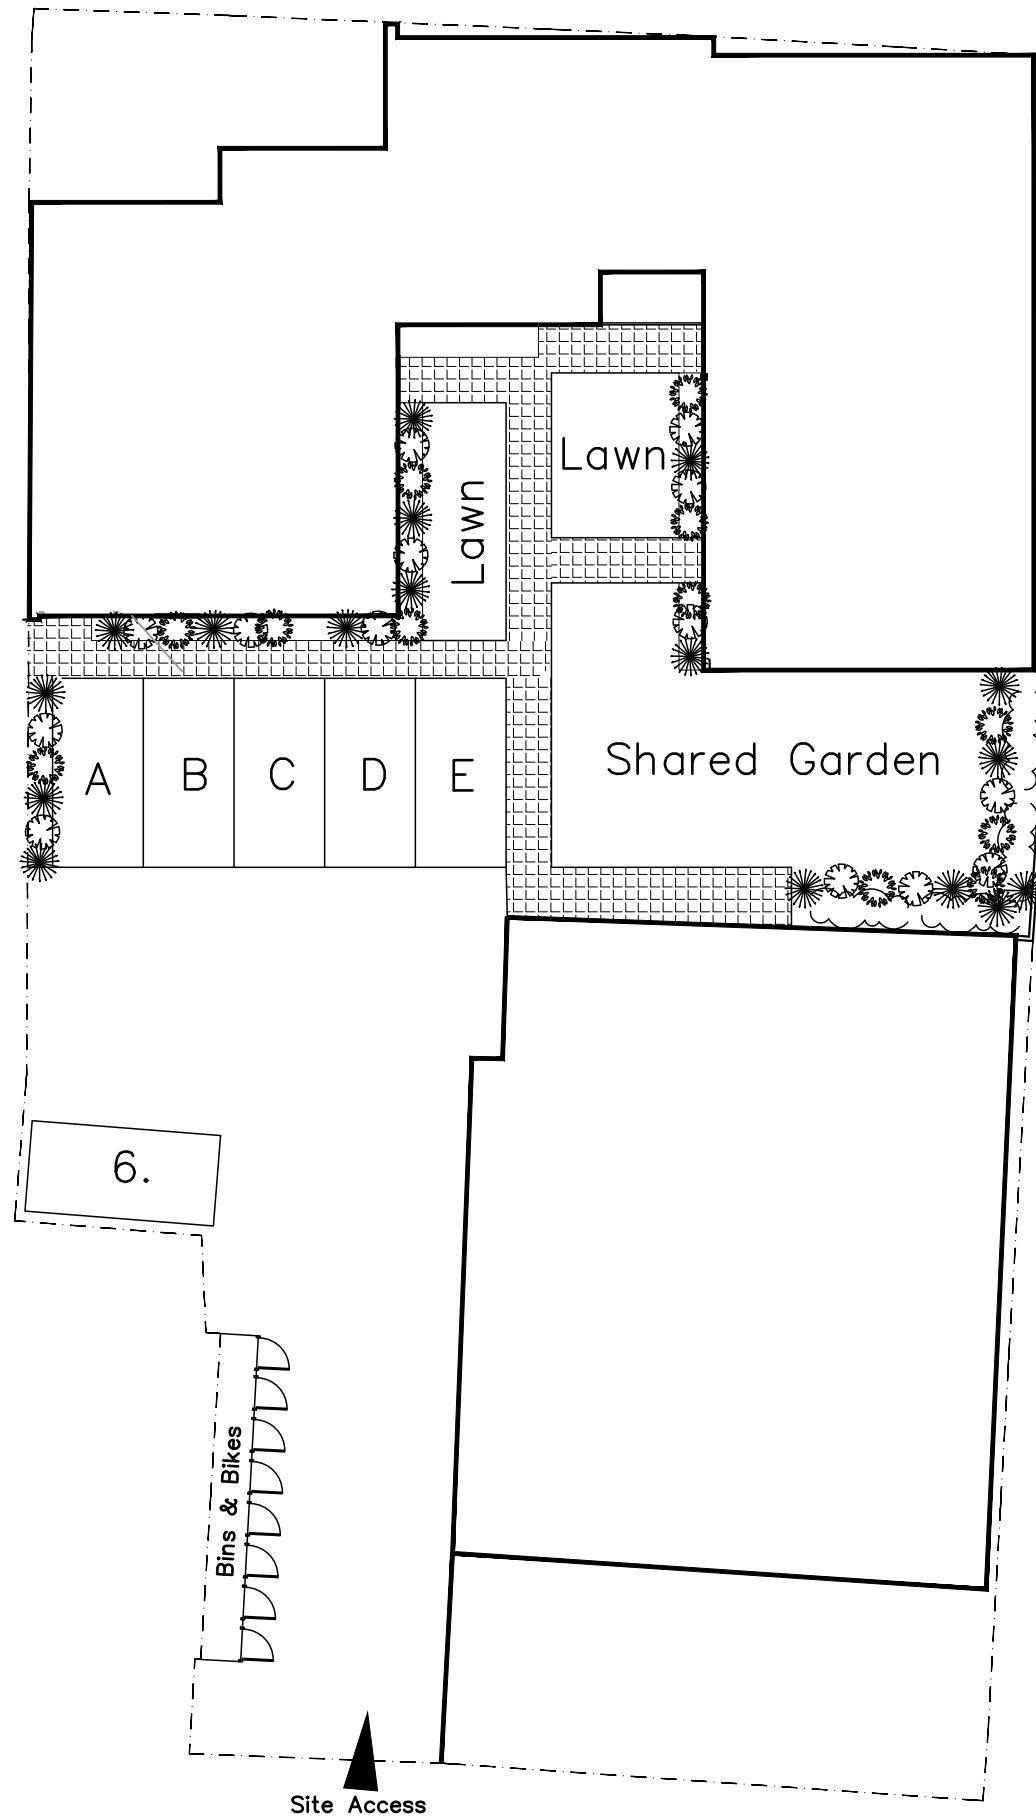

Land Rear,  
66 Hawthorn Road,  
Bognor Regis,  
PO21 2DD

## As Built Site Plan

Revisions    a)  
                  b)  
                  c)  
                  d)

**CAD**

Critchley Architecture And Design Ltd.  
Contact: 02392 474 919 | info@caad.online

The Old Brewery, 15E South Street, Havant, PO9 1BU



Scale    A3 = 1:200  
Drawn   SAR  
Date    26/11/18

1588-480<sup>0</sup>

20m

40m

60m

80m