




NORTH EAST SITE ELEVATION

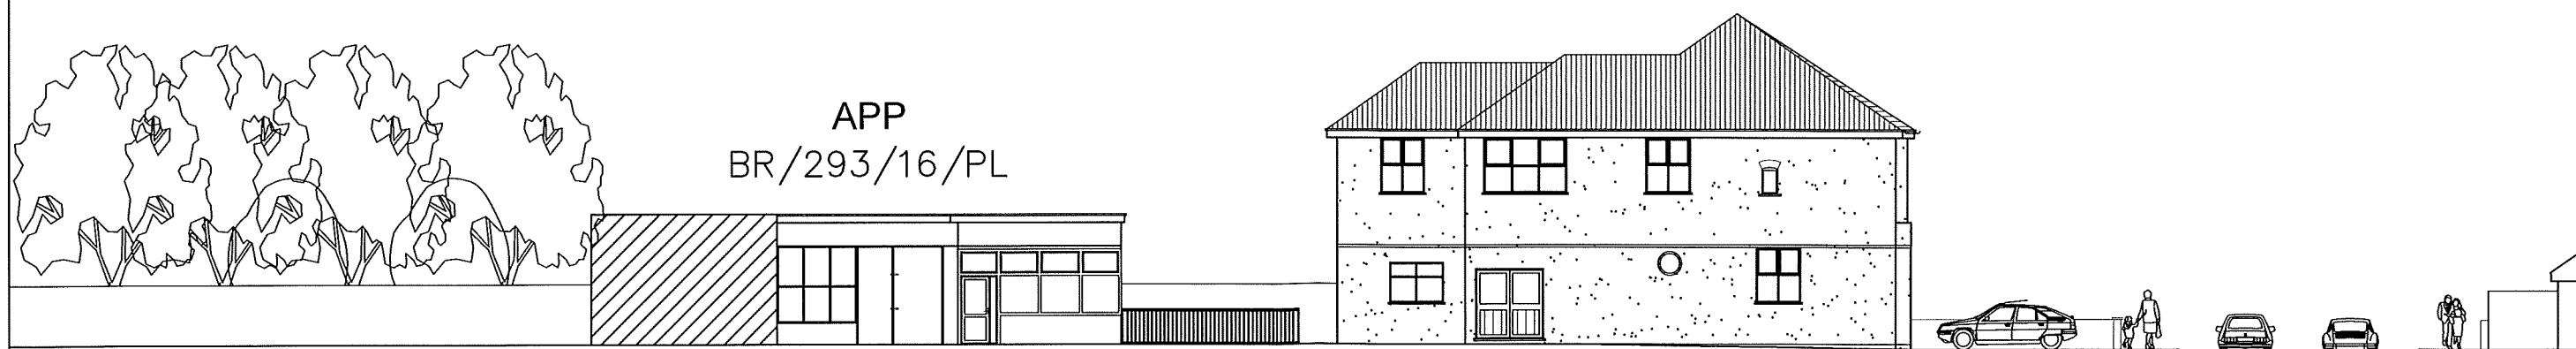


SOUTH WEST SITE ELEVATION

66 Hawthorn Road
Bognor Regis
PO21 2DD

Existing
Elevations

Revisions

- A. As built revisions. 18/08/17
- B.
- C.

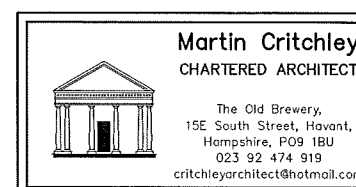

Scale A3 = 1:200
Drawn SAR
Date 01/03/16

1588-306 ^A

