


Volume in crates = 42.2m³
 Volume in stone voids = 10.5m³

Volume in driveway = 26.7m³



Total Volume of Storage =
 79.4m³

Required Volume = 64m³

Refer to Rushby Brewster
 Calculations June'13

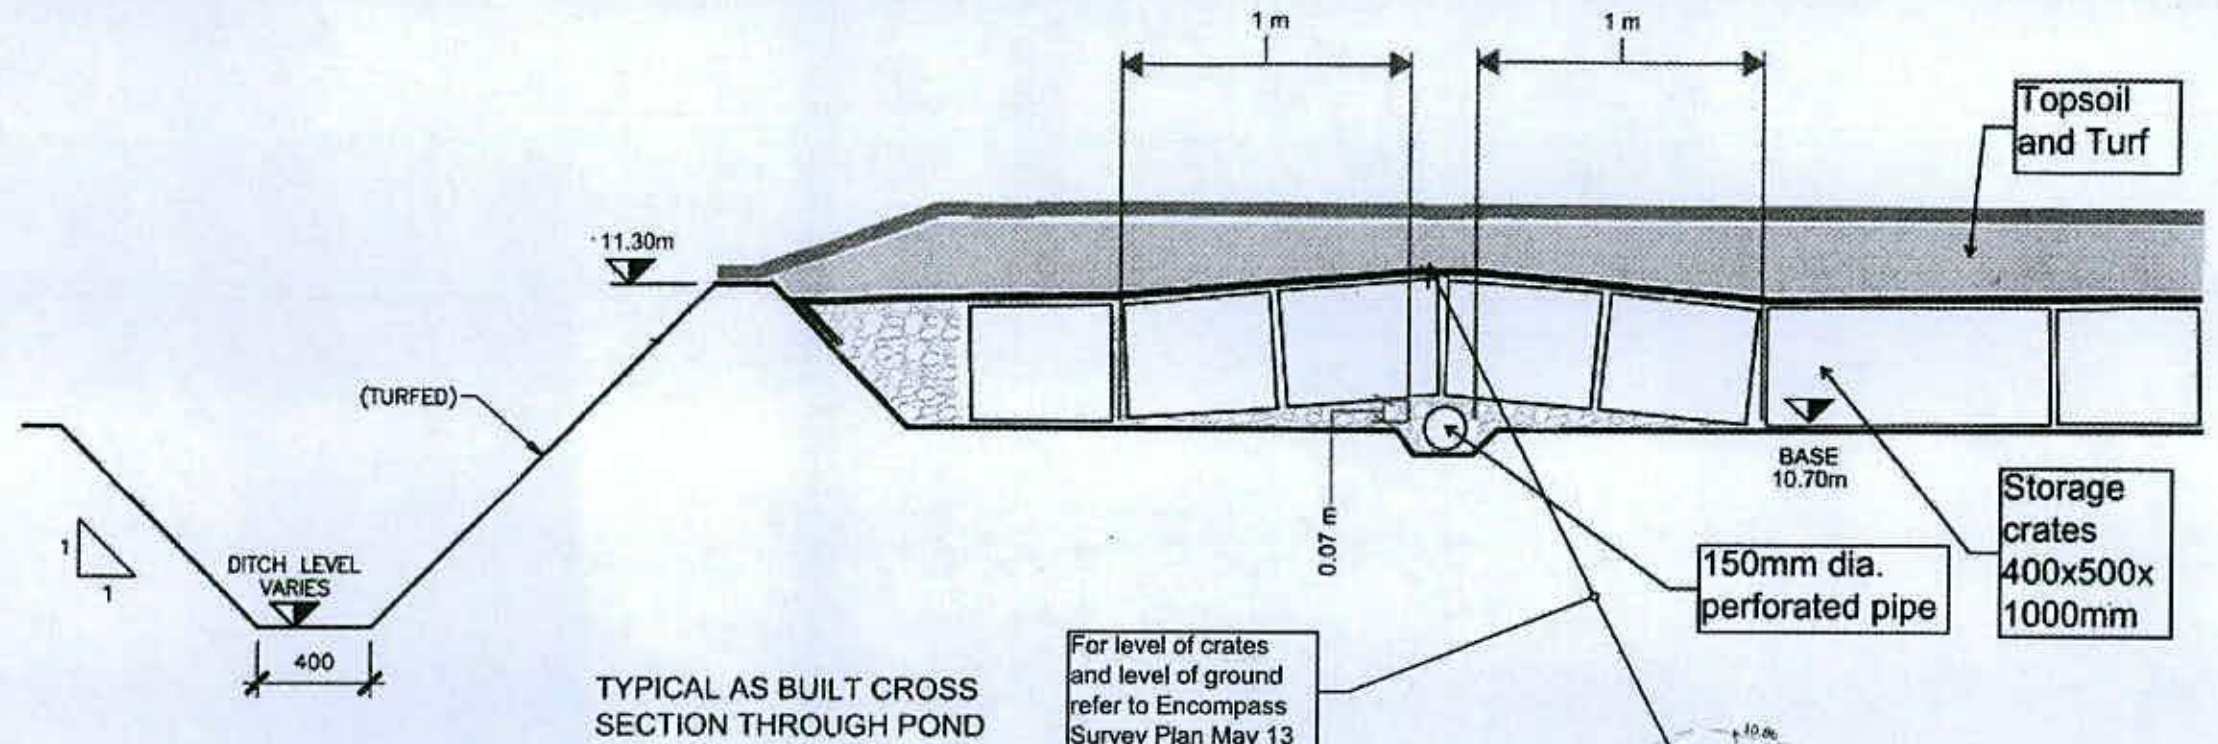

Magenta levels denote top of cages below ground level
 Cyan levels denote ground level
 Please note: Top of cages levels were obtained by digging small unobtrusive holes down to the top of cages. In some places, the top of cage was hard to detect and had to be done from sound and feeling a different base below the rod. Therefore these levels are indicative and the exact level cannot be guaranteed without more obtrusive excavations/groundworks.

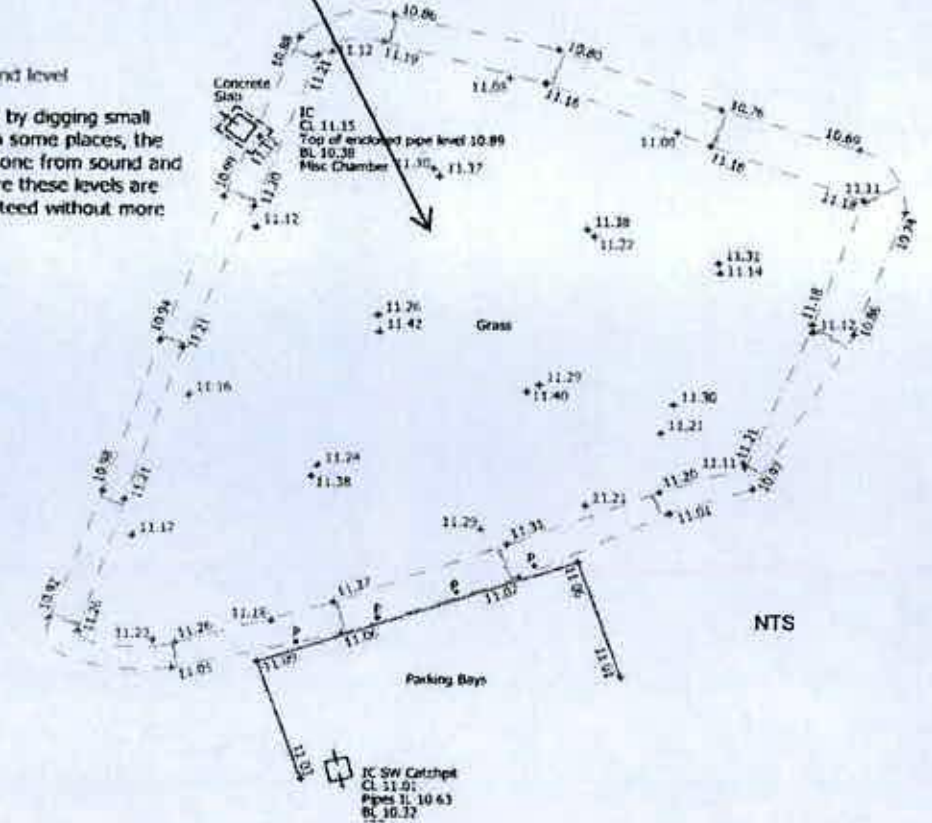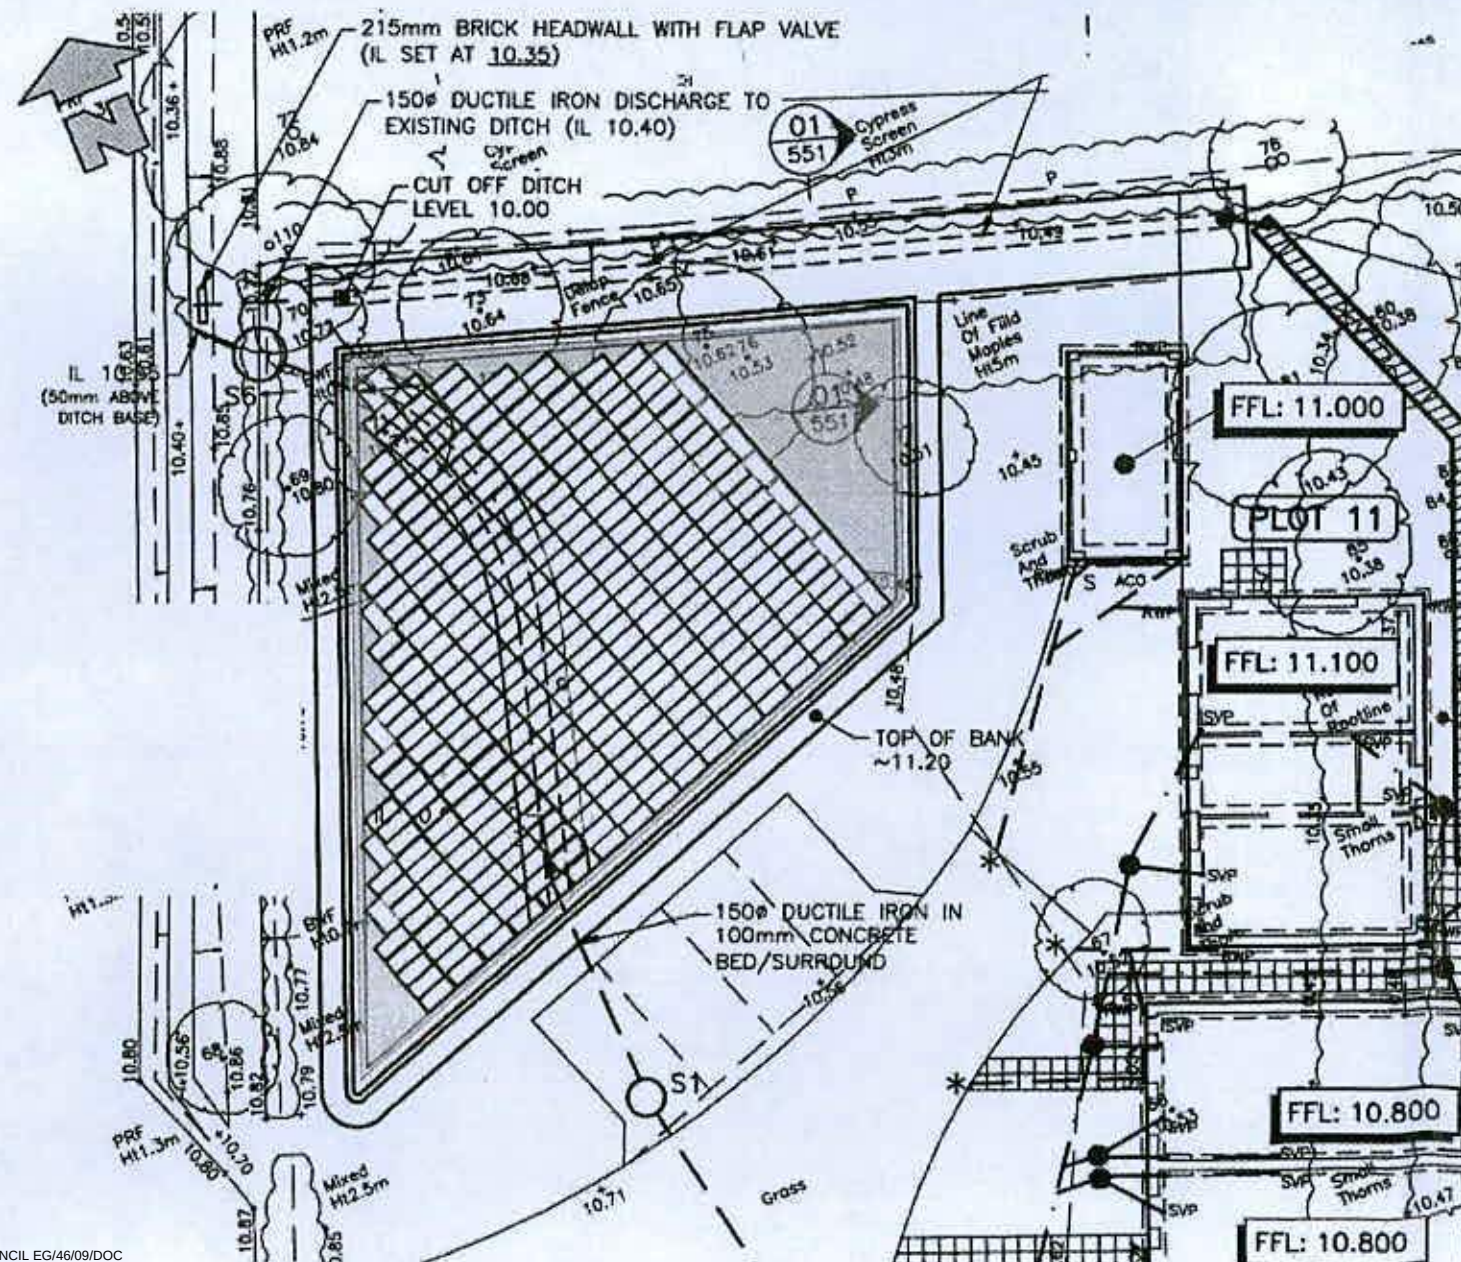

Remedial Works to balancing
 pond at Chantry Mead, Barnham.
 AS BUILT

Scale: Plan 1:200 Section 1:25
 Date: June 13

Drg. BAR/CM/SK/001 Rev C

