



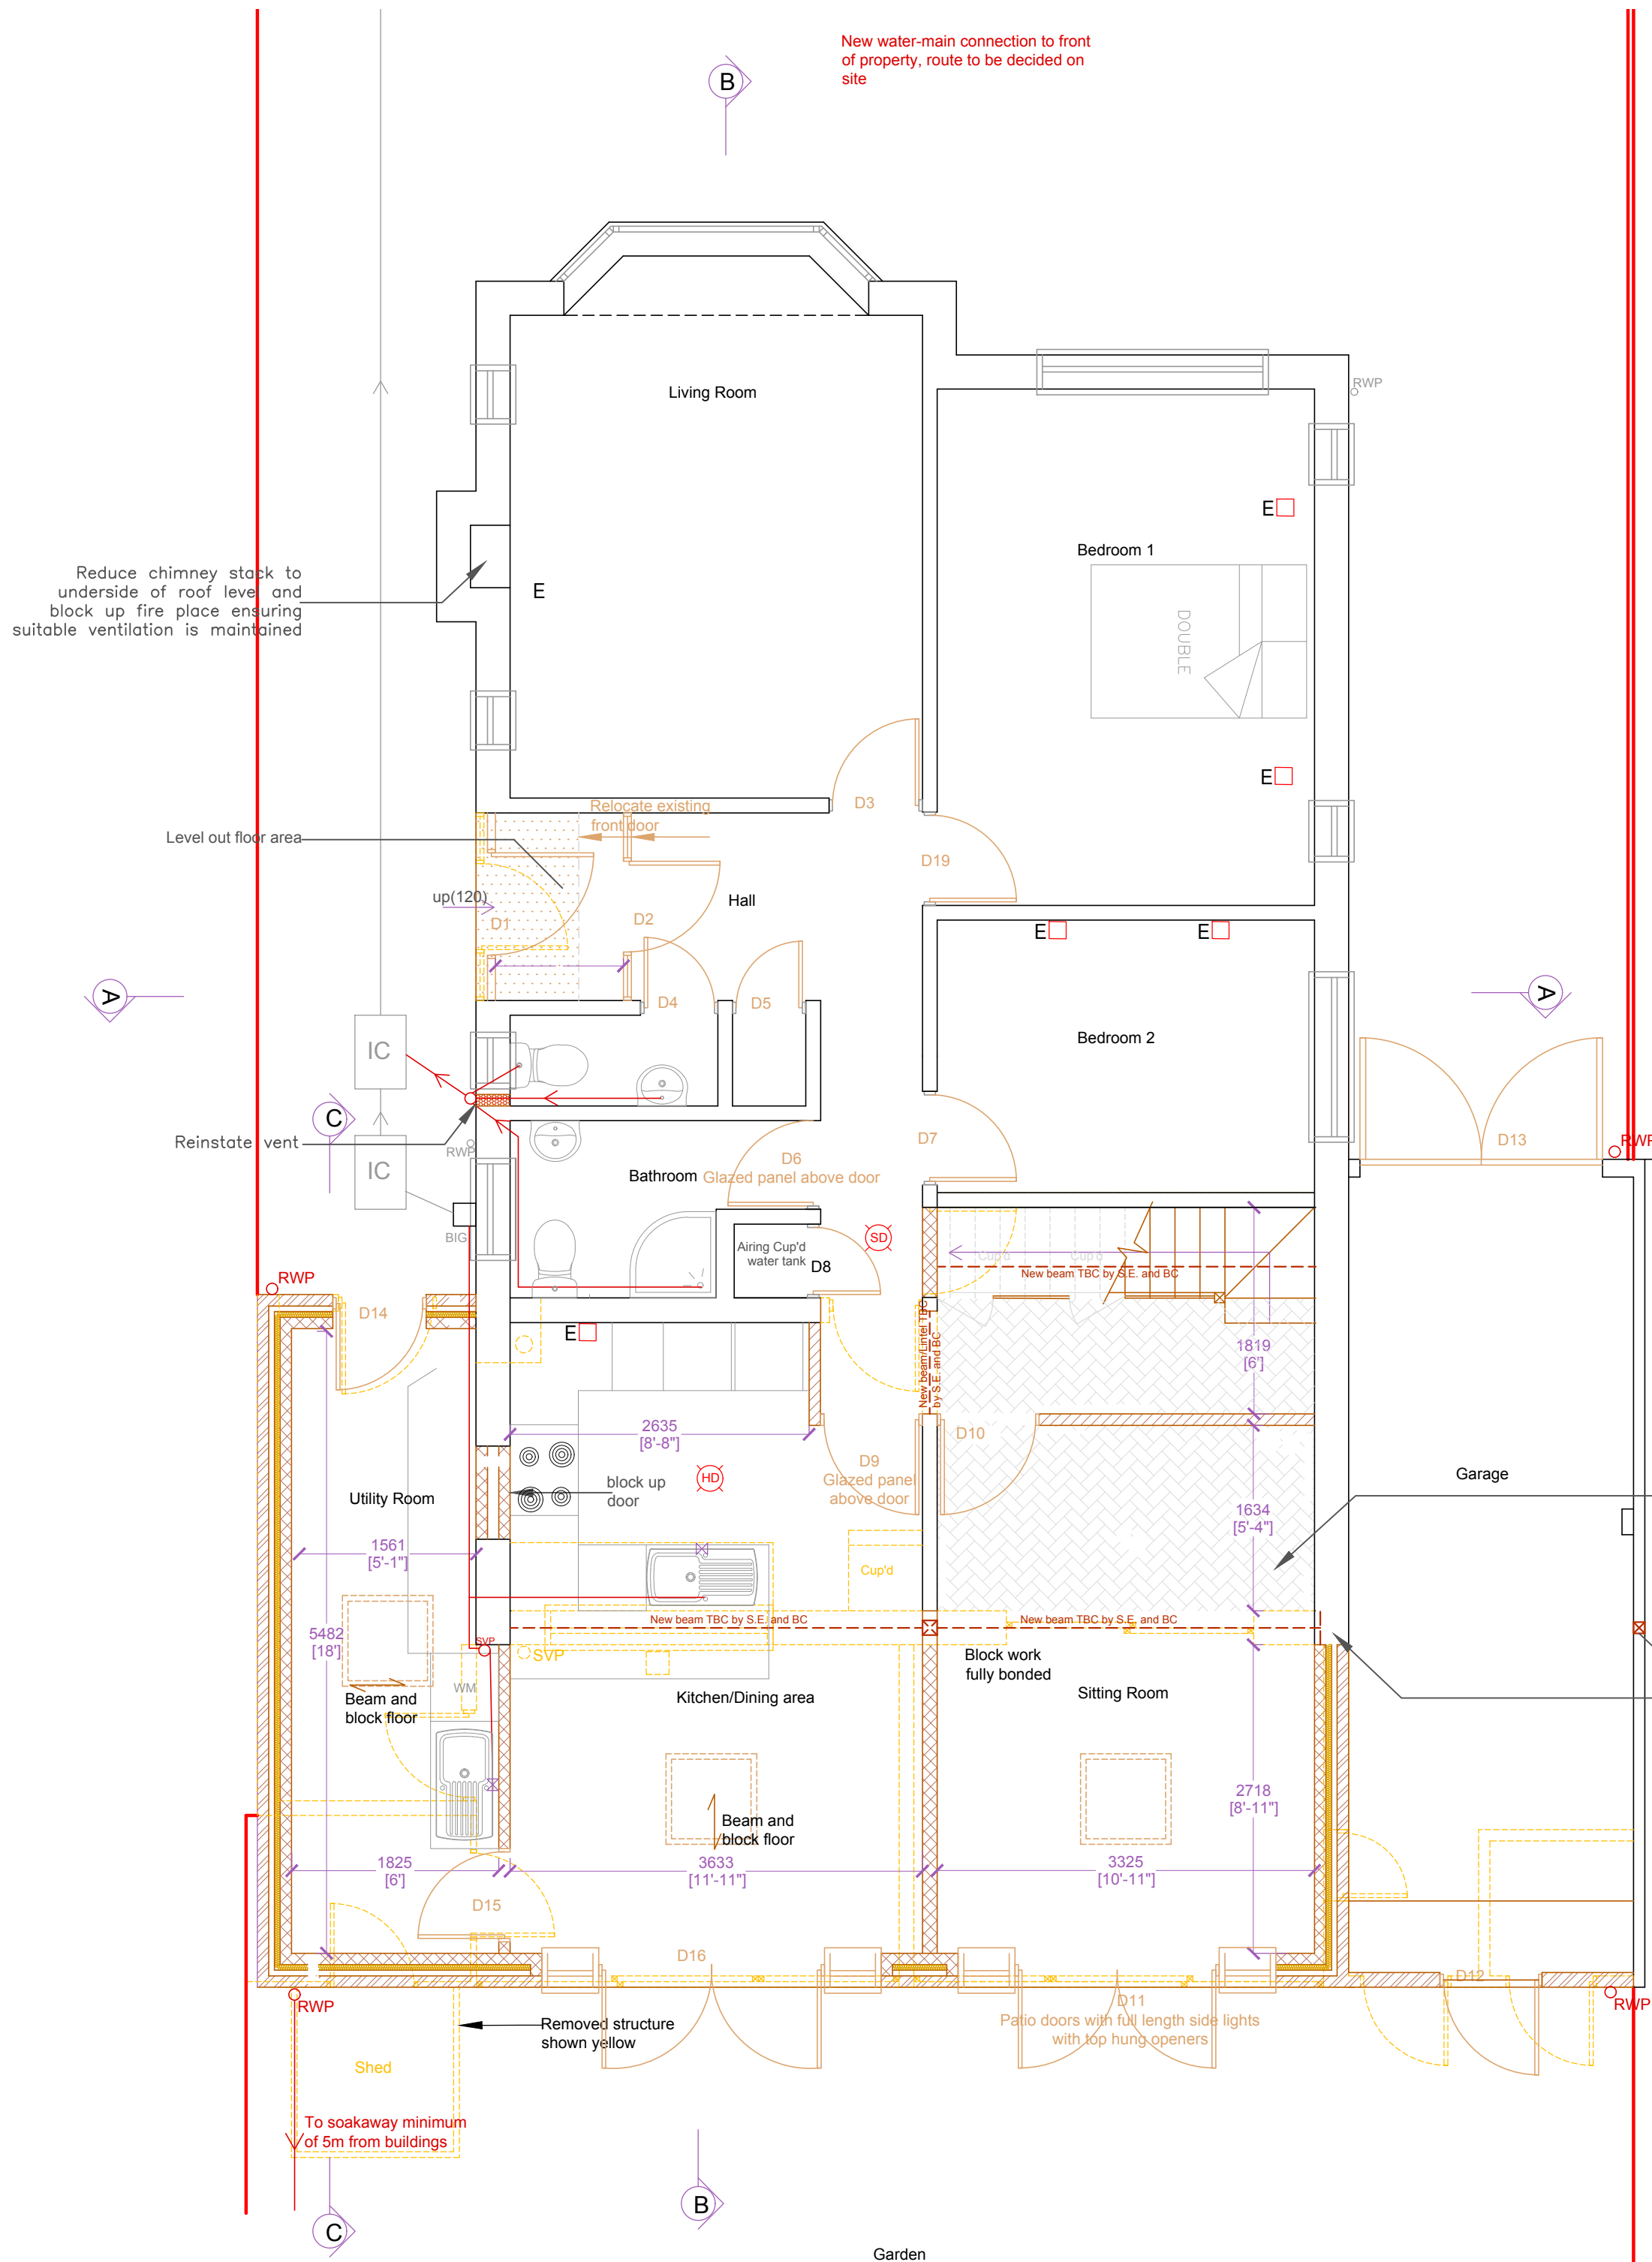


GROUND FLOOR

PROPOSED FLOOR PLANS  
1:50

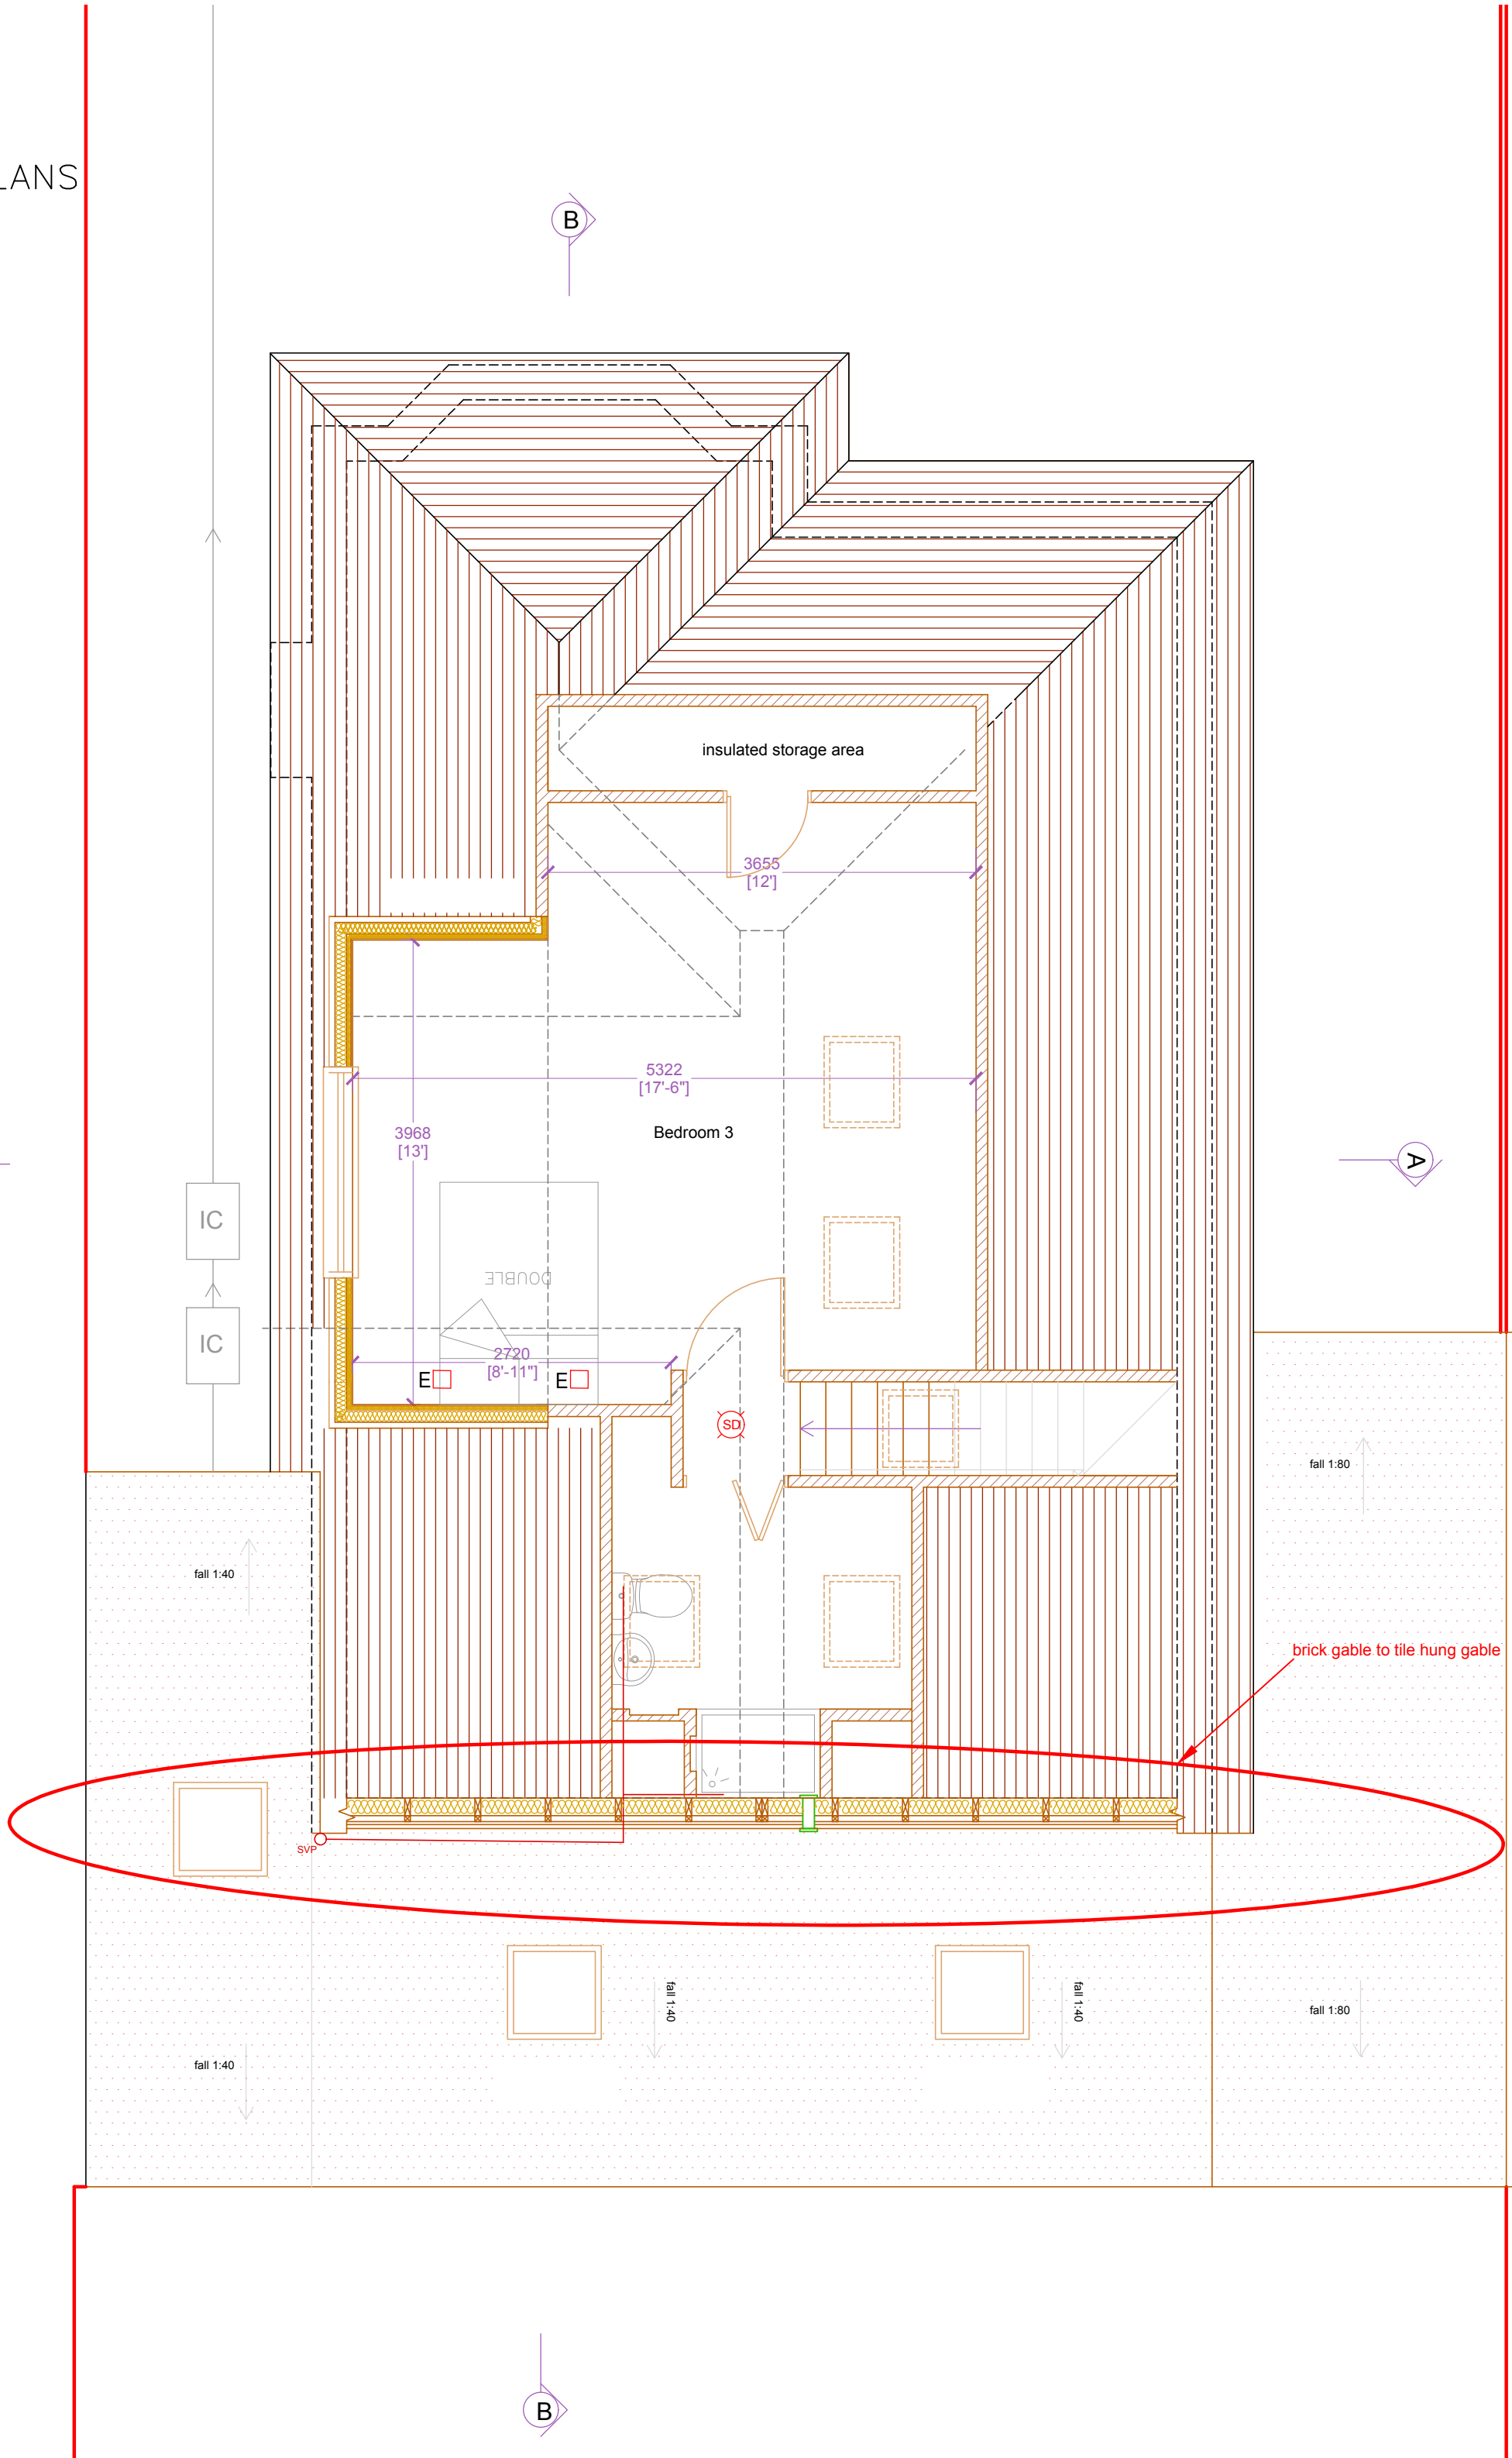


FIRST FLOOR

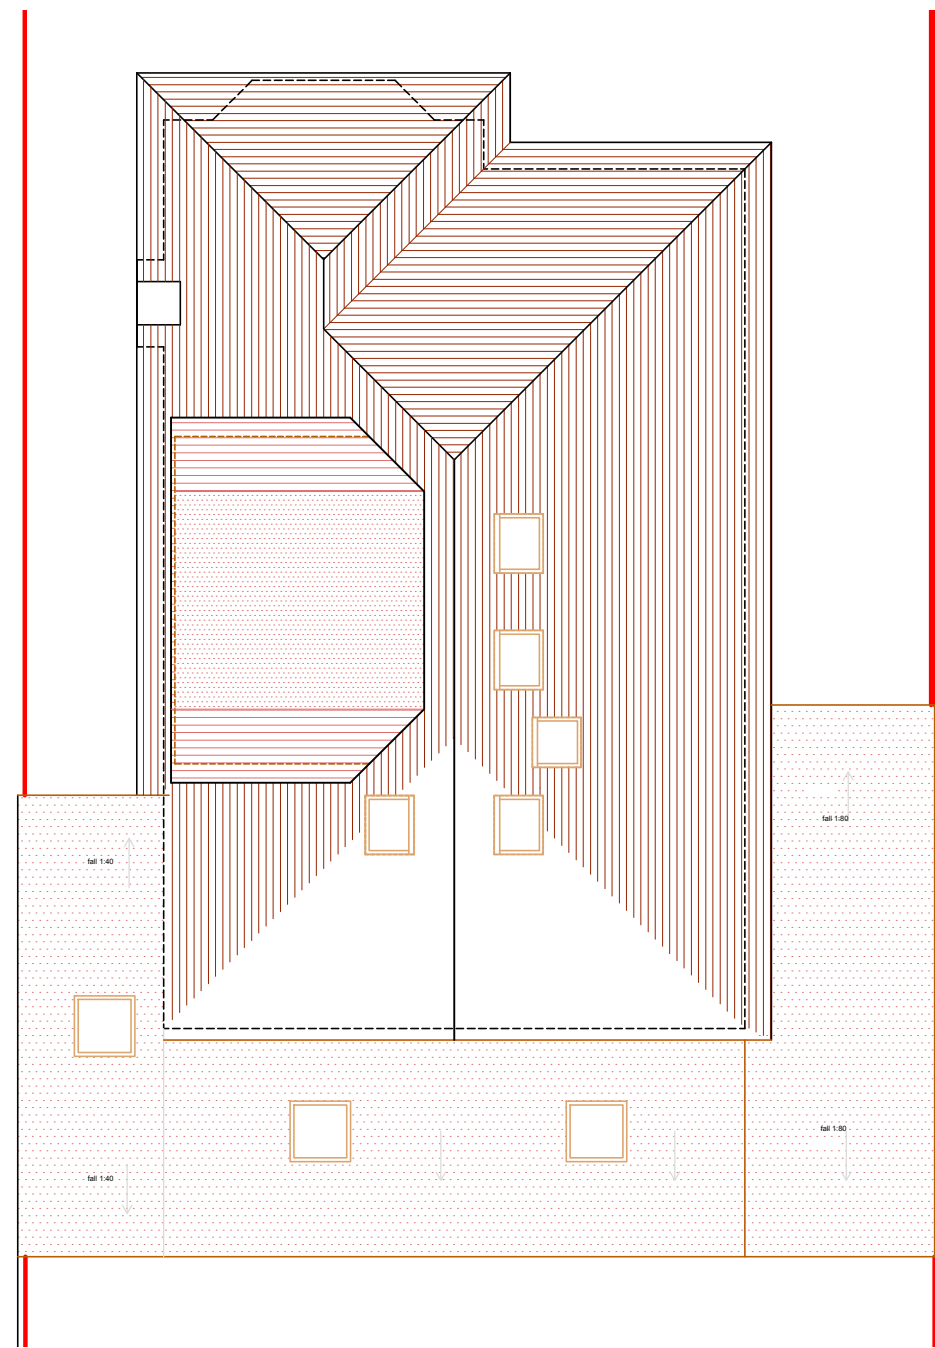

ROOF PLAN 1:100


- Legend:
- Elevations Key:
- ① \_ Existing brick wall
  - ② \_ Existing window/door
  - ③ \_ Existing roof tiles
  - ④ \_ Proposed window/door
  - ⑤ \_ New brick wall matching existing
  - ⑥ \_ New roof tiles matching existing
  - ⑦ \_ New cladding tile-hung matching existing

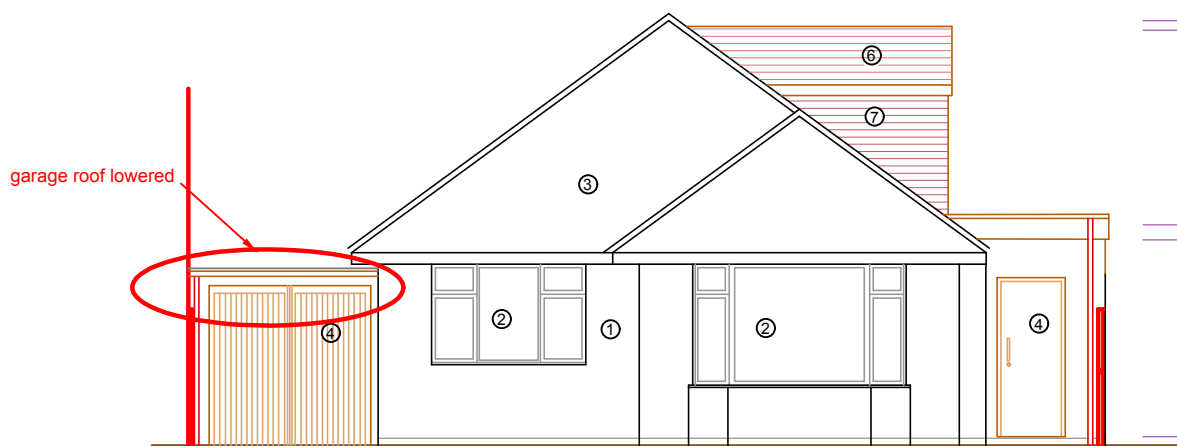


FRONT ELEVATION  
WEST




SIDE ELEVATION  
SOUTH

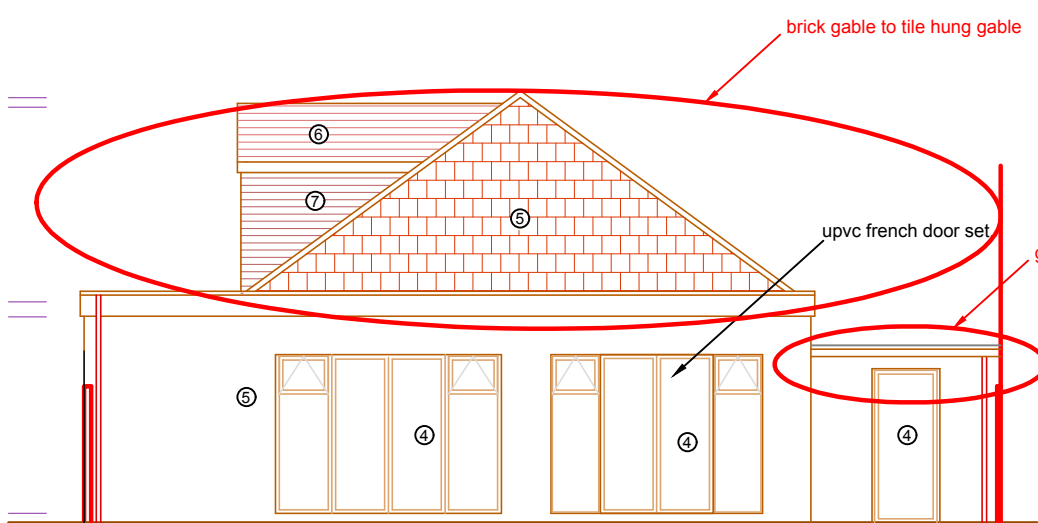

REAR ELEVATION  
EAST  
PROPOSED ELEVATIONS  
1:100

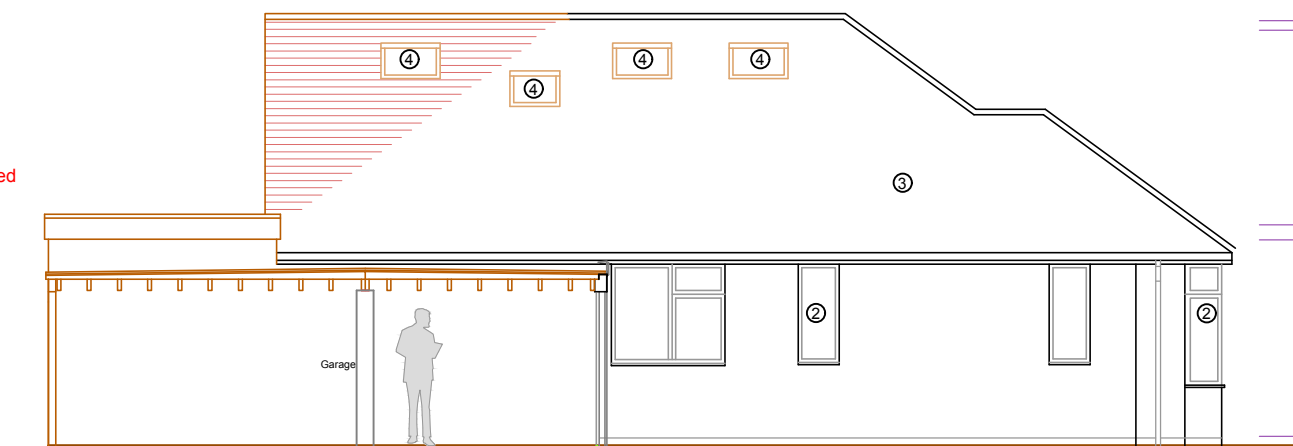

SIDE ELEVATION  
NORTH

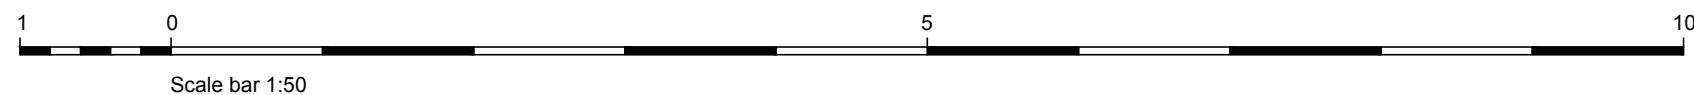

This drawing is the property of Fuller Associates and is not to be copied, reproduced, retained or disclosed to any unauthorised person either wholly or in part without prior consent. Do not scale from this drawing except for Planning purposes. Use all figured dimensions only. All figured dimensions to be checked on site prior to construction. All discrepancies, errors and omissions to be reported to Fuller Associates prior to construction. Layout and dimensions existing building to be checked on site.

| Rev. | Details                                          | Date     |
|------|--------------------------------------------------|----------|
| A.   | Amends in accordance with structurals and checks | 26/03/19 |
| B.   | Adjusted as per letter of intent                 | 20/06/19 |
| D.   | Amends from meeting                              | 14/10/19 |
| E.   | Amends from Electrician                          | 17/10/19 |
| F.   | Garage Roof amended                              | 28/10/19 |
| G.   | Gable construction                               | 30/10/19 |

**FULLER ASSOCIATES**  
Chartered Surveyors • Architectural Design

10-11 The Parade  
Willowhayne Crescent  
East Preston  
West Sussex  
BN16 1NS

01903 774754  
www.fuller-associates.co.uk

|                      |       |         |
|----------------------|-------|---------|
| Issued for:          | Drawn | Checked |
| Discussion           | KW    | DF      |
| Planning Application | KW    | X       |
| Building Control     | KW    | DF      |
| Construction Issue   | X     | X       |
| As Built             | X     | X       |

PROPOSED PLANS, ELEVATIONS AND ROOF PLAN  
**CONSTRUCTION ISSUE**

Client  
Site Address  
42 The Roystons  
East Preston  
West Sussex  
BN16 2TS

Mr and Mrs Hickey

Printed  
Date  
Drawing Number

As Shown on A1  
30/10/2019  
183016/01G