




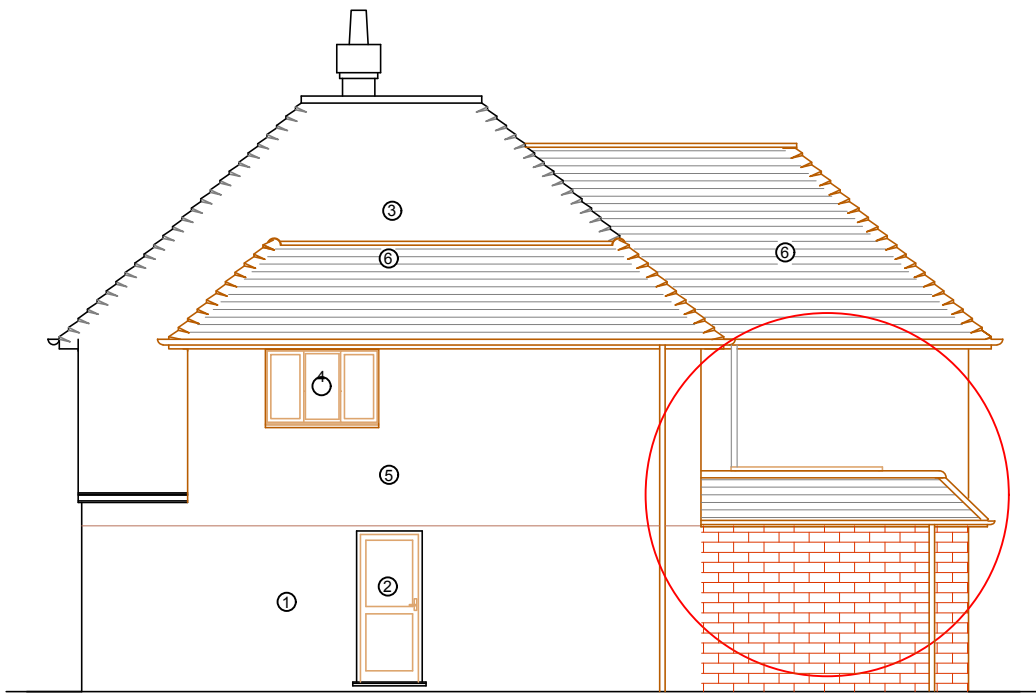

Side Elevation
North

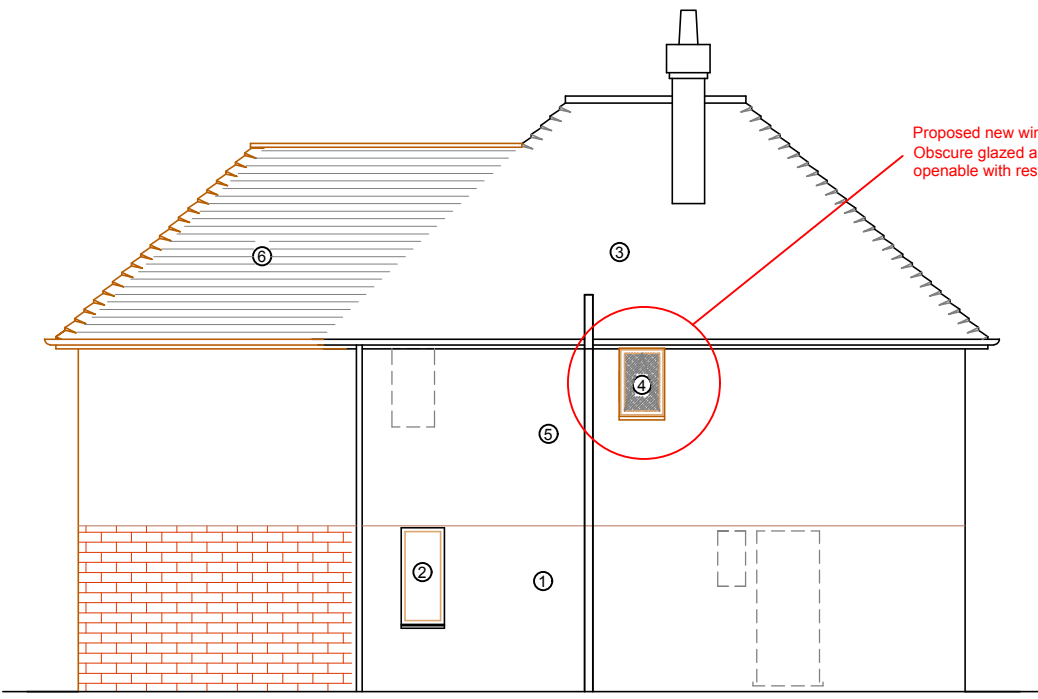

Side Elevation
South

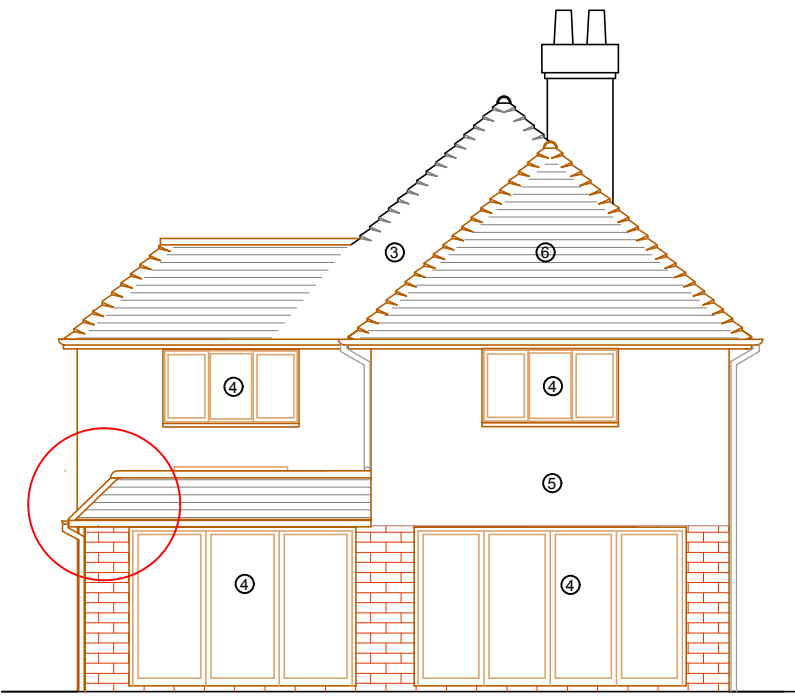


Rear Elevation
West




Front Elevation
East

Proposed Elevations
1:100



- Legend:
- Elevations Key:
- ① _ Existing brick wall
 - ② _ Existing window
 - ③ _ Existing roof tiles
 - ④ _ Proposed window/door
 - ⑤ _ New render matching existing
 - ⑥ _ New roof tiles matching existing

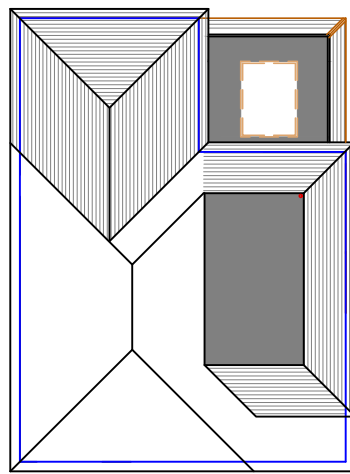


Roof Plan
1:200

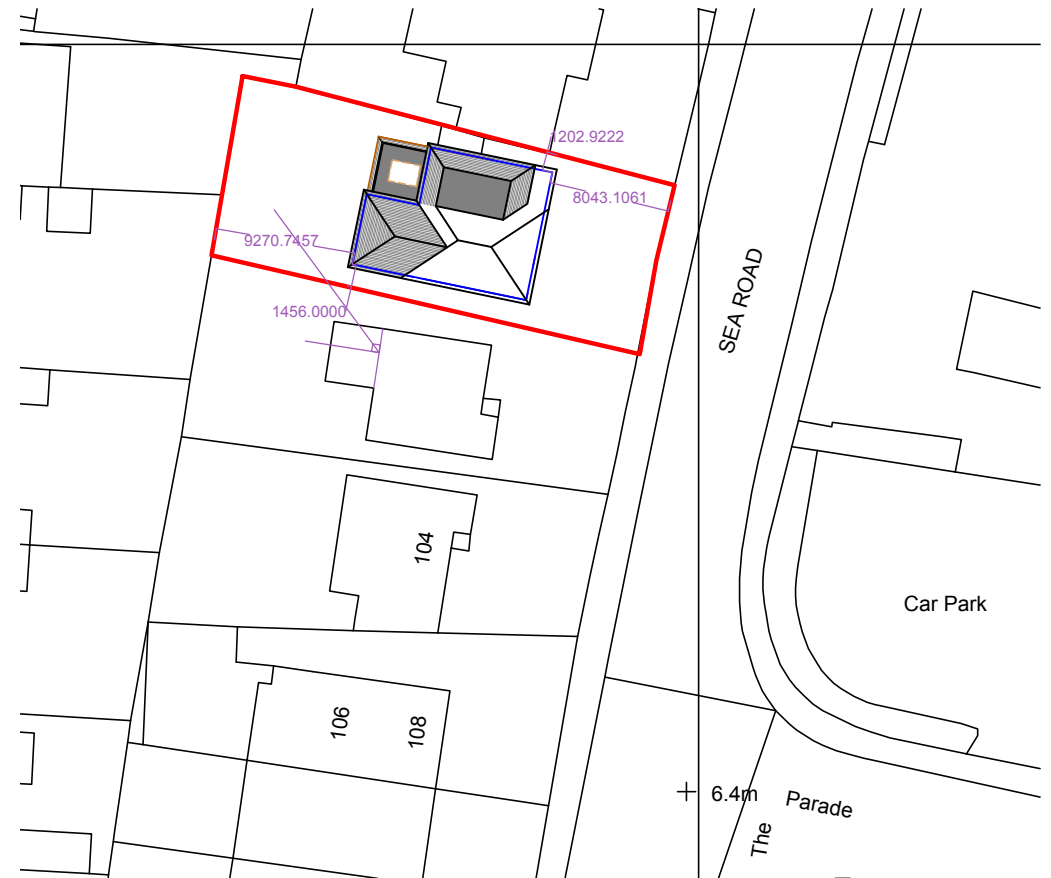

Block Plan
1:500

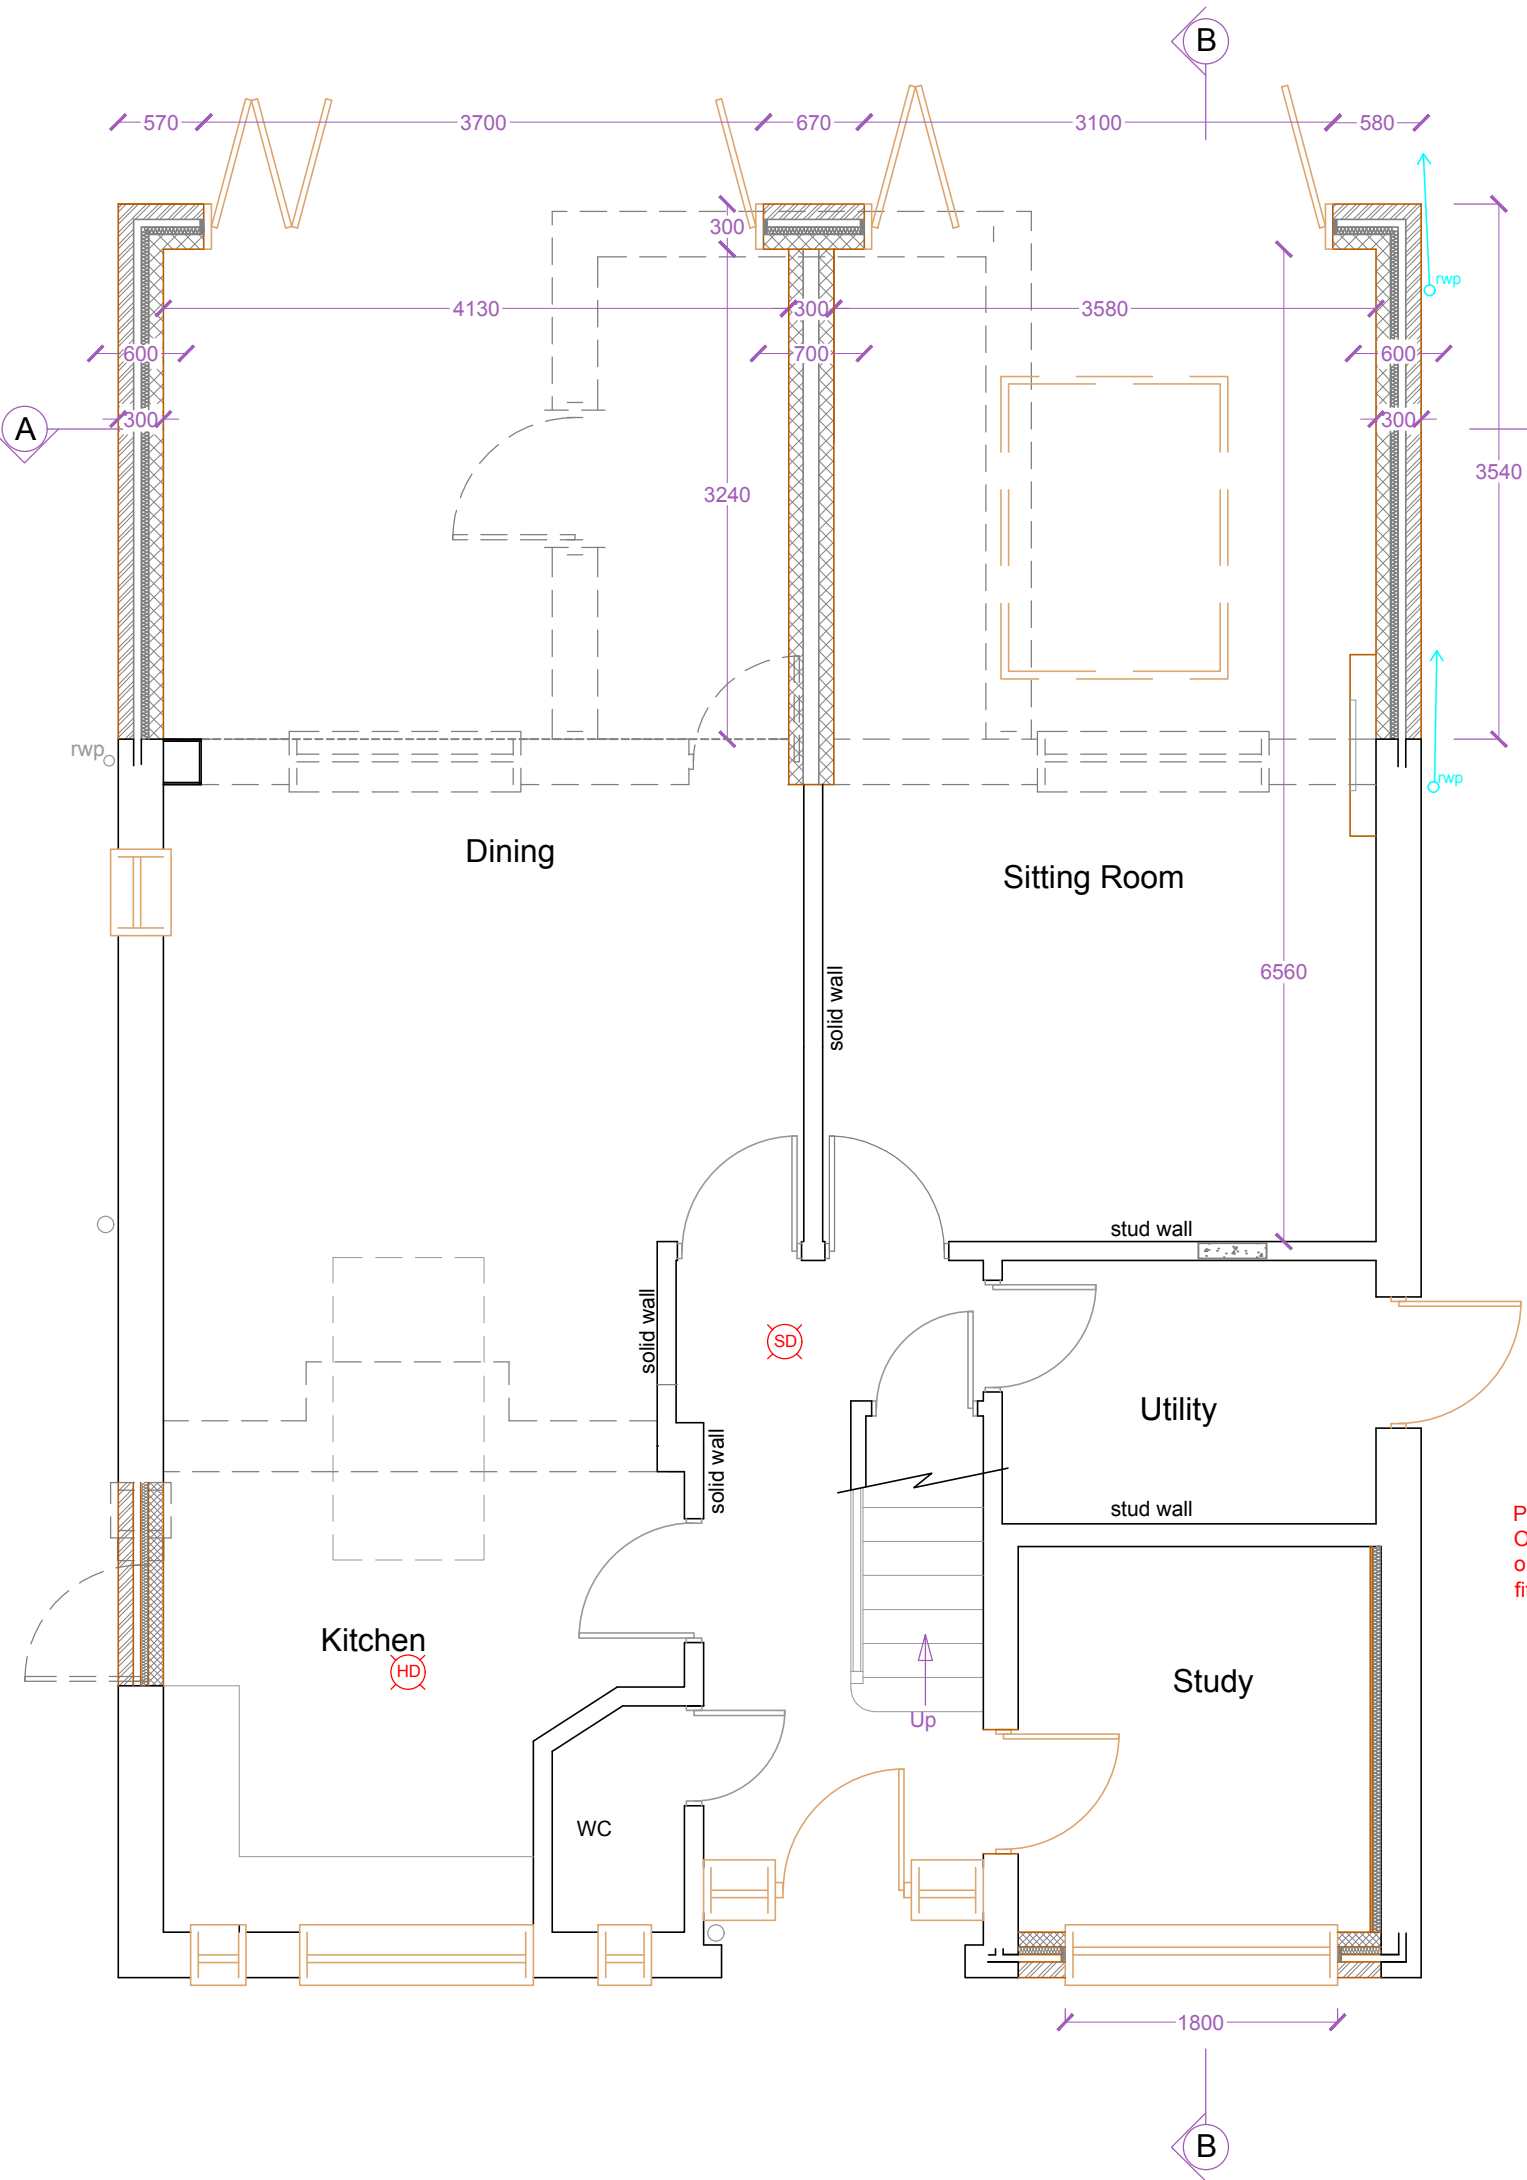
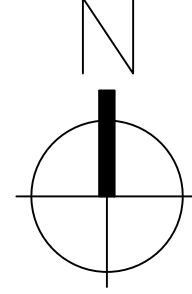


Ground Floor

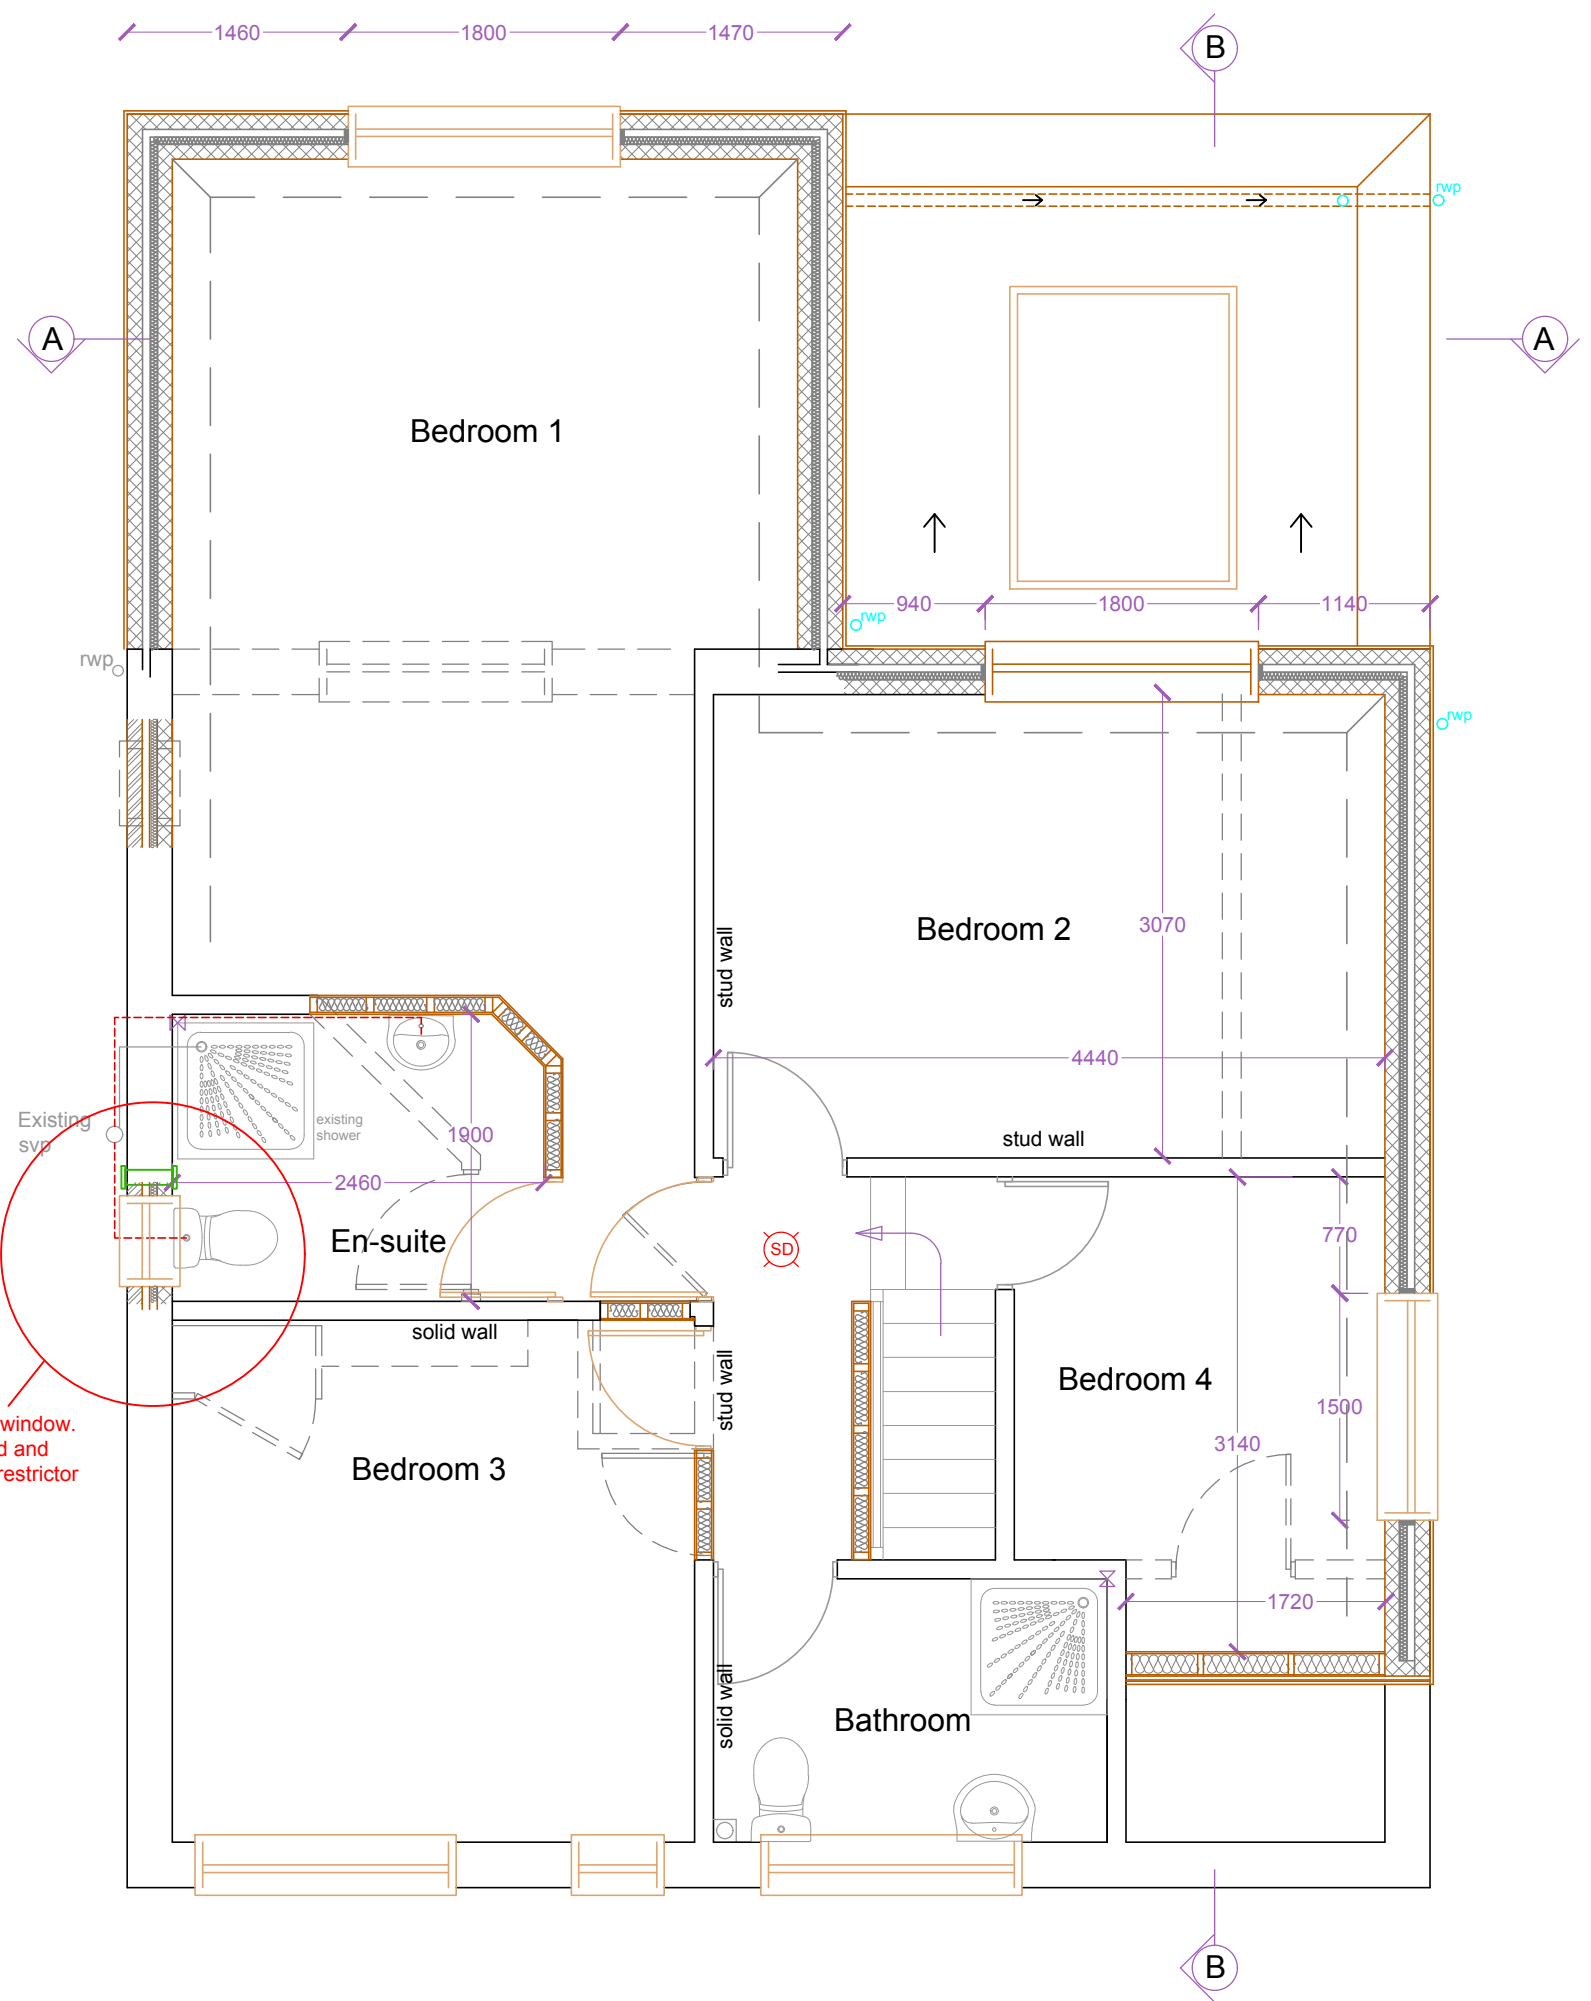

First Floor

Proposed Floor Plans
1:50

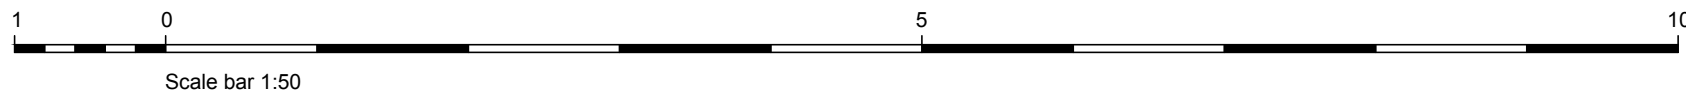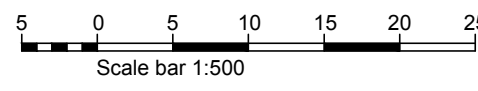

This drawing is the property of Fuller Associates and is not to be copied reproduced, retained or disclosed to any unauthorised person either wholly or in part without prior consent. Do not scale from this drawing except for Planning purposes. Use all figured dimensions only. All figured dimensions to be checked on site prior to construction. All discrepancies, errors and omissions to be reported to Fuller Associates prior to construction. Layout and dimensions existing building to be checked on site.

Rev.	Details	Date

FULLER ASSOCIATES
Chartered Surveyors • Architectural Design

10-11 The Parade
Willowhayne Crescent
East Preston
West Sussex
BN16 1NS

01903 774754
www.fuller-associates.co.uk

Issued for:	Drawn	Checked
Discussion	X	X
Planning Application	ALP	KW
Building Control	X	X
Construction Issue	X	X
As Built	X	X

PROPOSED PLANS, ELEVATIONS, ROOF PLAN AND BLOCK PLAN
Minor Amendment for the addition of new window to first floor as highlighted and parapet roof profile

Client
Site Address
100 Sea Road
East Preston
West Sussex
BN16 1NP

Mr and Mrs Doyle

Printed
Date
Drawing Number

As Shown on A1
05/07/2019
183011/04