

GENERAL NOTES:


All existing RWP's and gutters to be removed and replaced with new UPVC RWP's and gutters RAL 7040 Window Grey.
All new doors and windows colour RAL 7040 Window Grey - new bifolds and sliding doors to master bedroom to be Aluminium
All existing external walls to be white silicone render including walls to the garage.

Revisions


No.	Description	Date	By
4	Planning - Minor amendments to elevations	10/04/2021	
3	DRAFT issue for client review and mark-up	03/04/2021	
2	Amendments to elevations	13-11-2020	

Notes:

Generally: RAL7037 Dusty Grey Changed to RAL 7040 Window Grey

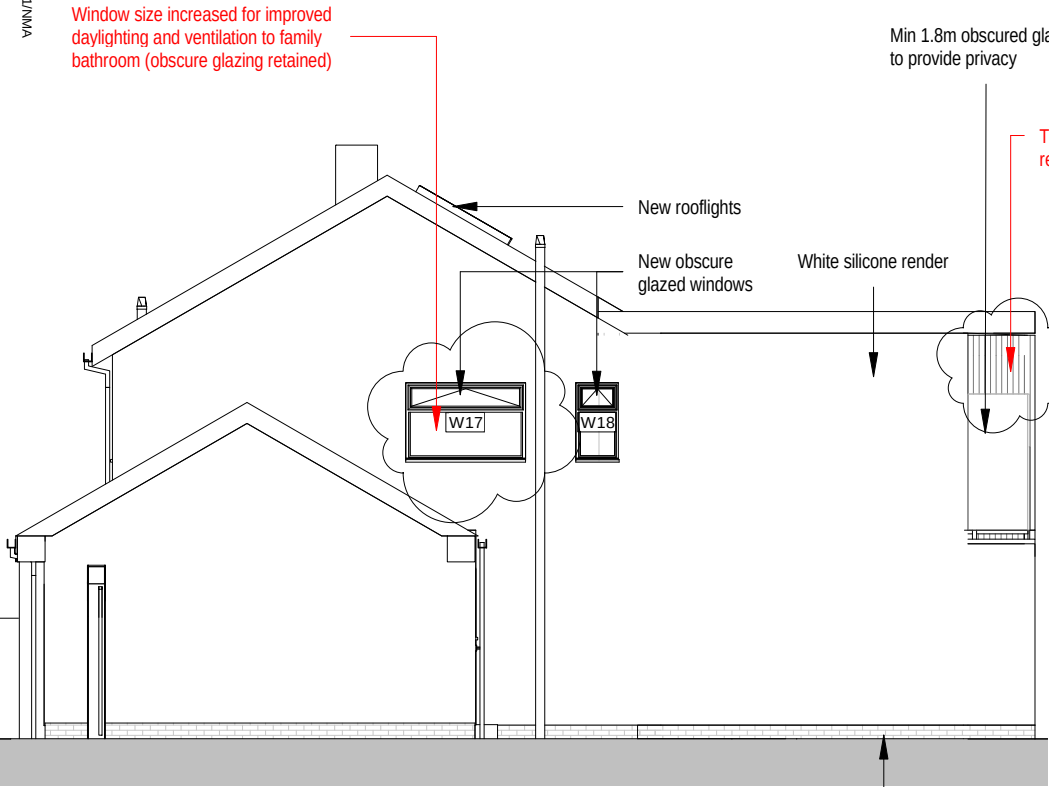


Proposed South Elevation
1 : 100

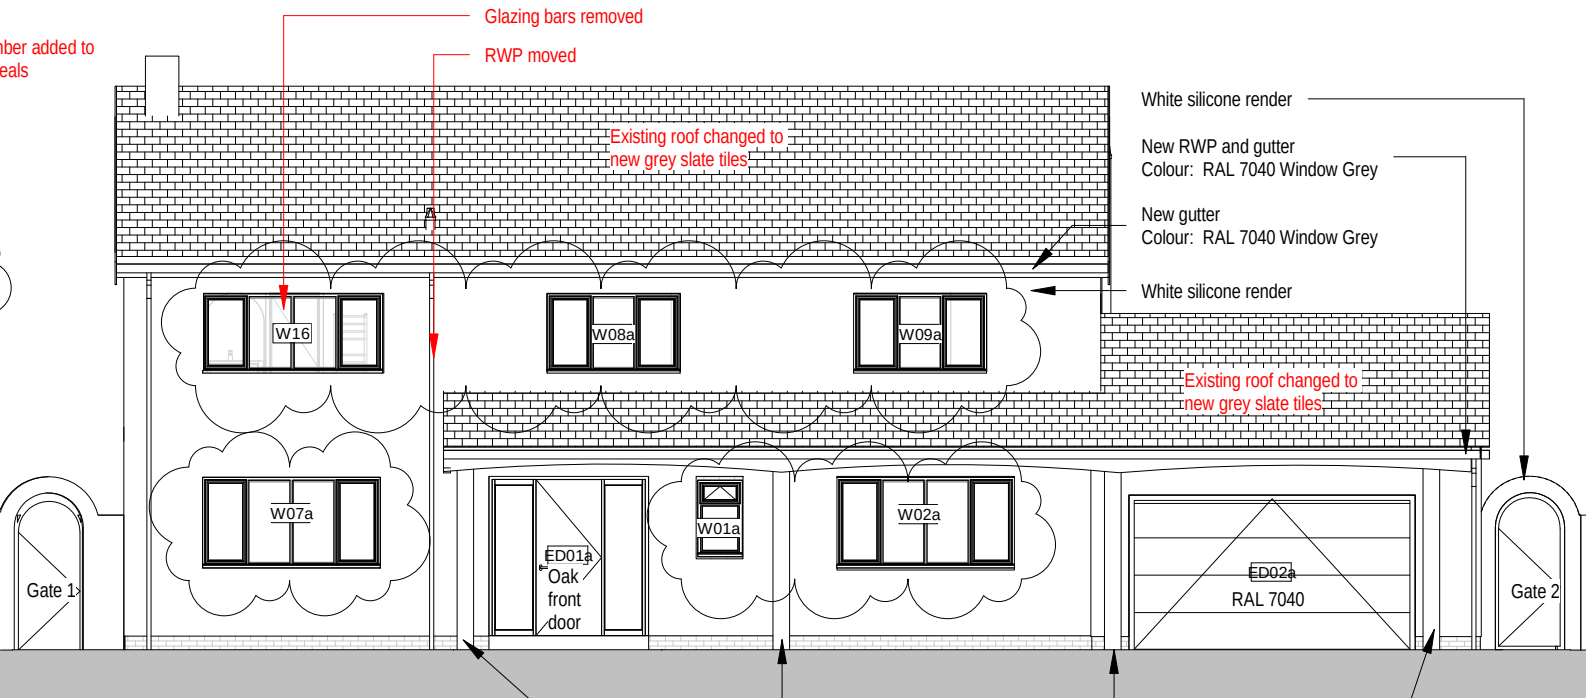

Proposed West Elevation
1 : 100



Proposed East Elevation
1 : 100

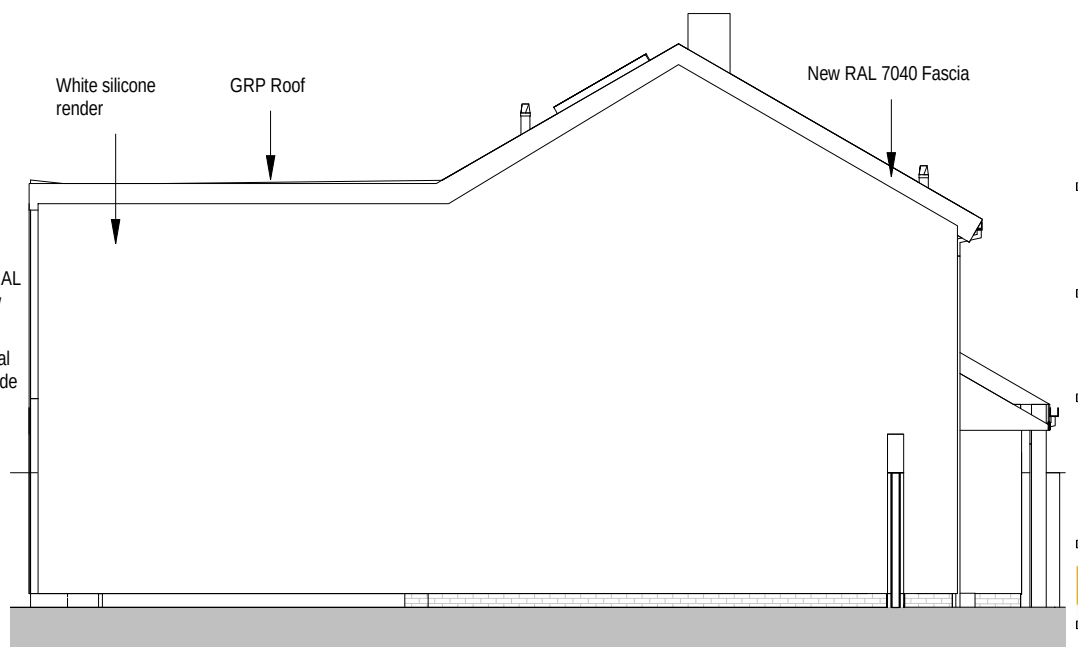

Proposed North Elevation
1 : 100



Scale: 1 : 100 @ A3

Project No. 217 Project Name: 48 Angmering Lane

Drawing No. 0010 Drawing Name: GA Proposed Elevations

Revision: P 4 Suitability Description: PLANNING Project Issue Date: AUG 20

Drawn: GF Checked: MS Orig Paper Size: A3

FRESH Architects

T 07703682107 | 07393913140
info@fresh-architects.co.uk | www.fresharchitects.co.uk

Use figured dimensions only. All levels and dimensions to be checked. This drawing is to be read in conjunction with all other relevant drawings and specifications.
© FRESH Architects Ltd. All rights reserved