


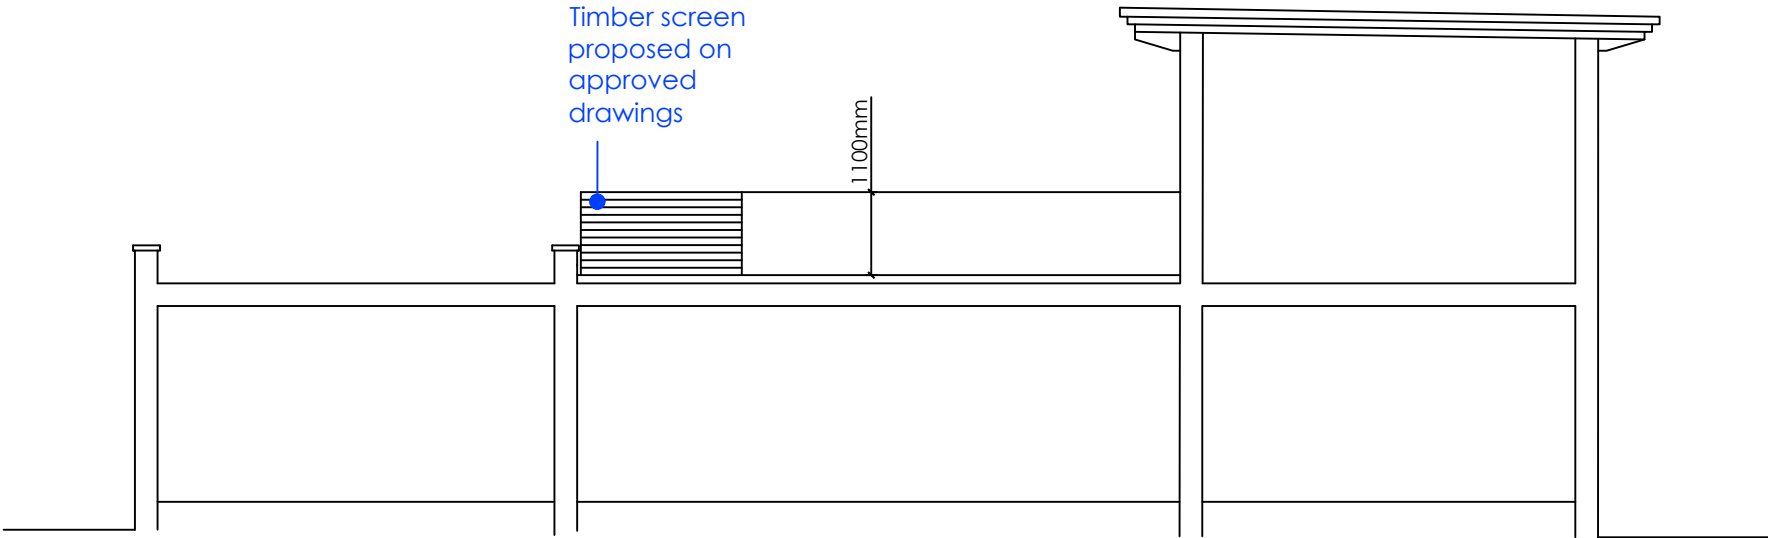


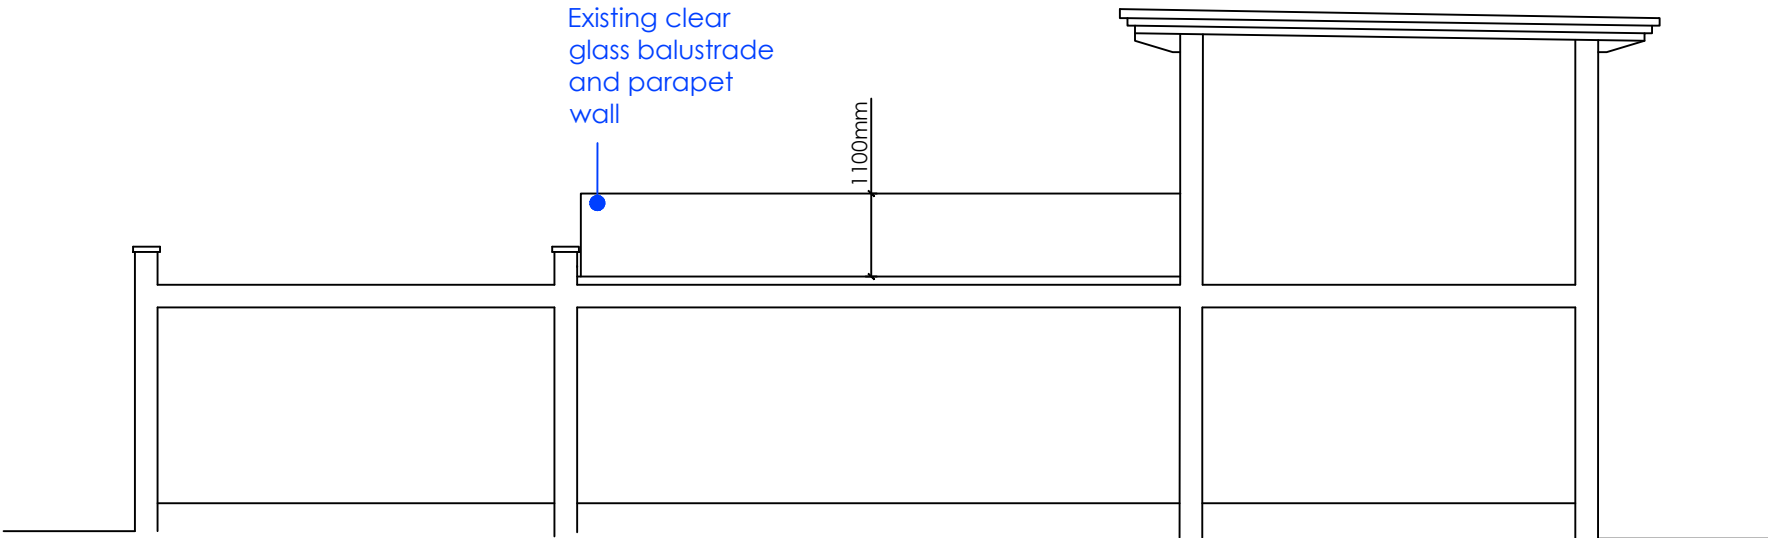


APPROVED CROSS SECTION EP/34/13 1:100

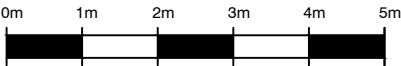

AS BUILT CROSS SECTION 1:100

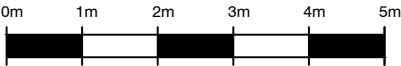


Ordnance Survey
Ukmapcentre.com

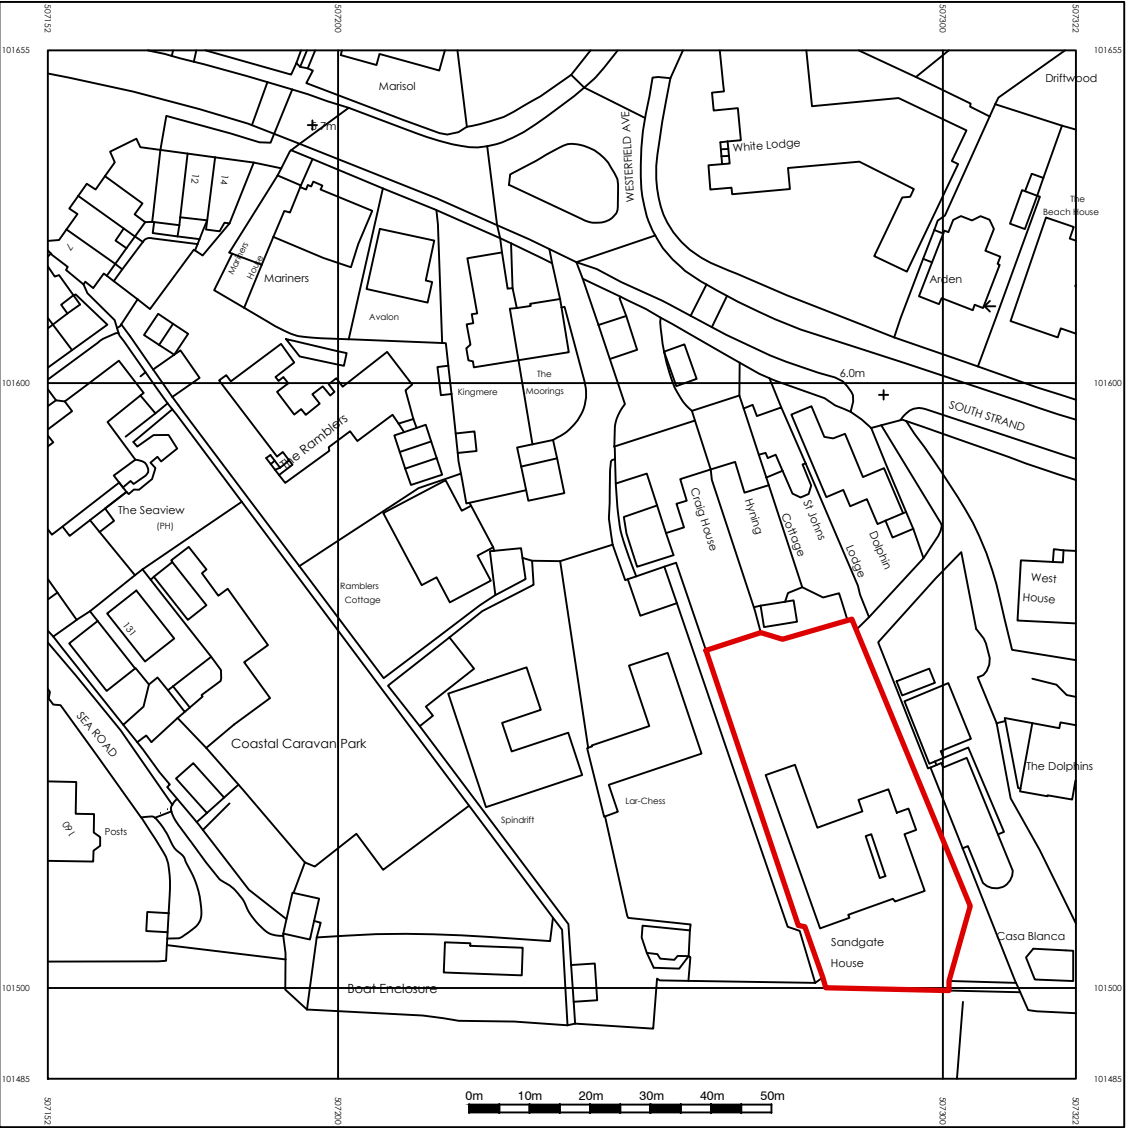

Serial number: 143040
© Crown copyright and database right 2019
Ordnance Survey licence 100048957
Reproduction in whole or in part is prohibited
without the prior permission of Ordnance Survey

LOCATION PLAN 1:1250

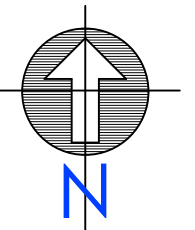

ama atterbury moore associates		architectural & quantity surveying services		Unit 1 Gosling Croft Business Park Long Furlong Clapham Worthing West Sussex BN13 3UT 01903 871131 carl@atterburymoore.co.uk	
Address of works: Sandgate House, South Strand, east Preston					
Drawing title: Retrospective application for clear glass to balcony					
Date: April 2021		Scales: As shown		Paper size: A3	
				Dwg No: AR-119-17	