



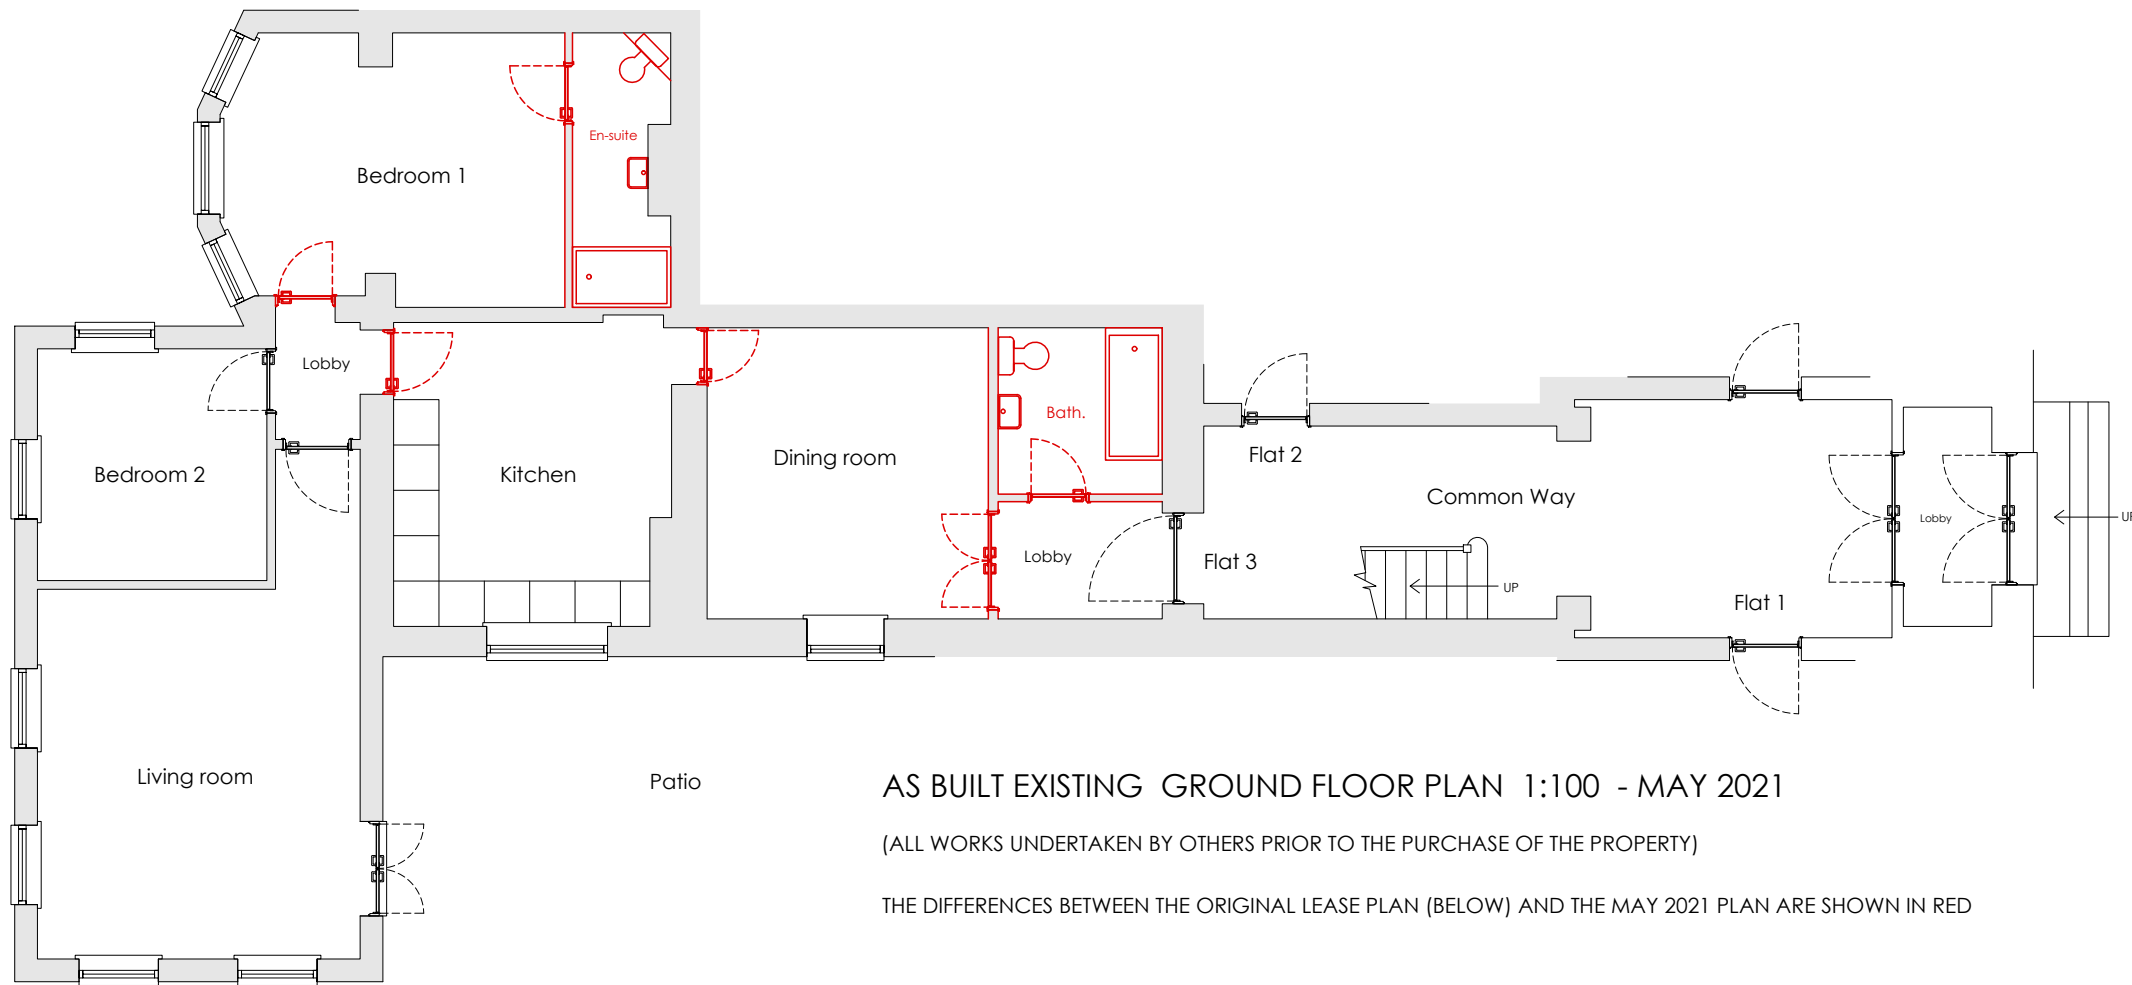

AS BUILT EXISTING GROUND FLOOR PLAN 1:100 - MAY 2021

(ALL WORKS UNDERTAKEN BY OTHERS PRIOR TO THE PURCHASE OF THE PROPERTY)

THE DIFFERENCES BETWEEN THE ORIGINAL LEASE PLAN (BELOW) AND THE MAY 2021 PLAN ARE SHOWN IN RED

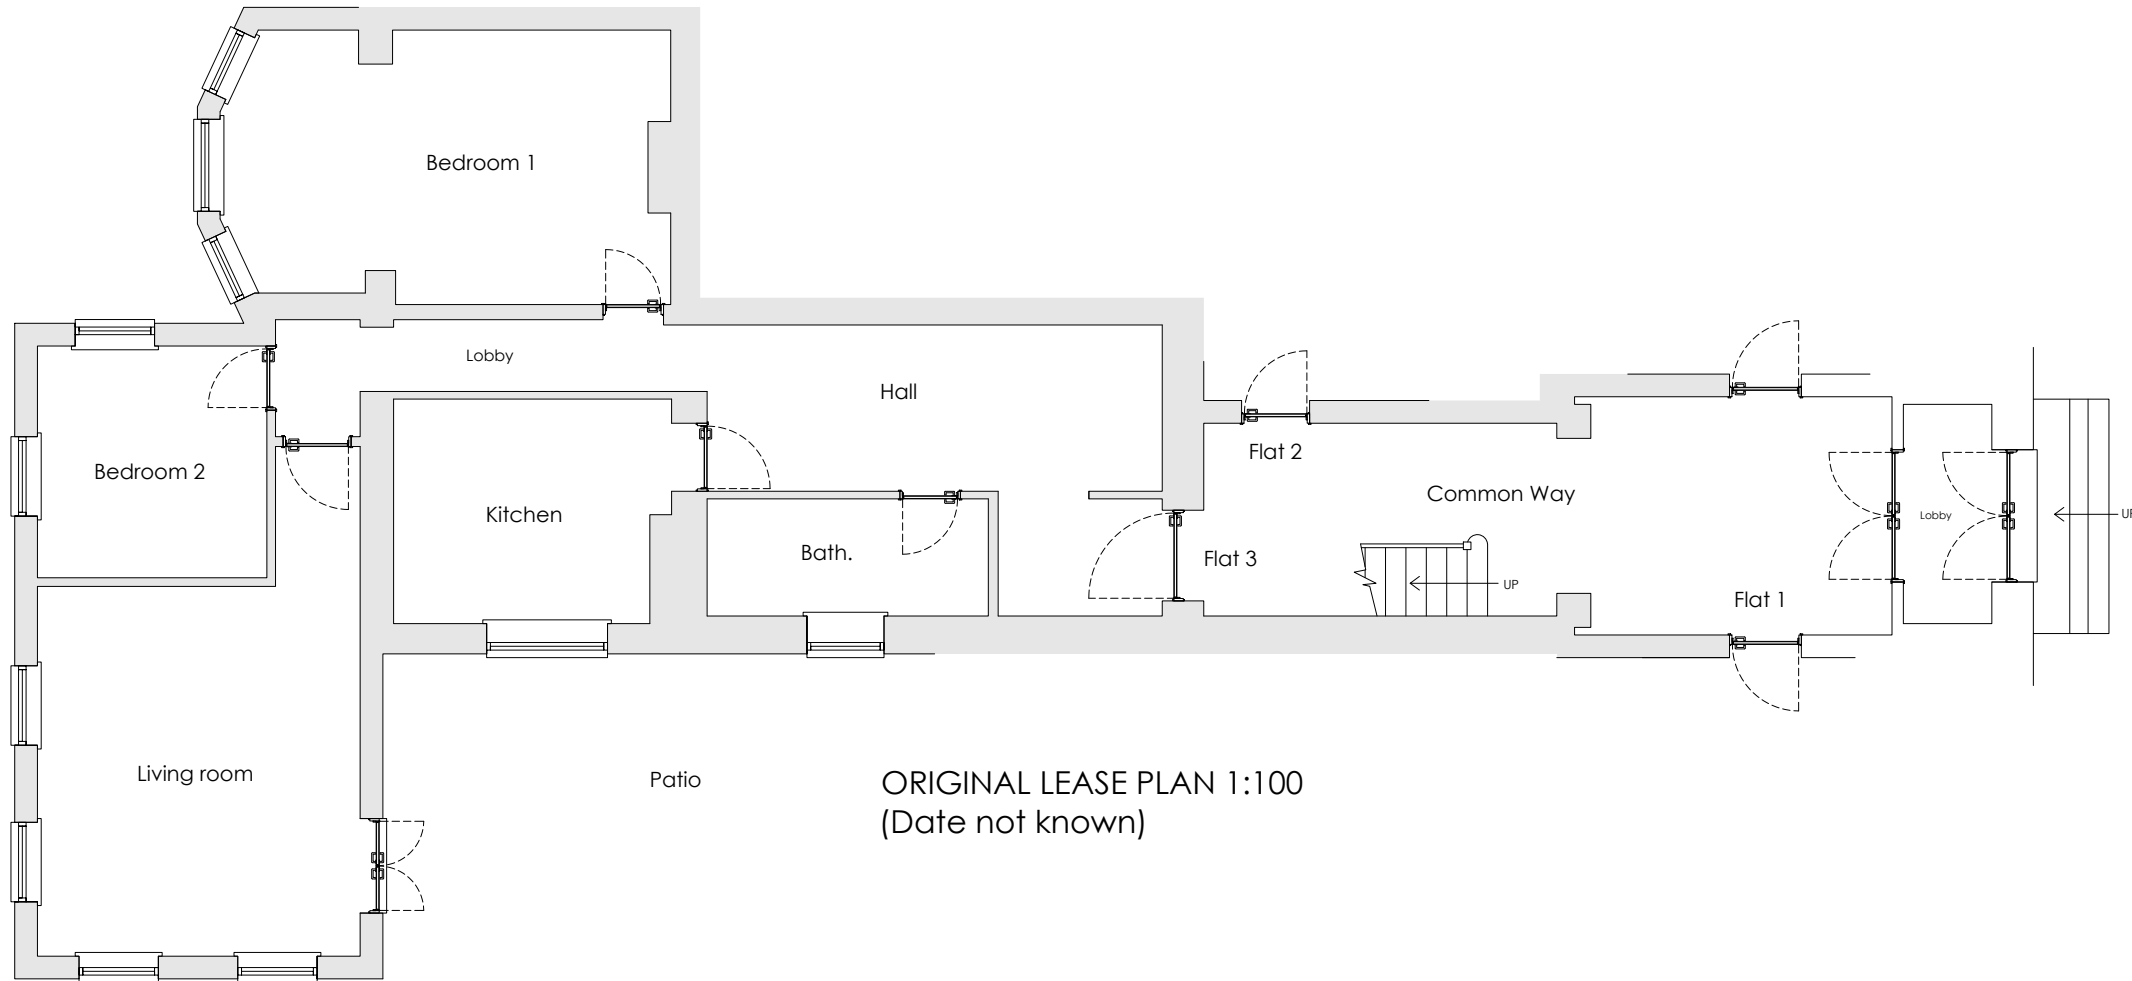

ORIGINAL LEASE PLAN 1:100
(Date not known)

Scale Bars:

1:1250 0m 10m 20m 30m 40m 50m

1:500 0m 5m 10m 15m 20m

1:200 0m 2m 4m 6m 8m

1:100 0m 1m 2m 3m 4m

0m 1m 2m
1:50

1:10 0 200 400

1:5 0 20 40 60 80 100 200

ama architectural &
quantity
surveying
services
atterbury moore associates

Unit 1 Gosling Croft Business Park
Long Furlong
Clapham Worthing
West Sussex BN13 3UT
01903 871131
carl@atterburymoore.co.uk

Client: Flat 3 Preston Hall

Address of Works:
The Street
East Preston
West Sussex
BN16 1HU

Drawing Title:

Paper Size: A3 Date: May. 2021

Job Number: AR-158 Drawing Number: 01 Revision: Revision

General Notes:
1: Do not scale from these drawings (unless for planning purposes).
2: Drawings to be read in conjunction with the structural calculations and the building notes provided.
3: The client/ contractor is advised to read the separate notes and the details provided in the structural calculations regarding the CDM regulations.
4: The property owner is reminded to serve a Party Wall Notice on any adjoining owner should they need to do so under the requirements of the Party Wall Act 1996.
5: No work should be undertaken until all consents (Planning and Building Control) have been received and approved in writing. Any work undertaken without consent is done so at the clients risk.
6: All dimensions to be checked on site prior to ordering any materials, kitchens or bathrooms.
7: All existing foundations and inlets taking any additional loads are to be exposed and agreed with the Building Control Officer.

Revision	Date	Amendment