




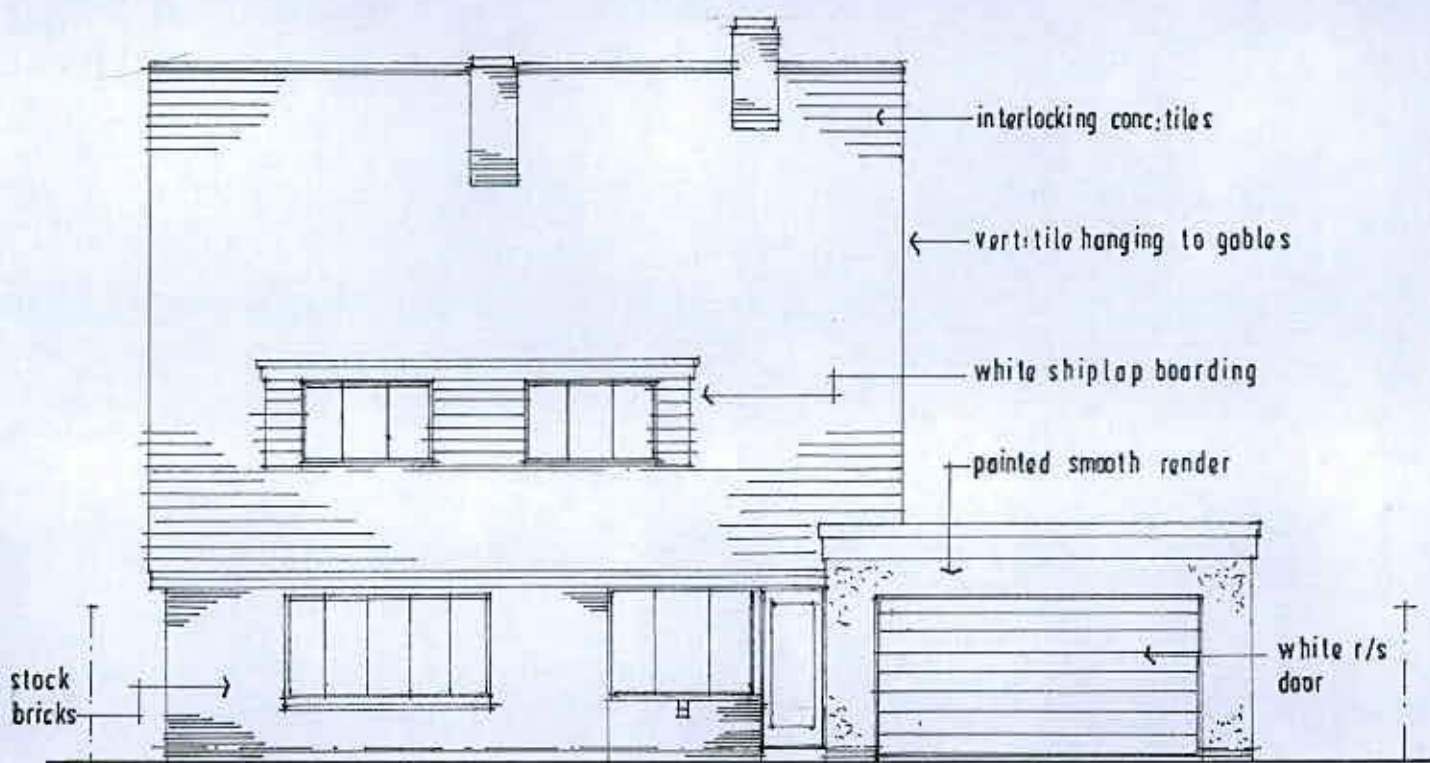

SOUTH [front] 1/100

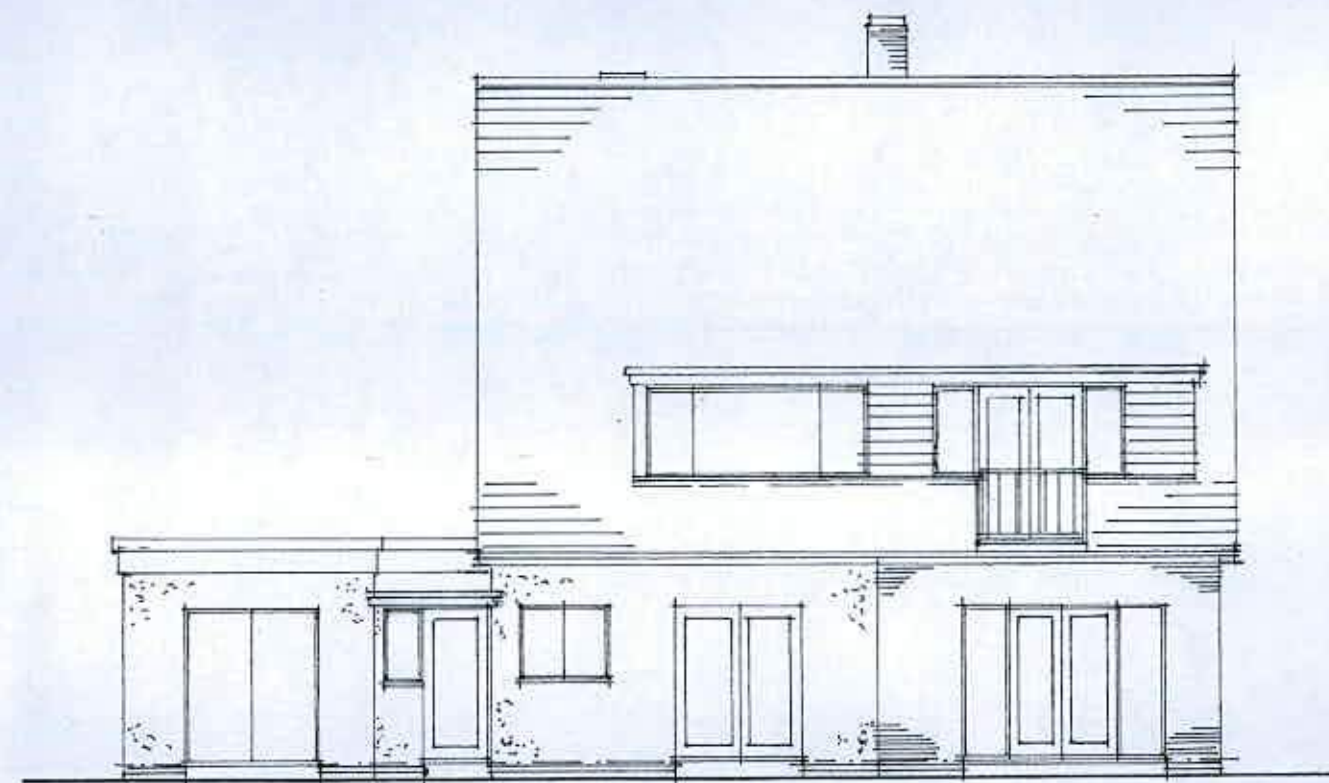

NORTH 1/100

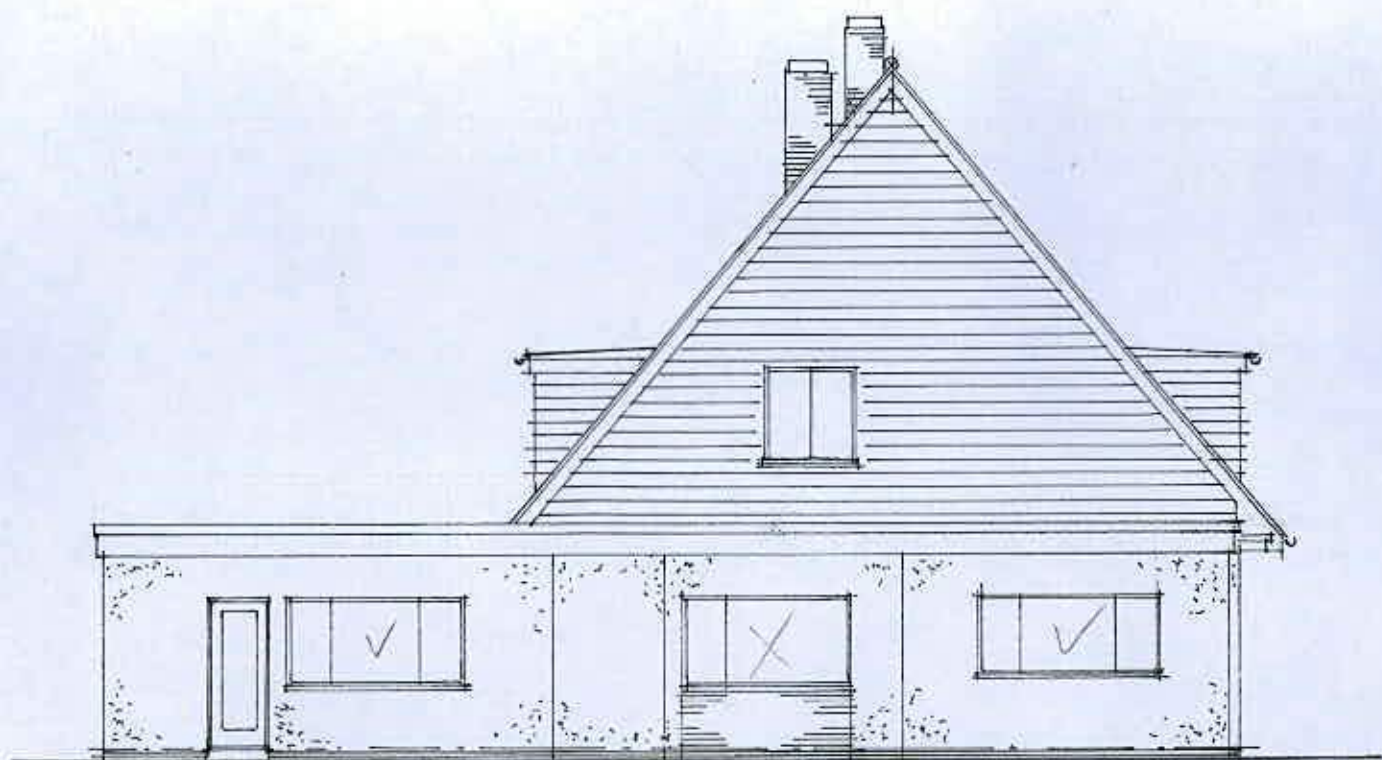

EAST 1/100

TREVOR E. UNSTED LTD

55-ST SEA LANE • RUSTINGTON • WEST SUSSEX • BN16 2RQ Tel: 01903 853690

Client: MR & MRS P. HARTLEY.

Project: EXTENSION / ALTERATIONS AT:
3; MICHEL GROVE, EAST PRESTON;
W/ SUSSEX; BN 16; 2SU.

Drawing: **EXISTING**

Scale: AS SHOWN

Drawing No.:

Date: FEB-2018

18 / 4513 / 3

Drawn: T.U.

Revisions:

Copyright:

The contractor must check all dimensions and levels on site and ~~no~~
~~dimensions are to be scaled from drawings.~~

It is the contractor's responsibility to ensure compliance with all statutory authority requirements, carry out works with total regard to existing and retained structure. Works and materials to latest CP/BS.

Drawing to be read in strict accordance with engineer's information where applicable.

All structural timber C16 unless otherwise noted. All structural and external timber pressure impregnated with preservative, cut ends site swabbed with Cuprinol or similar treatment.

Local authority to witness satisfactory test on all new and affected foul/storm drainage.