



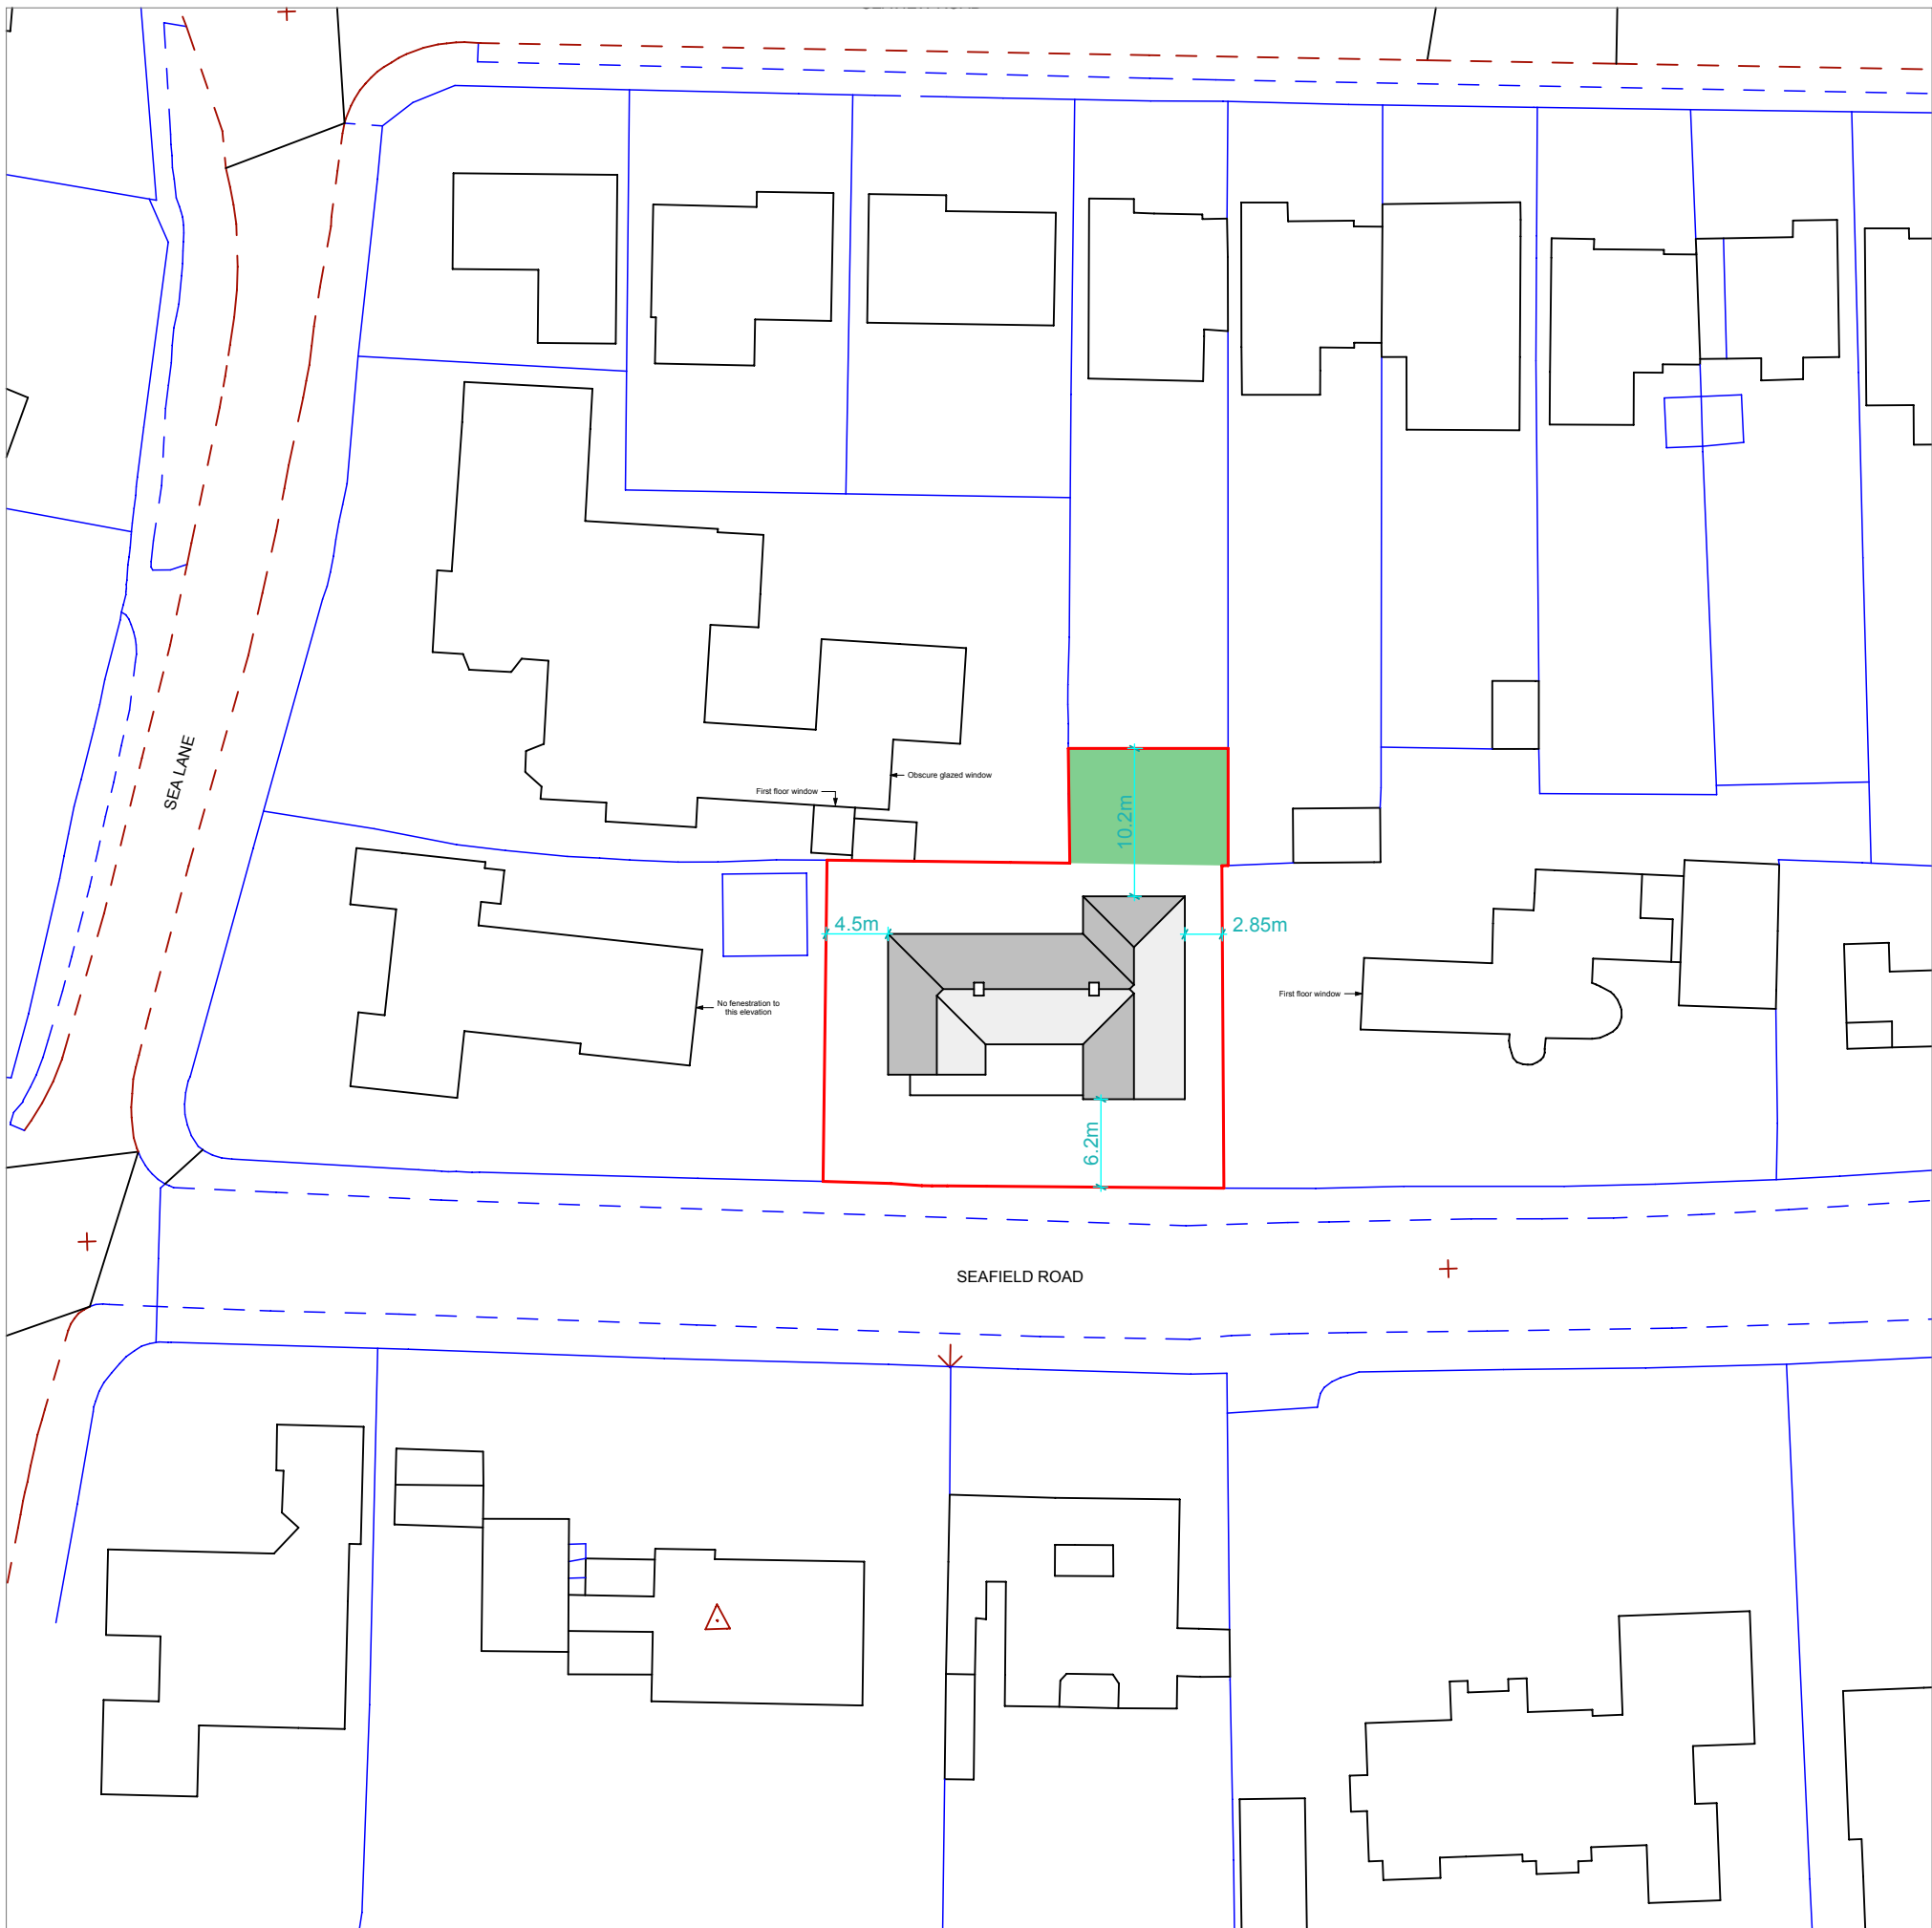

1:500 Block Plan

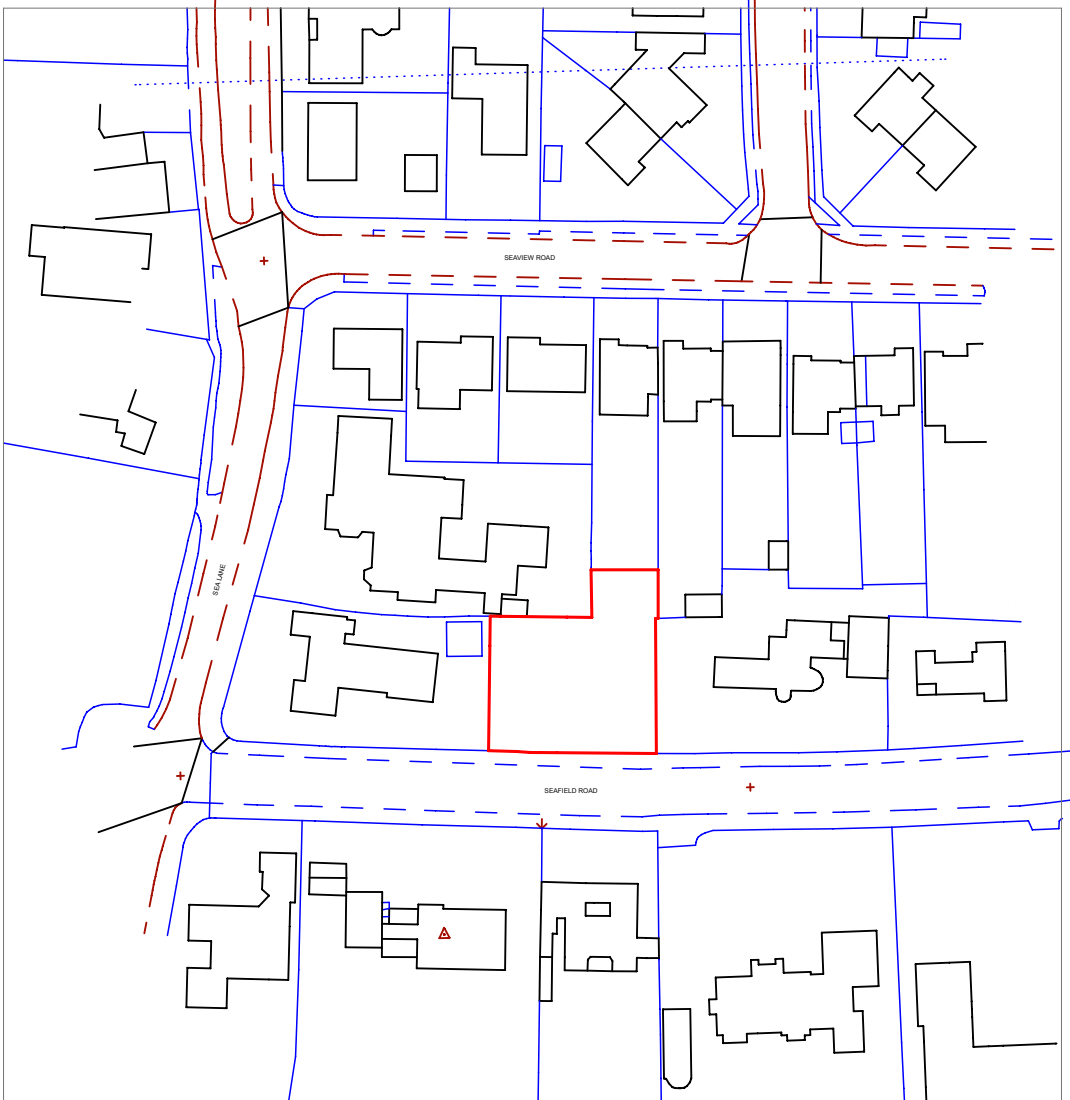

1:1250 Location Plan

Notes:

Red Line depicts outline of application site.

Hatched area depicts additional 89m2 of land acquired by the Applicant in August 2019.

Revisions:

A Oct 19 Additional land to Northeast of site acquired by Applicant in August 2019, added to plan.

This drawing is the property of Fuller Associates and is not to be copied reproduced, retained or disclosed to any unauthorised person either wholly or in part without prior consent. Do not scale from this drawing except for Planning purposes. Use all figured dimensions only. All figured dimensions to be checked on site prior to construction. All discrepancies, errors and omissions to be reported to Fuller Associates prior to construction. Layout and dimensions of existing building to be checked on site.

Chartered Surveyors • Architectural Design

**FULLER ASSOCIATES**

10 - 11 The Parade, Willowhayne Crescent,  
East Preston, West Sussex, BN16 1NS  
tel: 01903 8774754  
email: [architectural@fuller-associates.co.uk](mailto:architectural@fuller-associates.co.uk)  
[www.fuller-associates.co.uk](http://www.fuller-associates.co.uk)

Job Title  
**Seahaven, Seafeld Road,  
East Preston**

Client  
**Mr & Mrs D Guise**

Drawing Name  
**Location & Block Plans**

Drawing Status  
**Planning**

Drawn by **DF** Date **June 19**

Checked by Date

Drawing Scale  
**1:500 & 1:1250 at A2**

Drawing No **193008/ 04** Status Revision **A**