




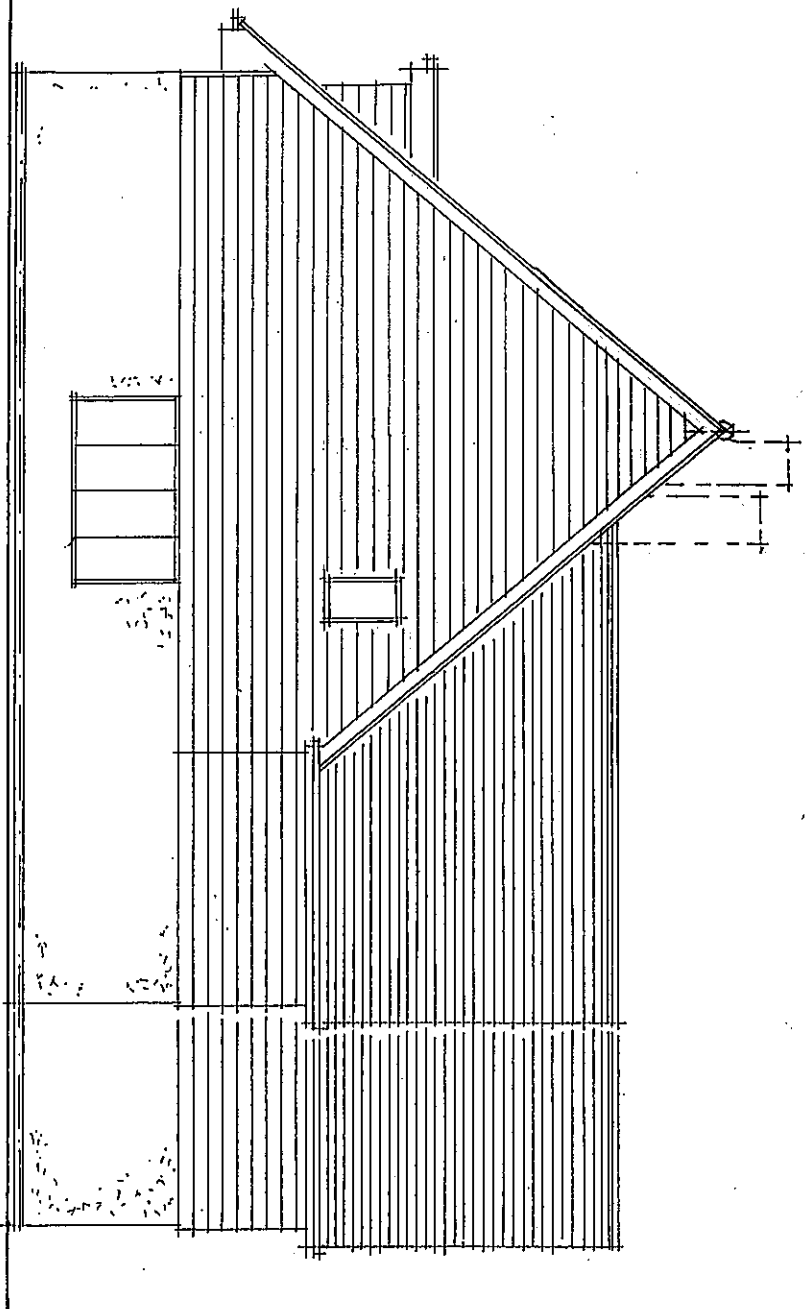

WEST 1/100

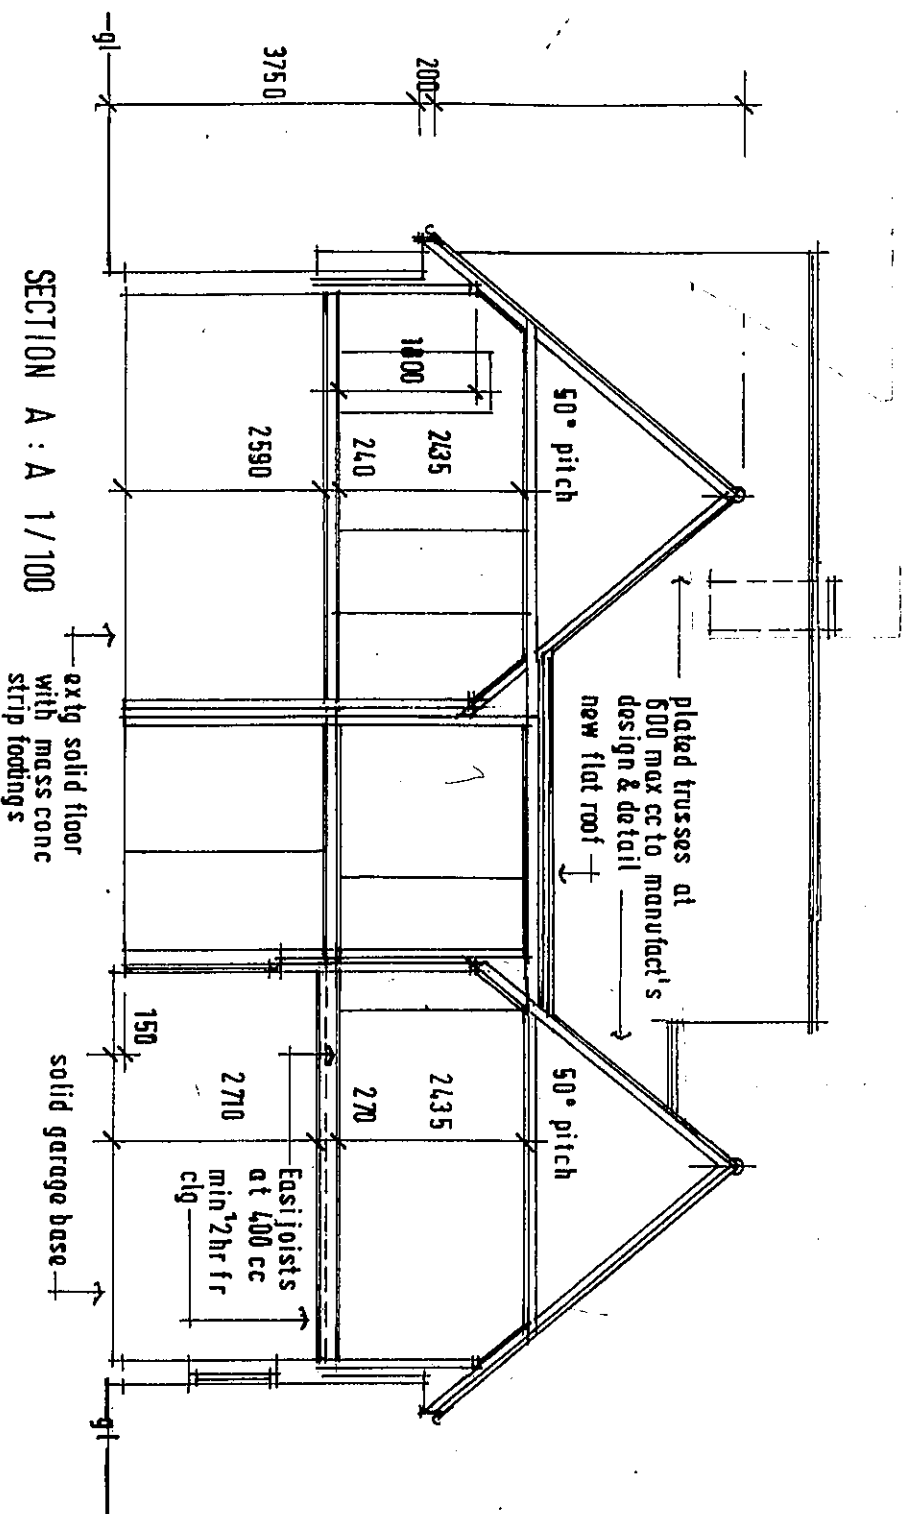

SECTION A : A 1/100

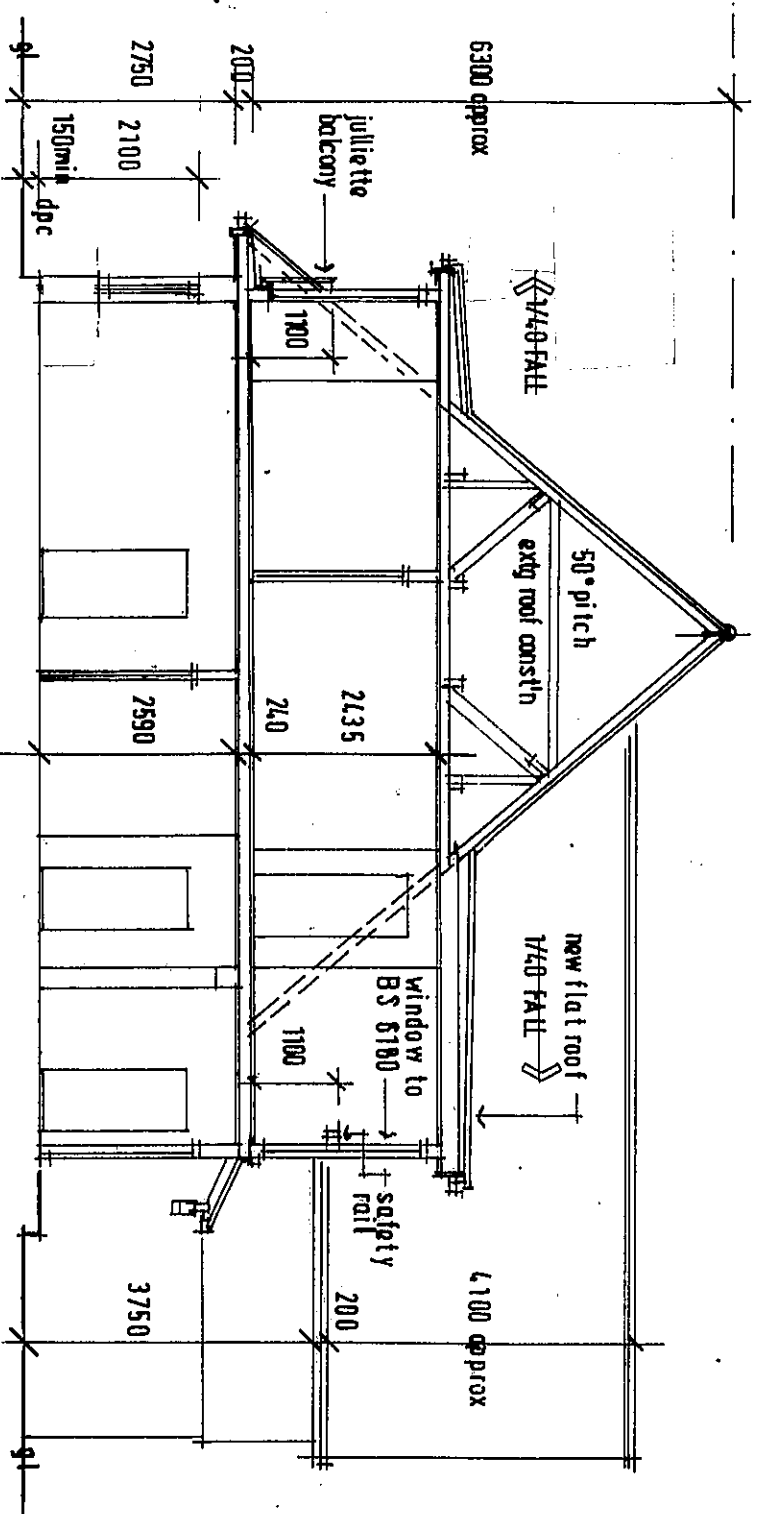

SECTION B : B 1/100

- REVISIONS**
- A. 21.6.22 general updating
 - B. 30.8.26 as built revisions

TREVOR E. UNSTED

55-57 SEA LAKE • RUSTINGTON • WEST SUSSEX • BN16 2RD Tel: 07486030547

Client: **MR & MRS P. HARTLEY.**

Project: **EXTENSION/ALTERATION AT:
3, MICHEL GROVE, EAST PRESTON,
W/ SUSSEX. BN16 2SU**

Drawing: **PROPOSED**

Scale: **A5 SHOWN** Drawing No.:

Date: **FEB 2018**

18/4513/17

Drawn: **lu.**

Revisions:

Copyright: **lu.**

Revisions:

A 8

The contractor must check all dimensions and levels on site and no dimensions are to be scaled from drawings.
It is the contractor's responsibility to ensure compliance with all statutory authority requirements, carry out works with total regard to existing and retained structure. Works and materials to latest CPBS.
Drawing to be read in strict accordance with engineer's information where applicable.
All structural timber: C16 unless otherwise noted. All structural and external timber pressure impregnated with preservative, cut ends site swabbed with Cupinol or similar treatment.
Local authority to witness satisfactory test on all new and affected foulstorm drainage.