


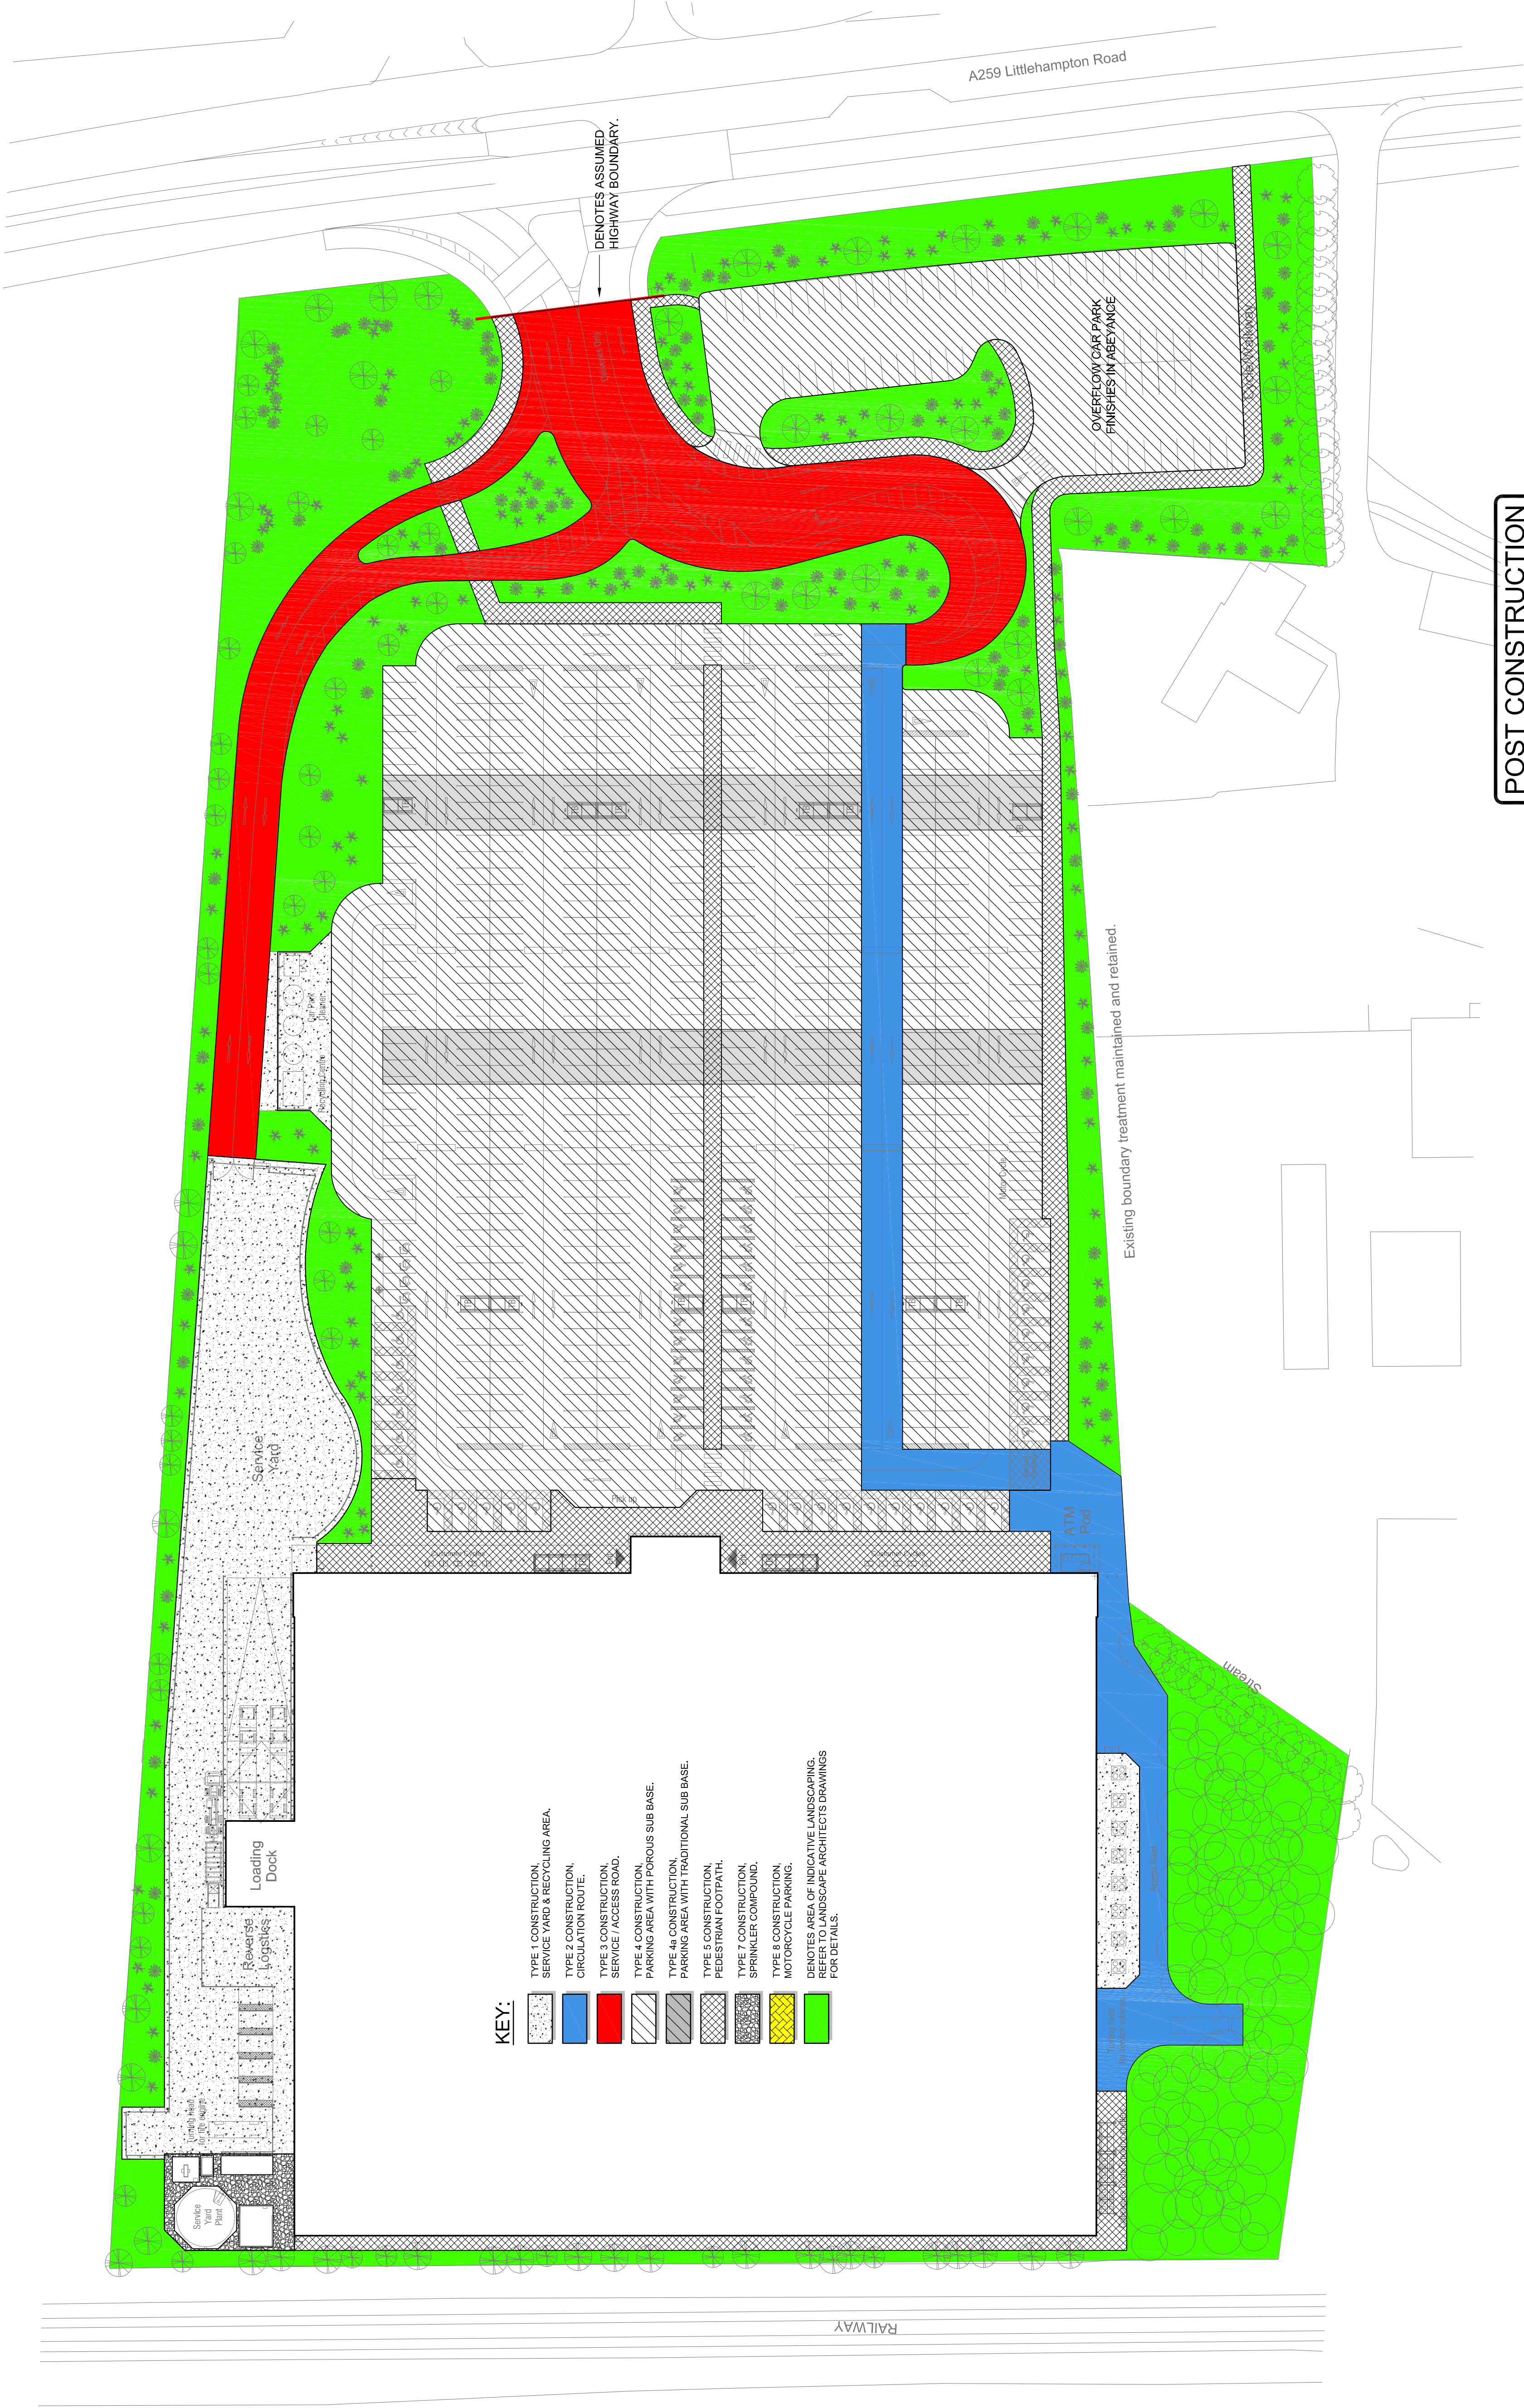

POST CONSTRUCTION
DRAWING

AS BUILT INFORMATION PROVIDED BY CONTRACTOR
AND INCORPORATED INTO DESIGN DRAWINGS.

- General Notes:
- DO NOT SCALE THIS DRAWING.
 - THIS DRAWING IS TO BE READ IN CONJUNCTION WITH ALL RELEVANT DRAWINGS, SPECIFICATIONS, SCHEDULES AND SPECIFICATIONS.
 - NO USER AND USERS ARE TO BE USED WITHIN EXTERNAL AREAS OTHER THAN TO PERMITS.
 - REFER TO ARCHITECTS DRAWINGS FOR EXTERNAL LEVELS.
 - REFER TO ARCHITECTS DRAWINGS FOR POSITIONS OF CAR PARK MARKINGS AND FURNITURE.

Rev.	Date	By	Chk'd	Rev.	Date	By	Chk'd
X	28.08.12	AK	CM	PHT	07.03.12	RG	PHT
-	07.03.12	RG	PHT	07.03.12	RG	PHT	07.03.12
T	12.11.11	RG	SG	12.11.11	RG	SG	12.11.11
T	12.11.11	RG	SG	12.11.11	RG	SG	12.11.11
P1	17.10.11	RG	SG	17.10.11	RG	SG	17.10.11
P	05.10.11	RG	SG	05.10.11	RG	SG	05.10.11

Revision Notes:

ISSUED FOR INFORMATION

POST CONSTRUCTION ISSUE

ISSUED FOR CONSTRUCTION

LAYOUT UPDATED TO REFLECT ARCHITECTS DRAWING APPROV. BY Rev. B.

TENDER ISSUE

INDICATIVE LANDSCAPED AREAS ADDED.

REVISED TO REFLECT ARCHITECTS DRAWINGS

REMOVED TO CAR PARK SPECIFICATION FRONT ENTRANCE PAVING REPLACED WITH TERRAZZO

POST CONSTRUCTION ISSUE

ISSUED FOR INFORMATION

Project:	Client:
FERRING	ASDA part of the WAL-MART family

Drawing:	Client:
EXTERNAL WORKS, PAVING CONSTRUCTION LAYOUT.	GDP Consulting Engineers The Old Mill, Littlehampton, Kent, DA14 3JZ Tel: 01473 662323 Email: enquiries@gdpem.co.uk

Scale:	at A1	Date:	Checked:	Drawn:	Rev:
1:500	at A1	Oct '11	SG	RG	X