

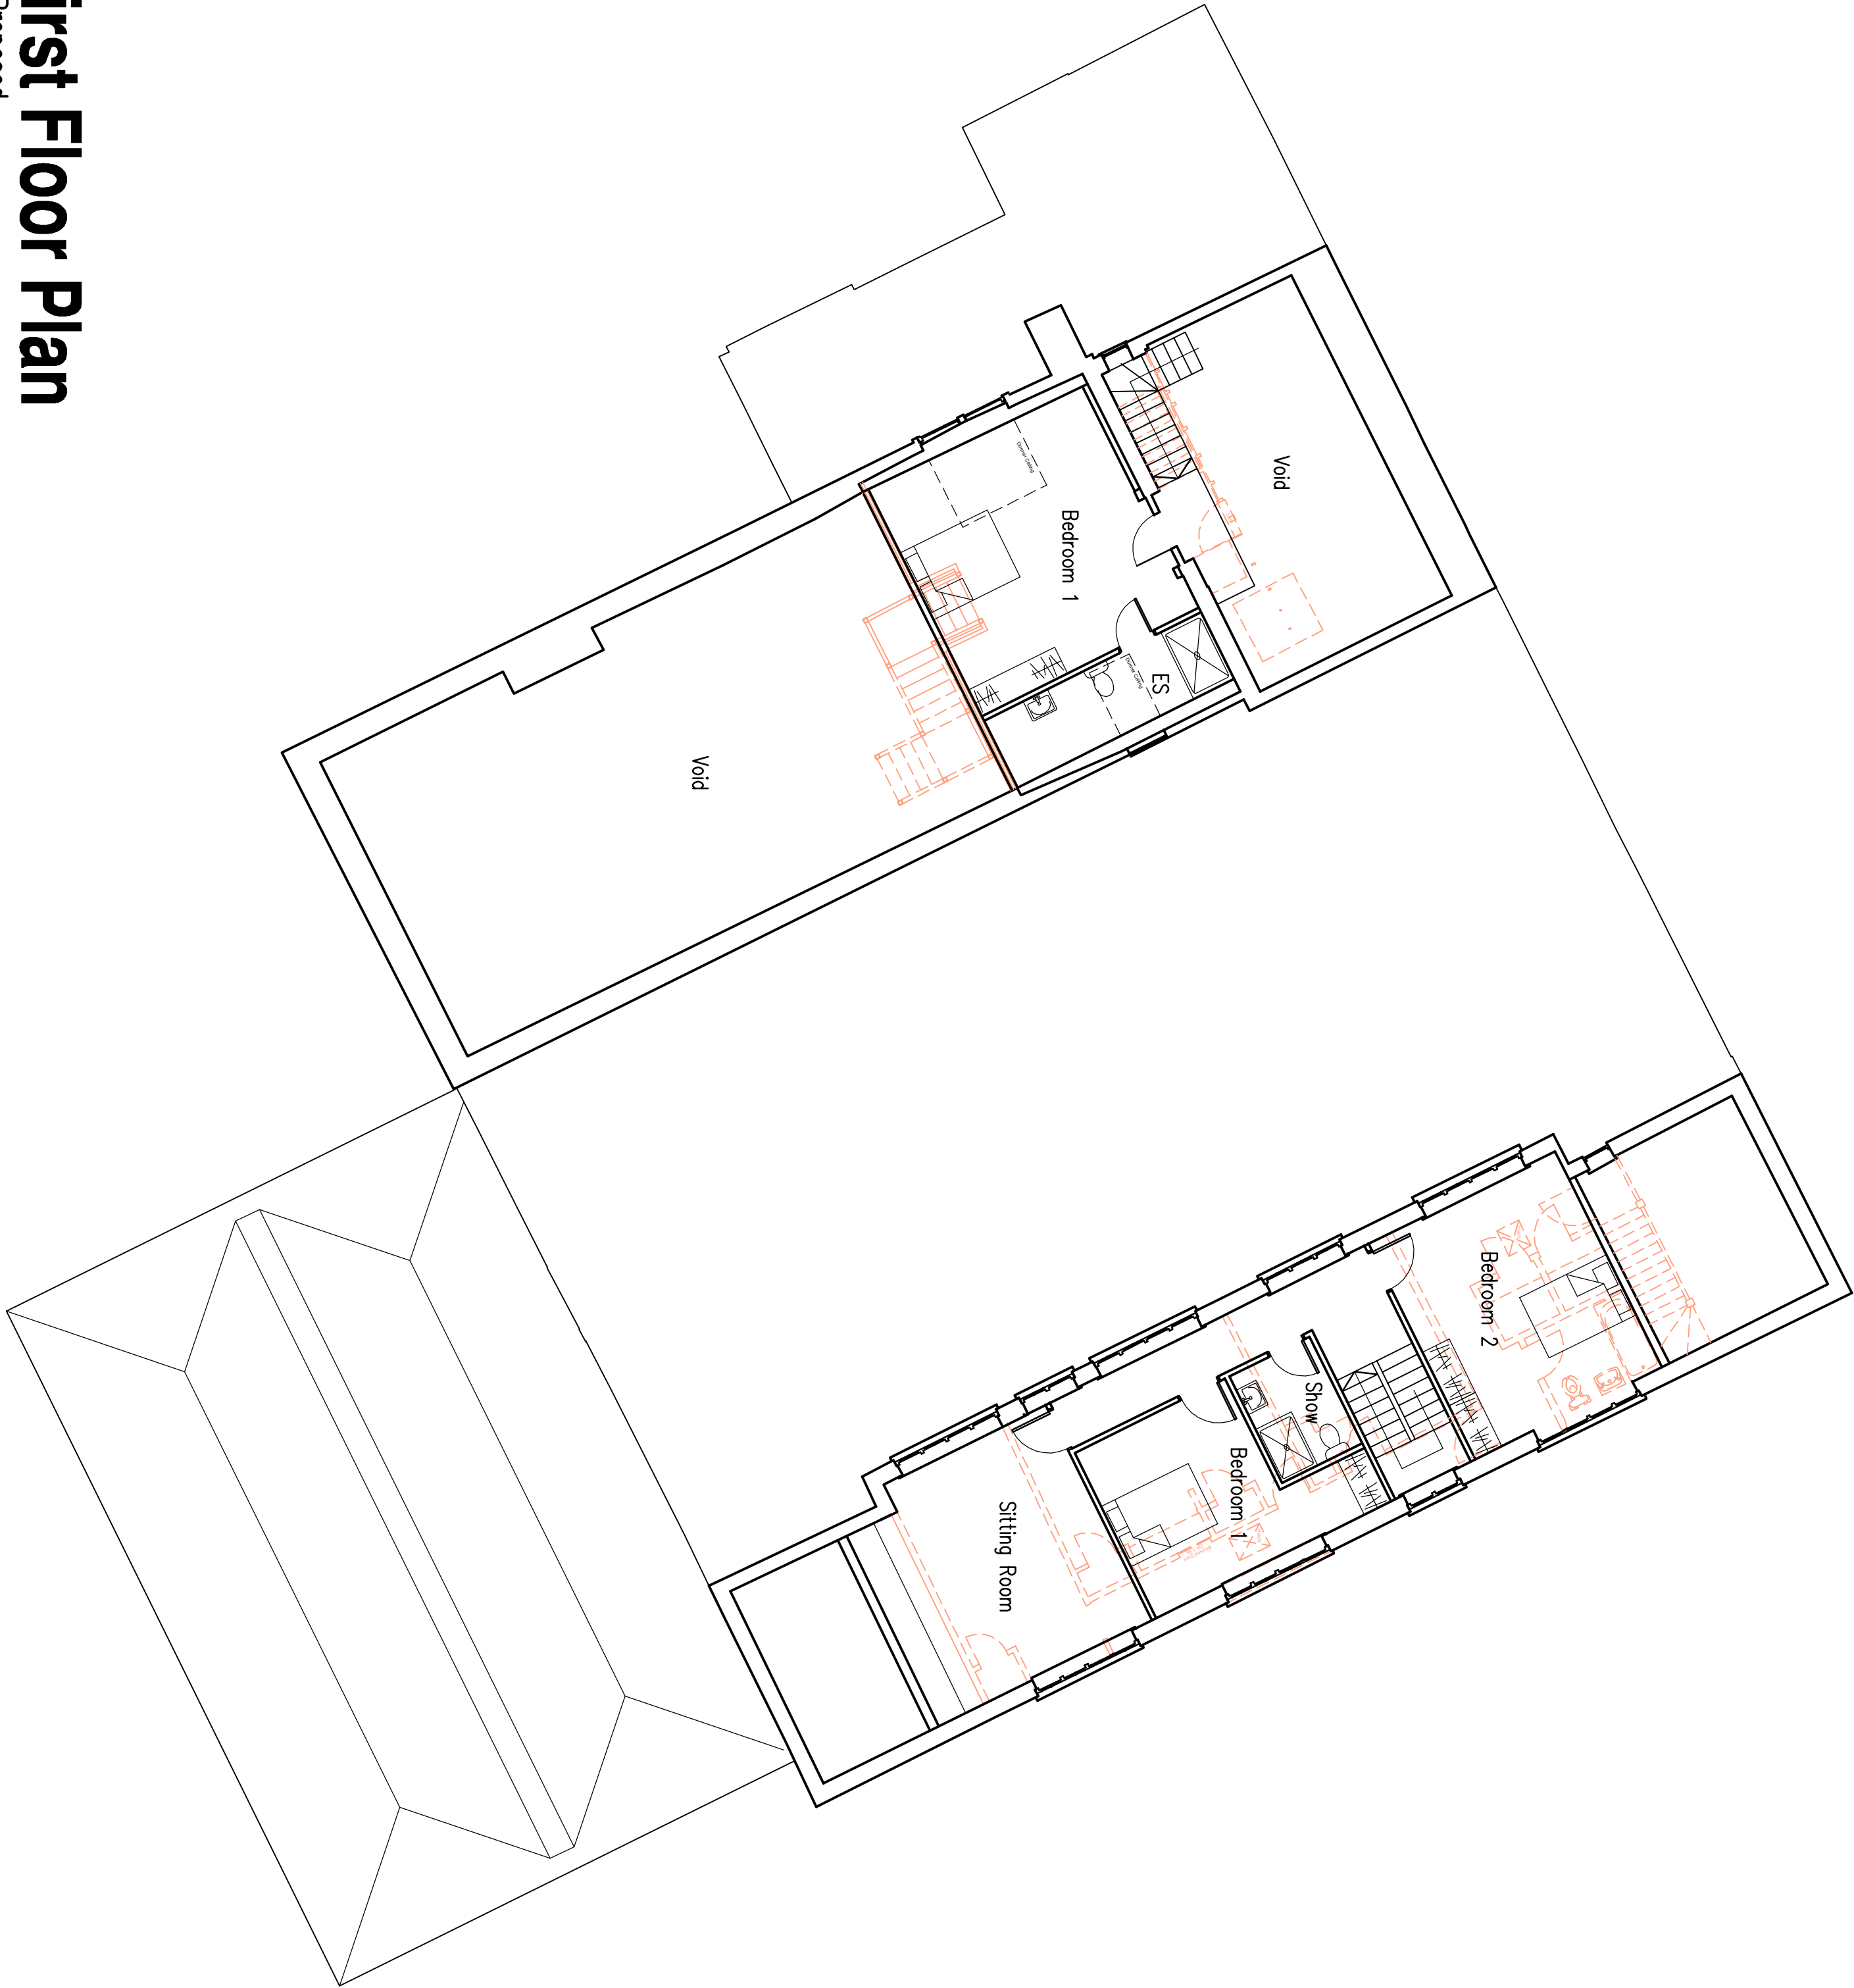


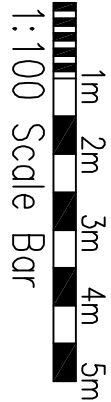

First Floor Plan
As Proposed
1:100

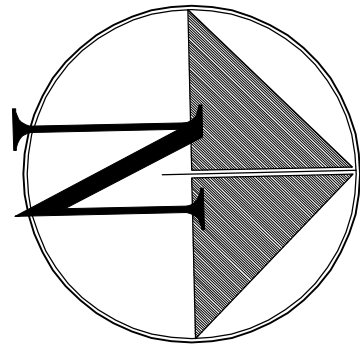

17 Sept 2020 | Redline to units 8 & 9 amended
14 Jan 2020 | Amended to consultant comments

Project:
**Proposed Conversion of:
The Tudor Rose
Ferringham Lane
Ferring**

Drawing Title:
**First Floor Plan
As Proposed**

Client:

Copyright of:
Olive Voller Associates
Chartered Building Surveyors
Garden Cottage
Farm Lane
Ditchling
BN6 8UN
Tel: 01444 877010
Fax: 01444 870099
Web: www.olivevoller.com



Scale:
1:100 @ A1

Date:
Nov 2019

Drawn:

Dwg. No.

3932-C2

Rev'n
B