

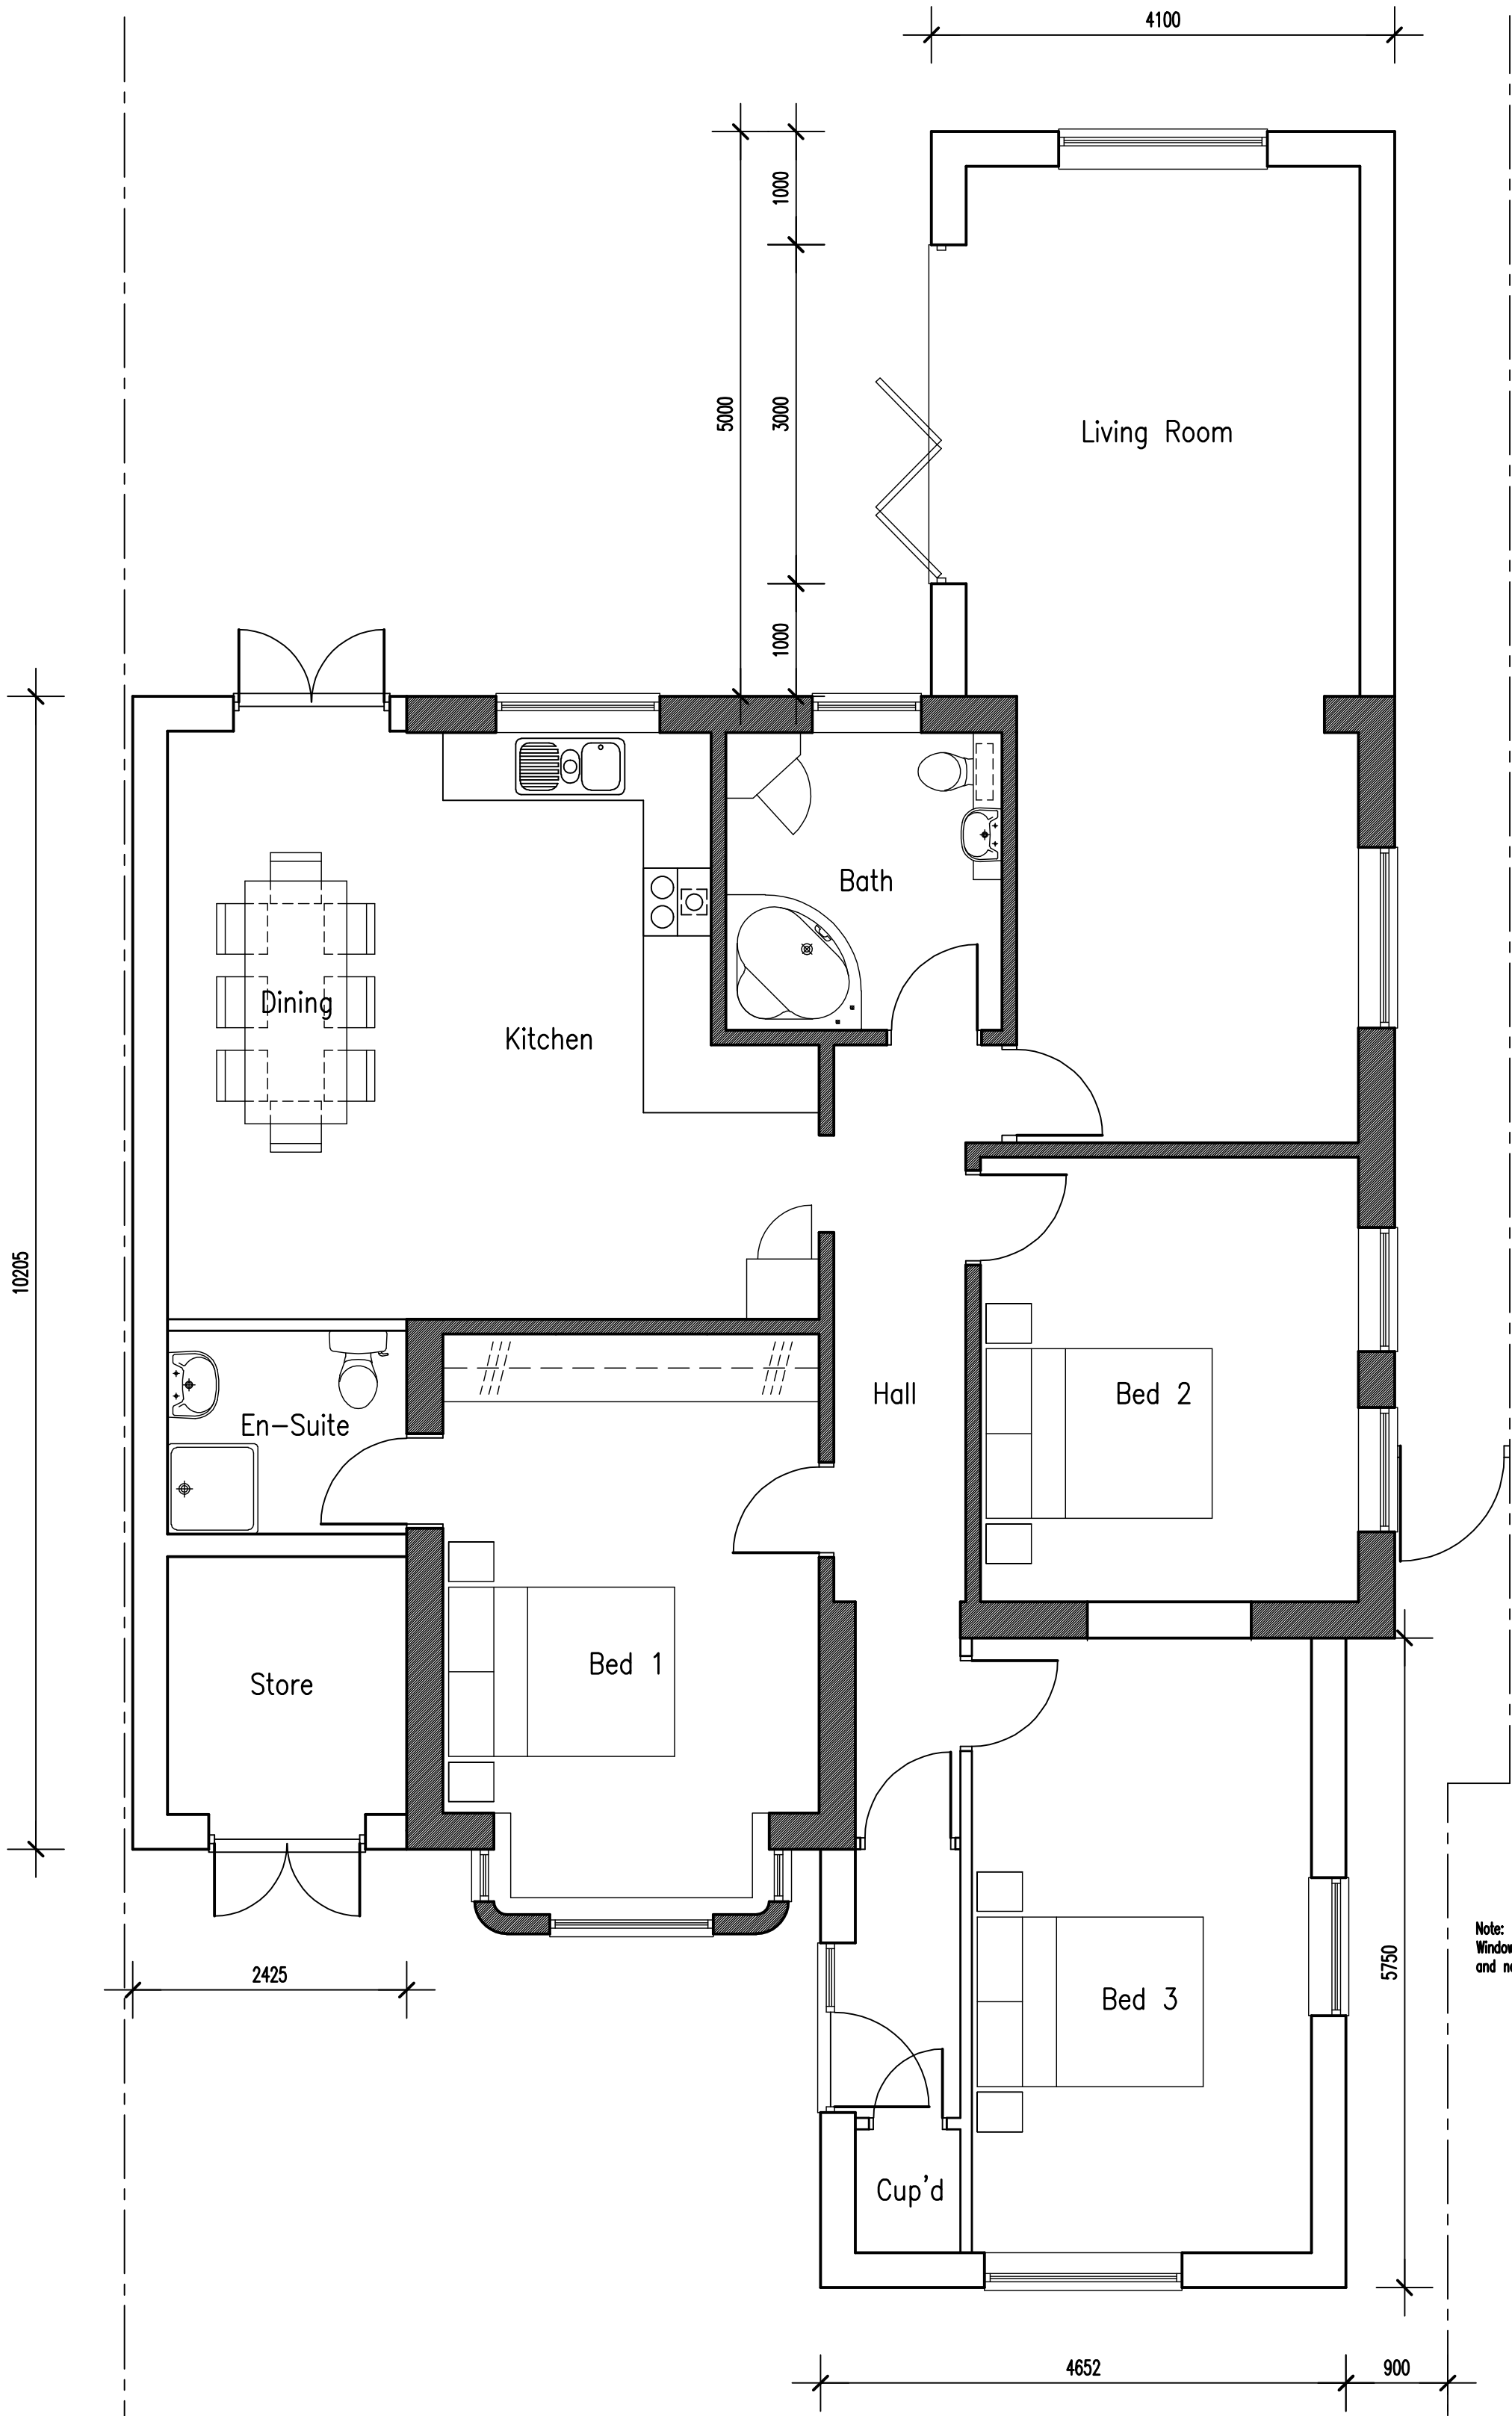


The contractor should check all dimensions on site.
It is the contractors responsibility to ensure compliance with Building Regulations.
C.D.M. Regs. 2007. The Client is advised of his responsibilities to appoint a Planning Supervisor under these Regs.
All works to comply with the C.D.M. Regs. 2007.
The Party Wall Act. 1996 The property owner is advised of the requirements of the Act, & the requirement to serve a Party Wall Notice on any adjoining owners as required under the act.


- REVISIONS:
- A. 31.05.17 Amended in accordance with client's comments.
 - B. 30.07.17 Amended in accordance with client's comments.
 - C. 31.07.17 Amended in accordance with client's comments.
 - D. 10.08.18 Windows and doors amended to suit as built.
 - E. 18.07.18 Windows amended to North Elevation.

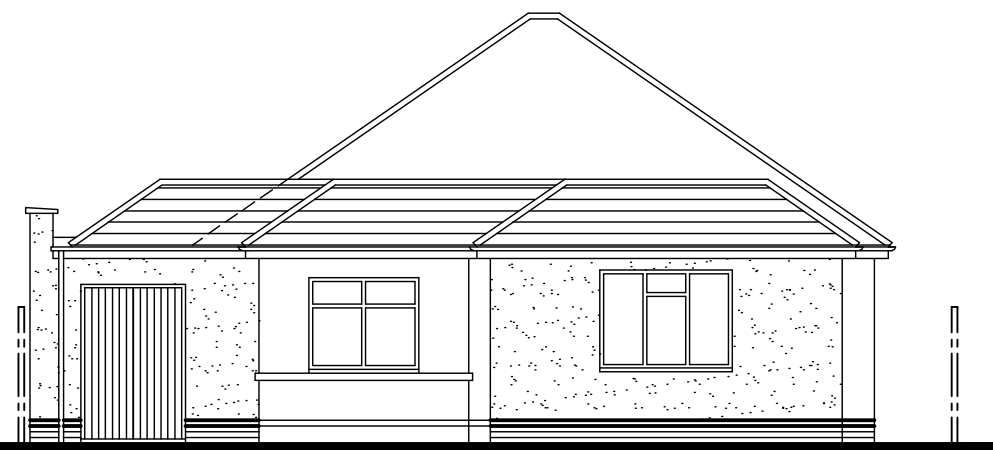

PROPOSED GROUND FLOOR PLAN
Scale 1:50

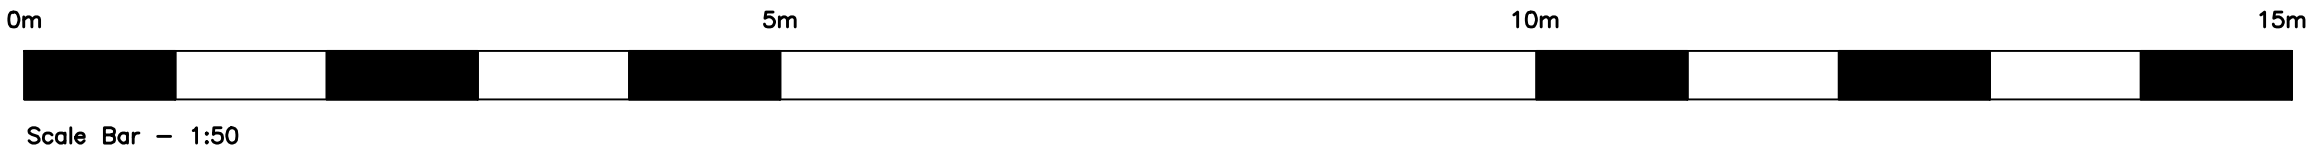

FRONT
PROPOSED ELEVATIONS
Scale 1:100

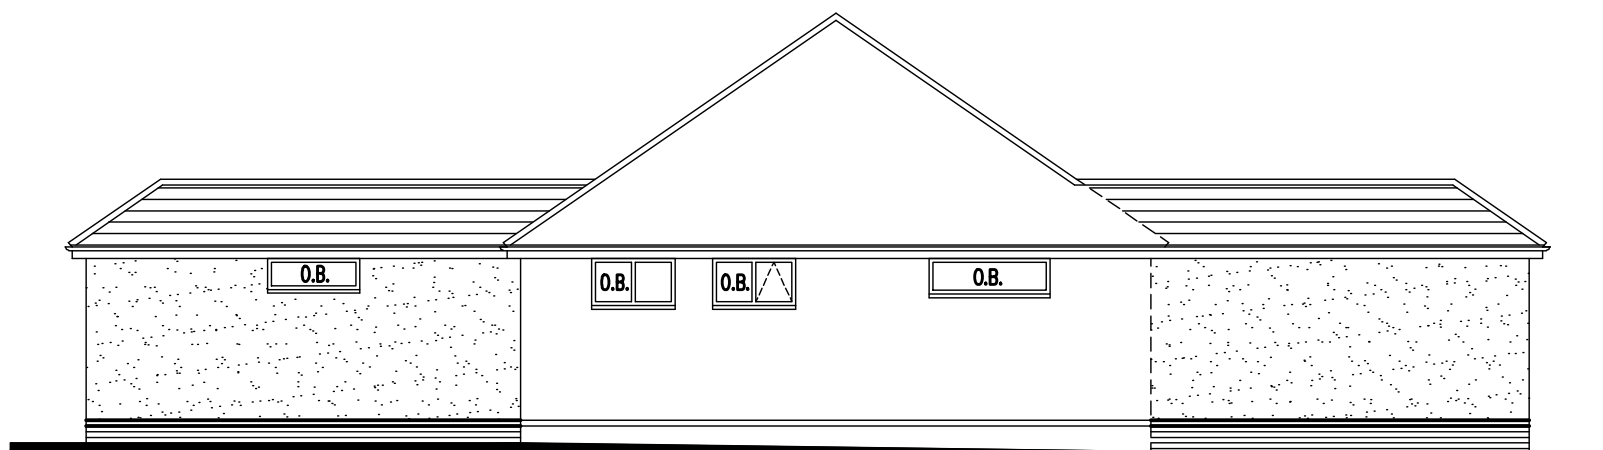


O.B. = Obscure Glazing
SIDE


SCHEDULE OF MATERIALS
WALLS - NEW RENDER TO MATCH EXISTING WITH BRICK PLINTH TO MATCH EXISTING
ROOF - NEW PLAIN TILES TO MATCH EXISTING
WINDOW - NEW UPVC WINDOW COLOUR WHITE
BI-FOLDING DOORS - NEW ALUMINIUM COLOUR WHITE
RAINWATER GOODS - NEW UPVC COLOUR WHITE




REAR

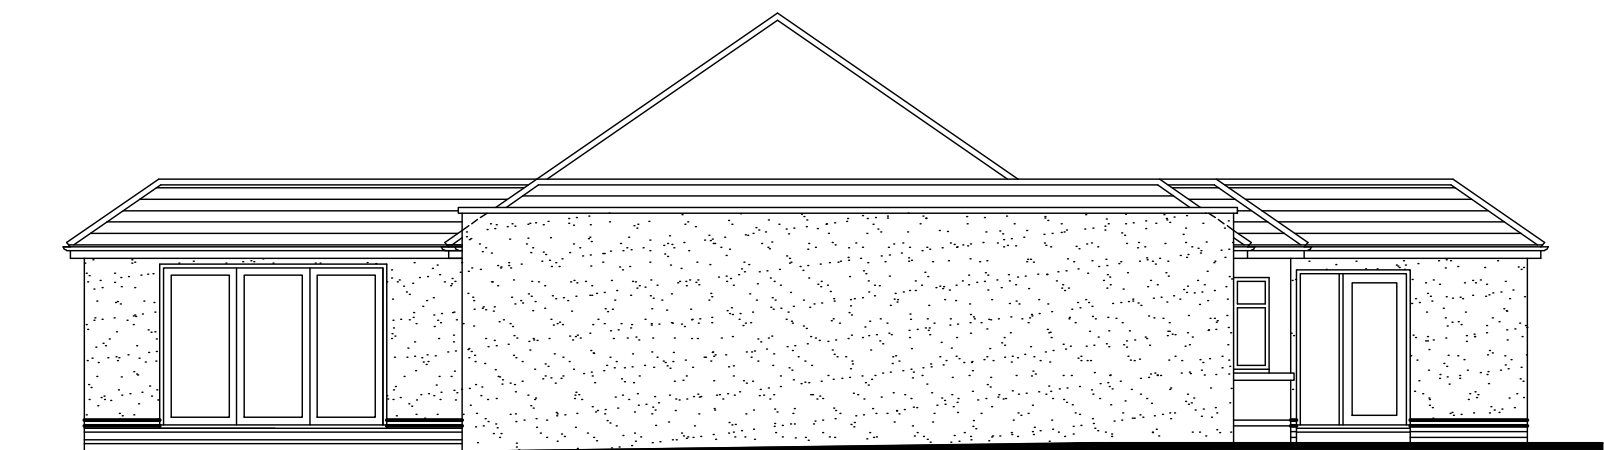

SIDE

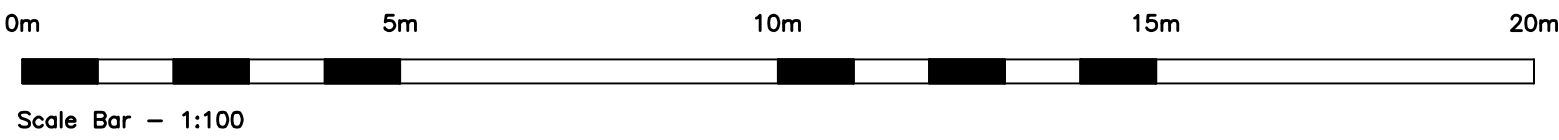

TYPICAL SECTION
Scale 1:50

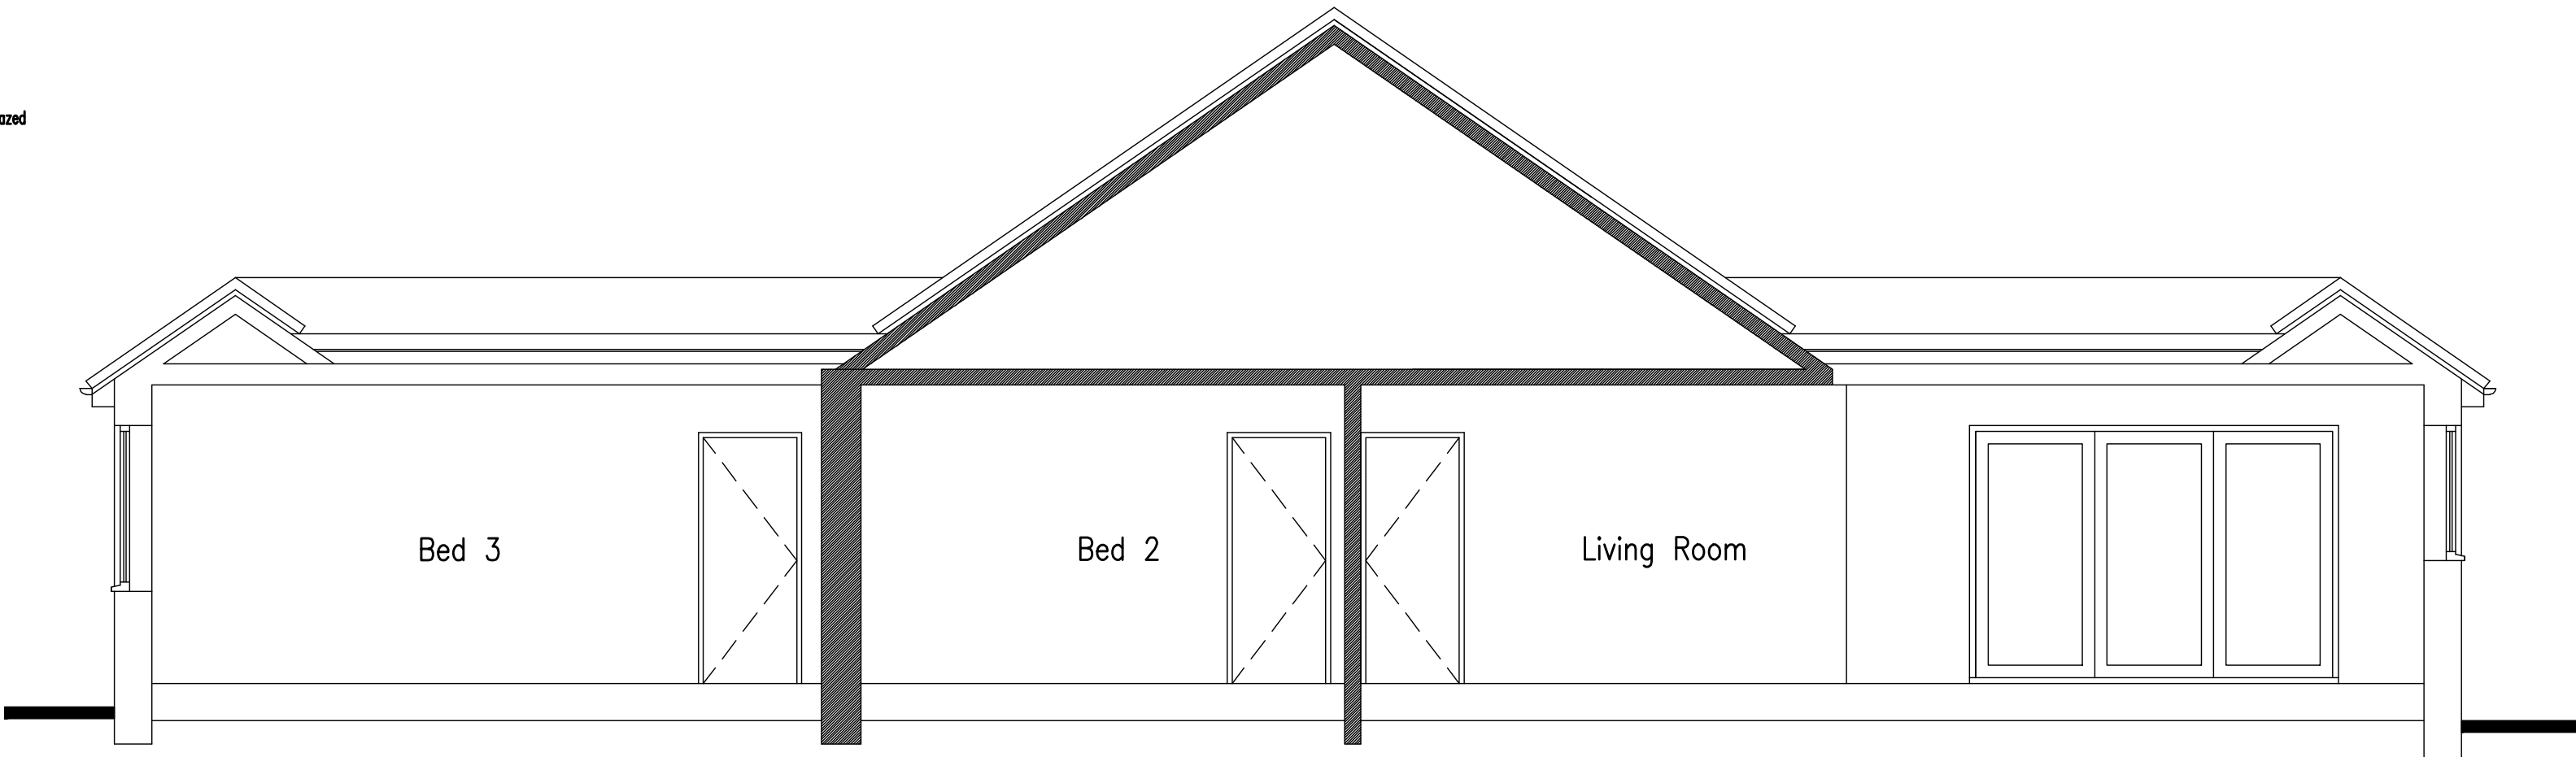

ADCS

30 Foxley Lane
Worthing
West Sussex
BN13 3AC
Tel: 01903 280701
E-mail
adcs@sky.com

Client		
MR M. & MRS S. HARMSWORTH		
Project		
PROPOSED EXTENSIONS 25 UPPER WEST DRIVE FERRING WEST SUSSEX BN12 5RG		
Drawing		
PROPOSED FLOOR PLANS & ELEVATIONS		
Scale	Date	Drawn
1:50 & 1:100 @ A1	17.05.17	TP
Drawing No.		Revision
1336/P02		E