




Location Plan
1:1250

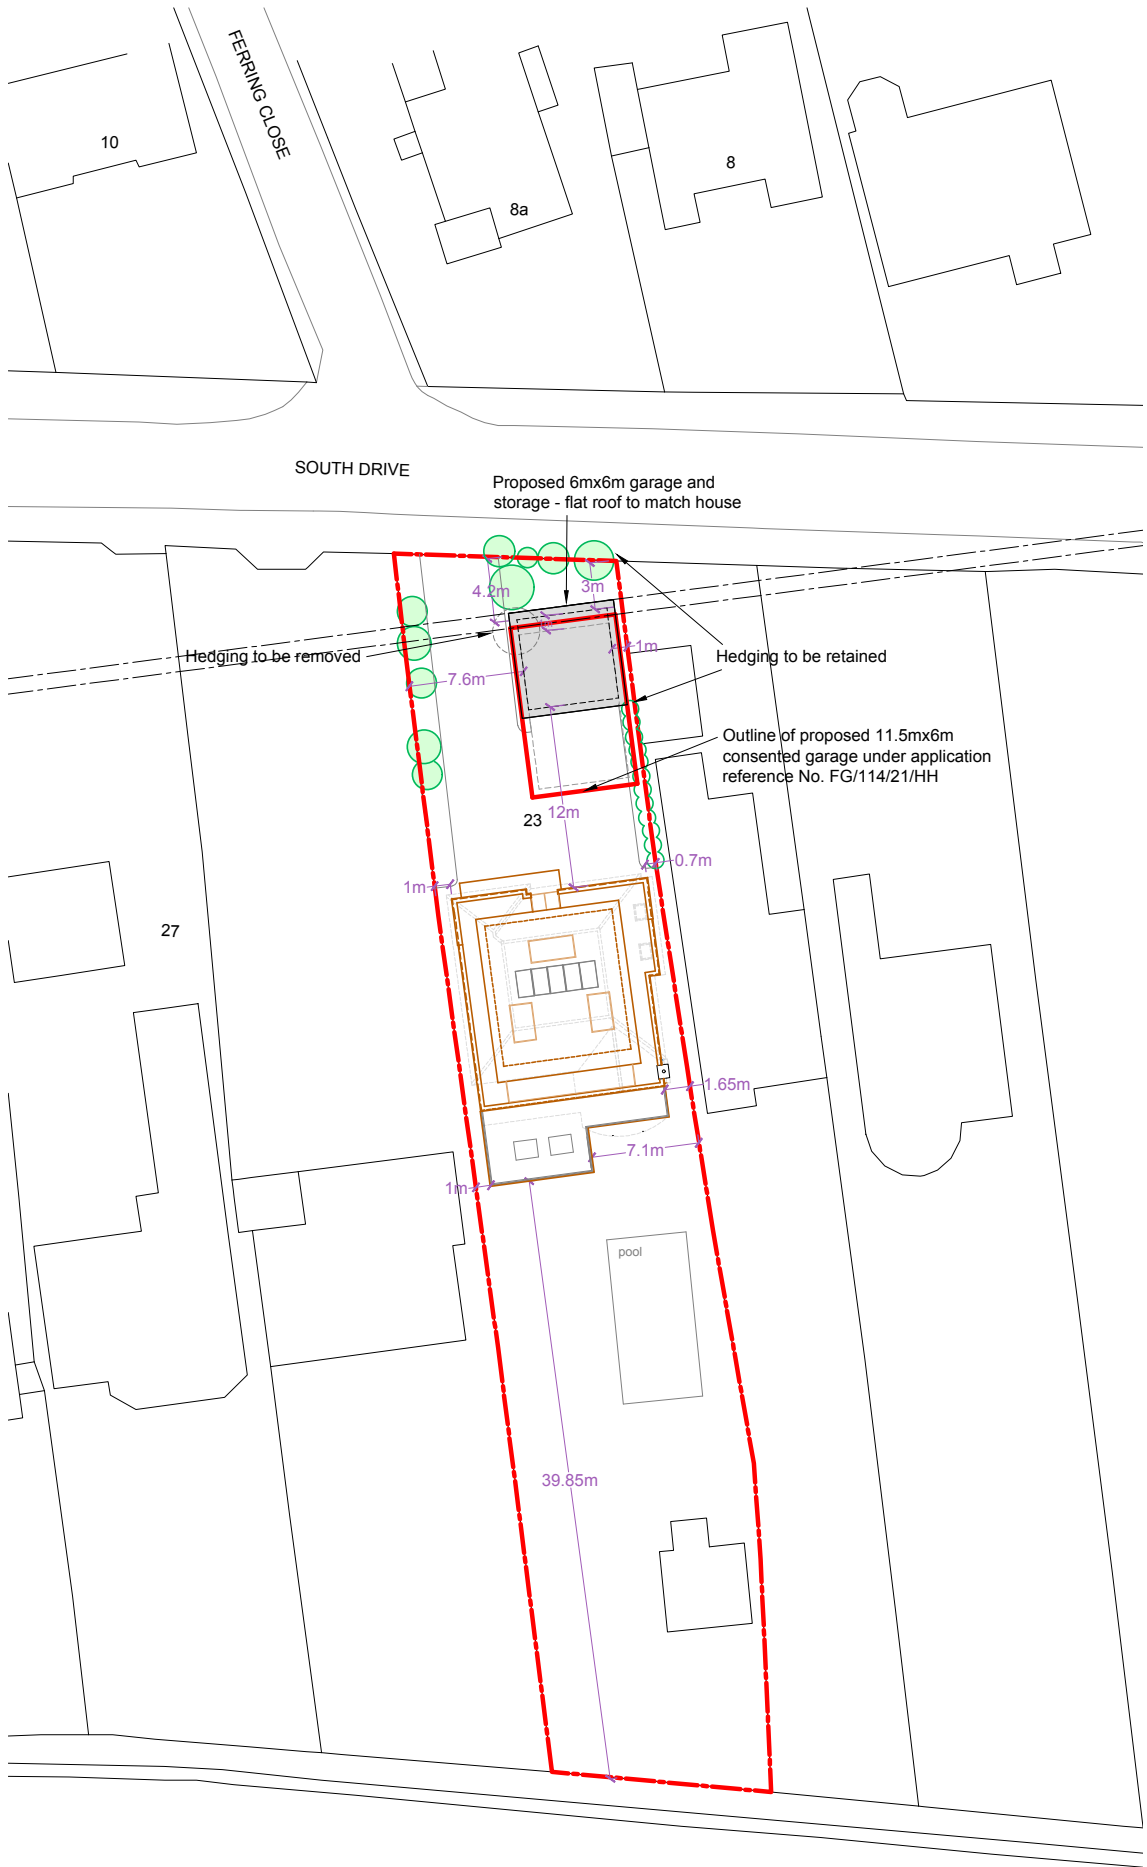

Block Plan
1:500

Red line depicts boundary of application site

Light grey dashed lines depict structure to be removed

Revisions:

A Feb 22 Amended garage size to 6mx6m and location.

This drawing is the property of Fuller Associates and is not to be copied reproduced, retained or disclosed to any unauthorised person either wholly or in part without prior consent. Do not scale from this drawing except for Planning purposes. Use all figured dimensions only. All figured dimensions to be checked on site prior to construction. All discrepancies, errors and omissions to be reported to Fuller Associates prior to construction. Layout and dimensions existing building to be checked on site.

Chartered Surveyors • Architectural Design

FULLER
ASSOCIATES

10-11 The Parade, Willowhayne Crescent,
East Preston, West Sussex BN16 1NS

tel: 01903 774754

email: architectural@fuller-associates.co.uk
www.fuller-associates.co.uk

Job Title

23 South Drive, Ferring

Client

Mr & Mrs Adam

Drawing Name

Location and Block Plans

Drawing Status

Planning

Drawn by BF

Date Feb 22

Checked by SS

Date Mar 22

Drawing Scale

1:1250, 1:500 at A3

Drawing No

Status

Revision

203140/ 07

A

