
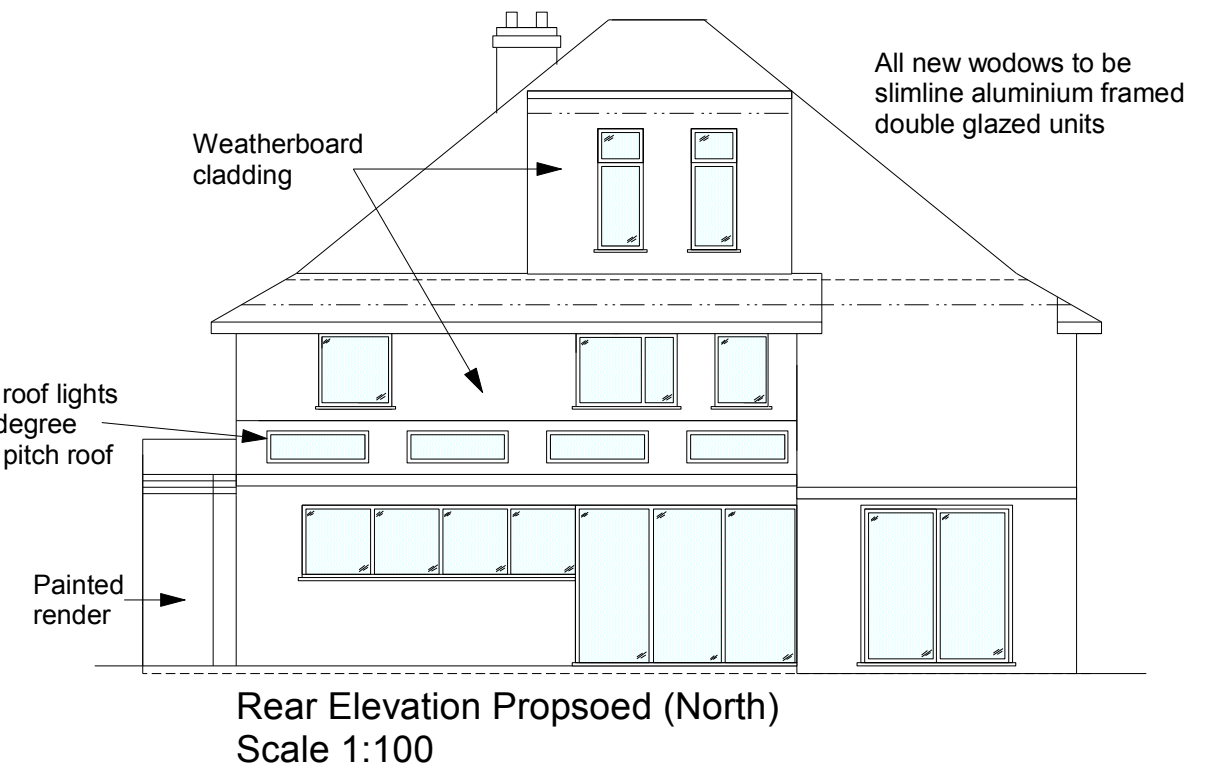
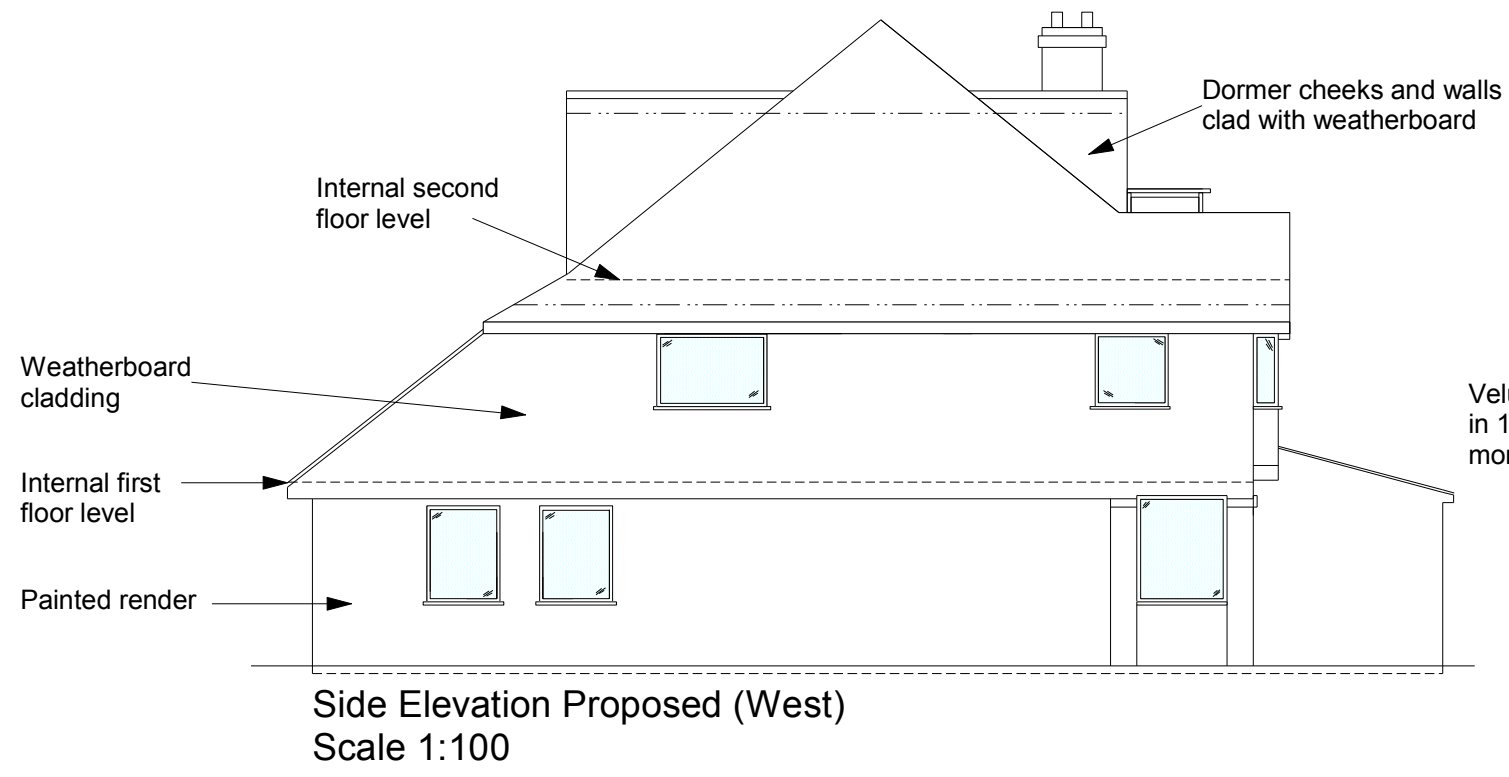


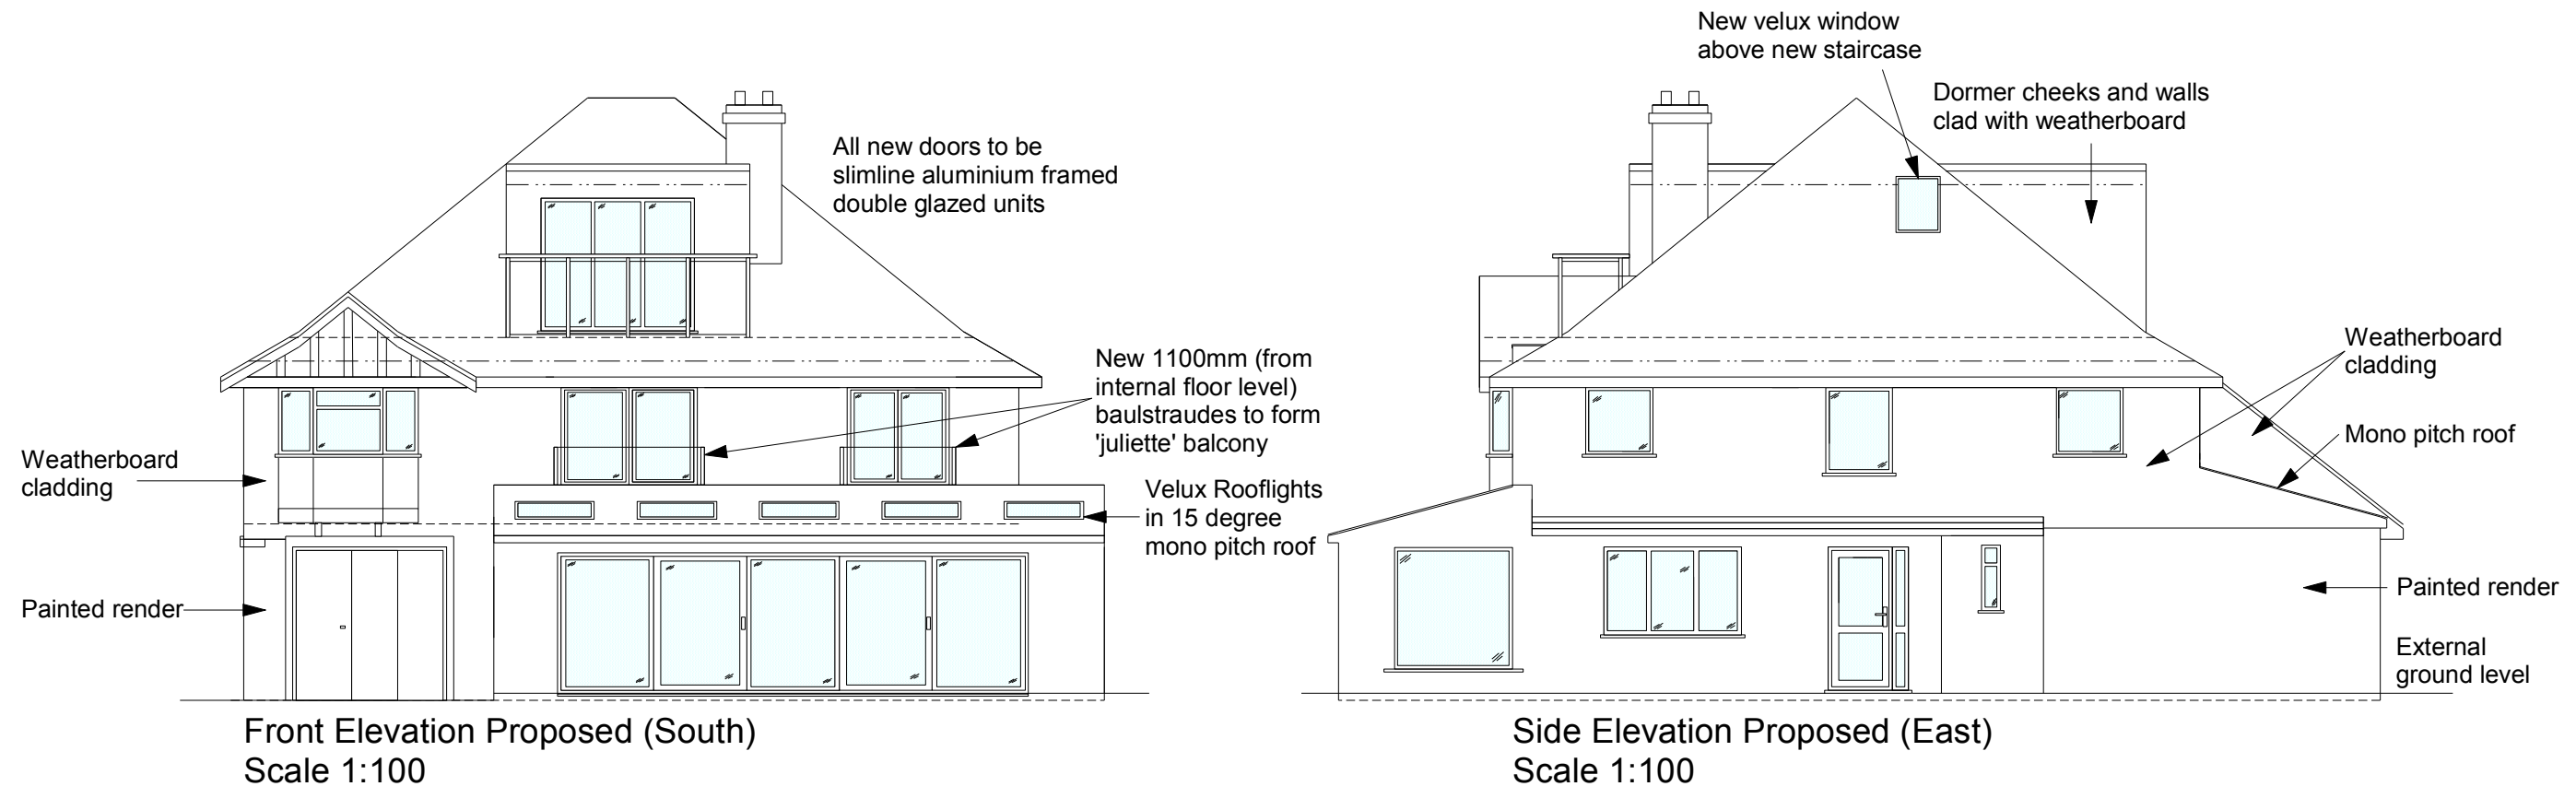

- Non Material Amendment application notes:
1. Replacement of flat roof balcony to mono pitch roof with 'Velux' roof windows to front (southern) elevation.
 2. New window and door arrangement to 'sun room' to front (southern) elevation.
 3. Addition of 'Velux' roof windows to mono pitch roof to rear (northern) elevation.

Non Material Application - FP/249/17/HH

All dimensions and details to be checked on site prior to any commencement of work. This plan is not a full specification or schedule of work and has been produced solely for the purpose of obtaining the necessary local authority consents/approvals. For Party Wall etc. Act 1996 see Government booklet or website.	Status:		Client: Mr & Mrs Makgill 2 Strand Way Felpham Bognor Regis West Sussex PO22 6LH	Revision: E	Project: Loft conversion & extension
	Preliminary	☐ Tender ☐		Scale: 1:50 & 100 @A3	Content: Proposed elevations
	Planning	☒ Construction ☐		Date: June 18	
	Building Regulations	☐ As Built ☐		Dwg No: RM003	