



MINTON RD

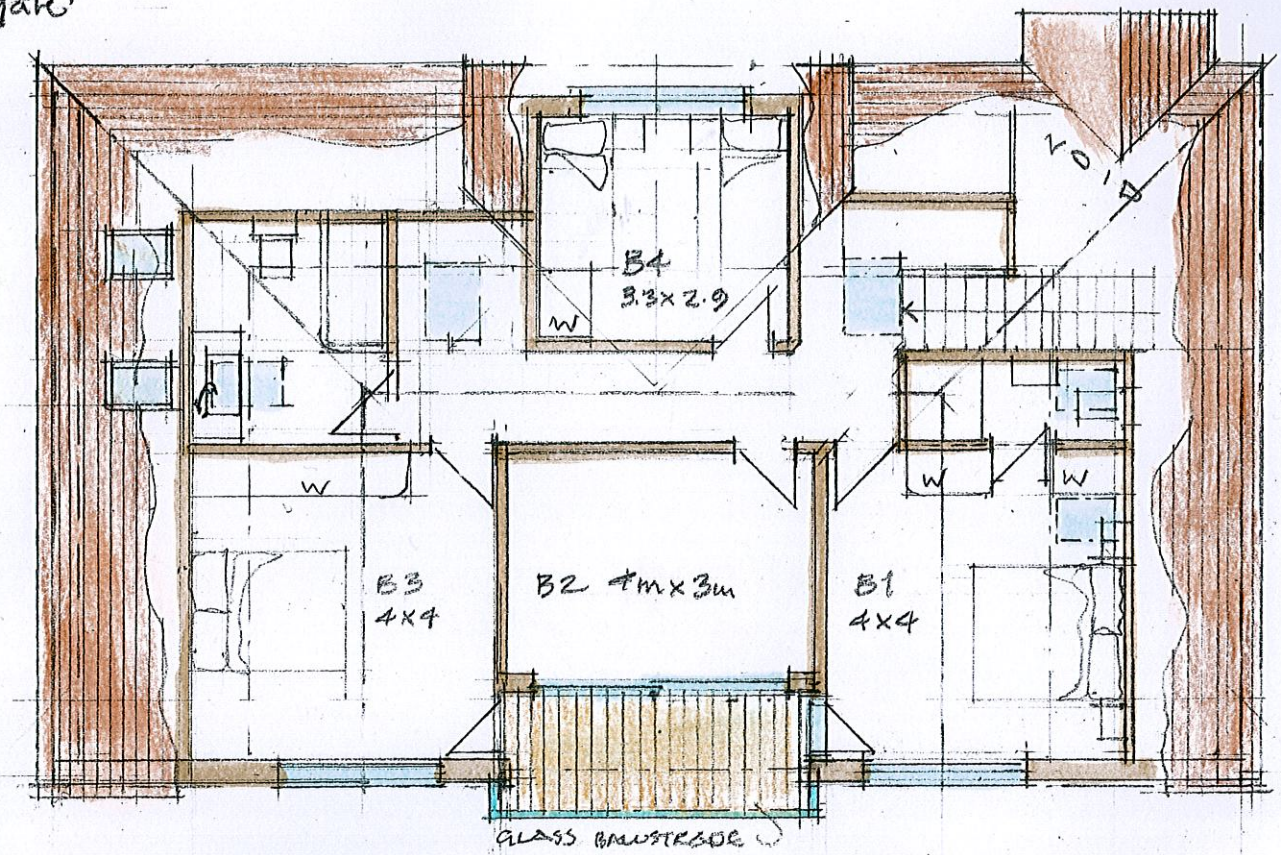

FIRST

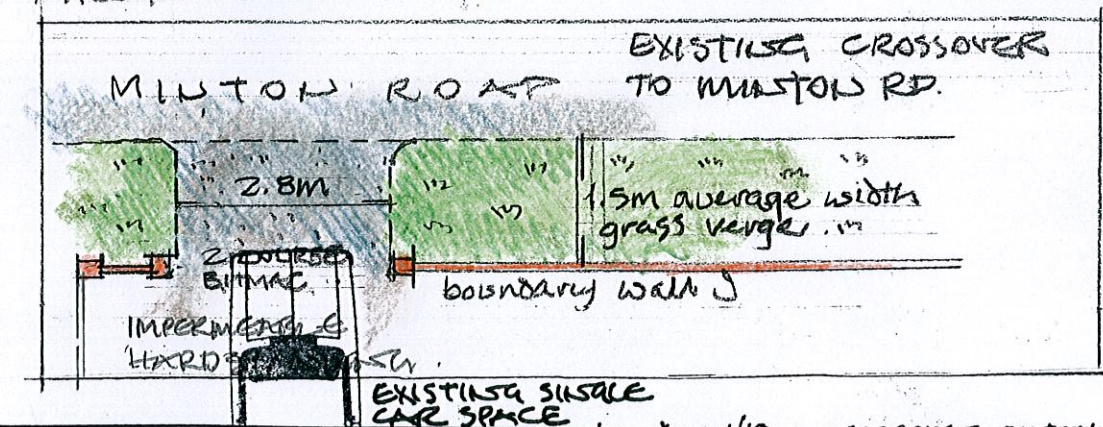

~~PRELIMINARY~~ / PLANNING / ~~BUILDING REGS~~

Rev.	Date	Description	By
------	------	-------------	----

Drawing Title

Proposed Floor Plans

MARKED UP TO SHOW PROPOSED
OFF-ROAD PARKING (cf exq
SINGLE SPACE)

Fairfield House,
Fairfield Road,
Burgess Hill, West Sussex, RH15 8QB
Telephone: (01444) 239019 Fax: (01444) 230761
Email: mail@gwparchitects.co.uk



Drawing Number

18/149/SK03 A

© GWP Architects Ltd (UK) - 2013