




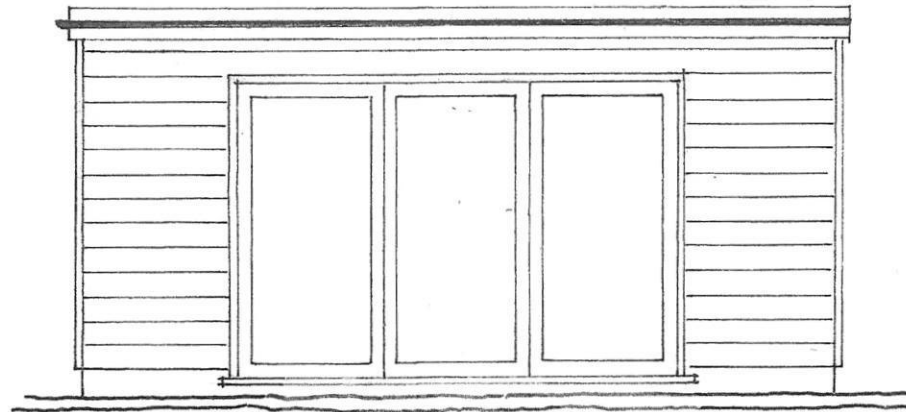

FRONT ELEVATION

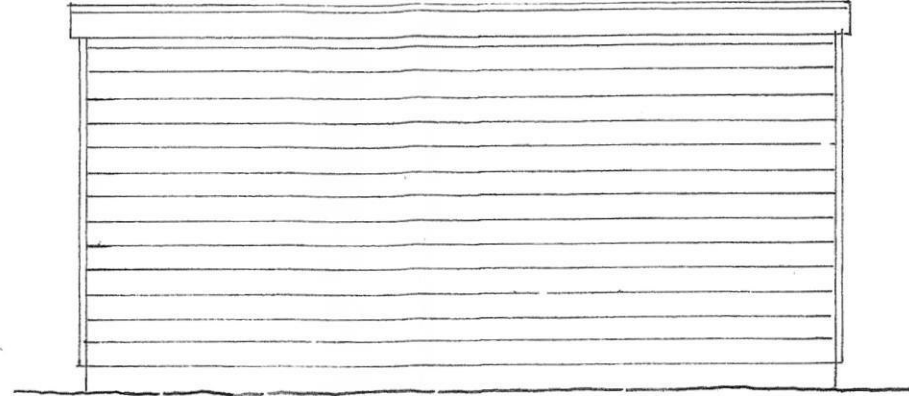


REAR ELEVATION

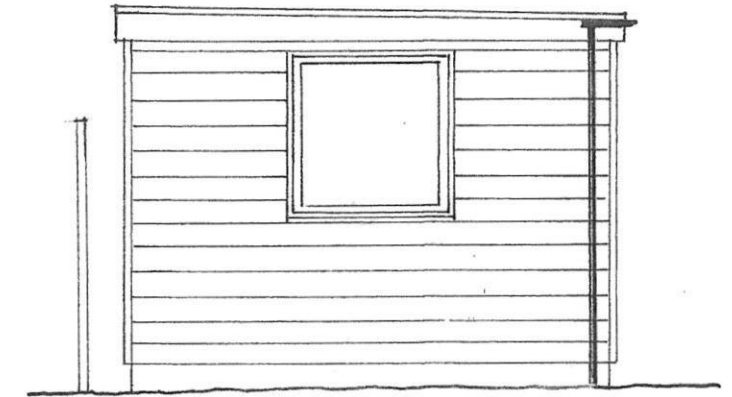


SIDE ELEVATION

BOUNDARY (ASSUMED)

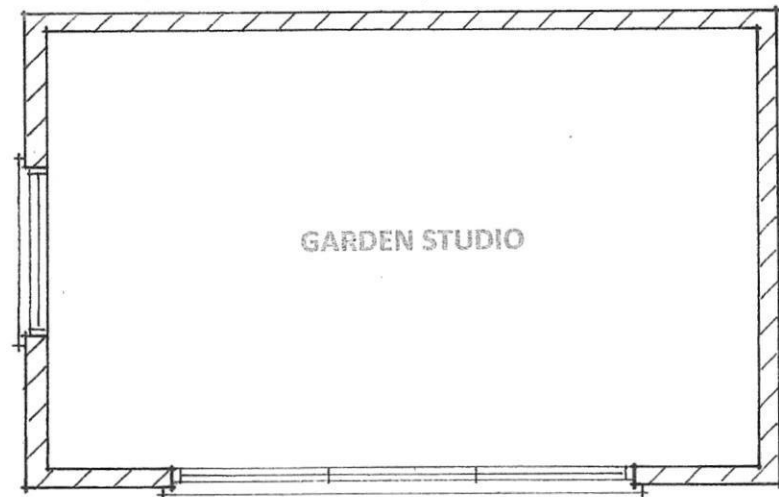


GROUND FLOOR PLAN ~ AS CONSTRUCTED

GARAGE

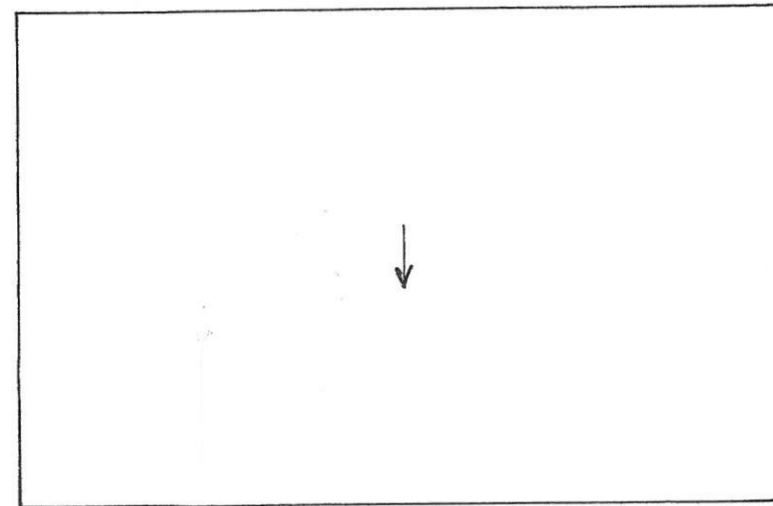

ROOF PLAN

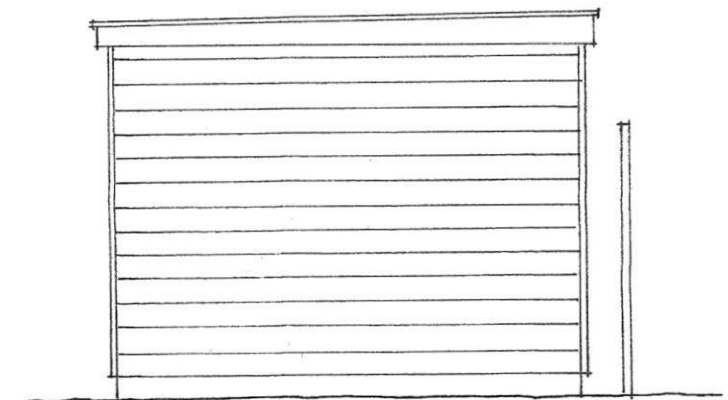

SIDE ELEVATION

EXTERNAL MATERIALS

WALLS ~ HARDIE BAORD (LIGHT GREY)

ROOF ~ FELT

WINDOWS/DOORS ~ WHITE UPVC

SCALE 1 : 50 @ A3 PAPER SIZE



30, RED BARN CRESCENT, FELPHAM, NR. BOGNOR REGIS

SCALE 1 : 50 MARCH 2022 No. 79/22/01

Clive Fish ~ Tel ; (01903) 732942