

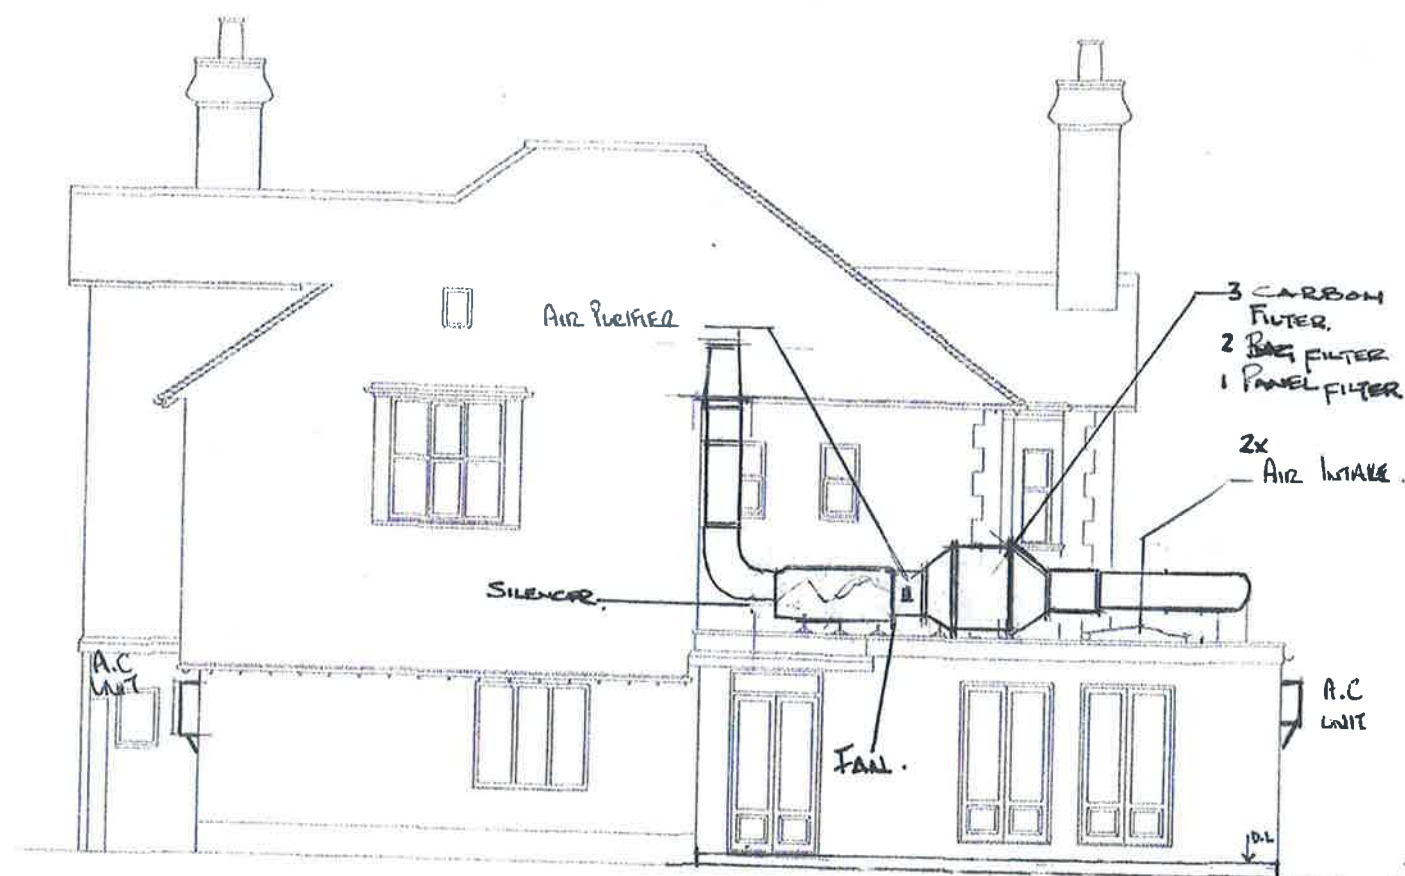



- NOTES:
1. Do not scale this drawing. Use figured dimensions only, except for Planning purposes.
 2. All dimensions must be checked on site by the contractor prior to commencement of work.
 3. All construction details are indicative and are to be checked and confirmed on site and any divergence's are to be agreed with the Contract Administrator.

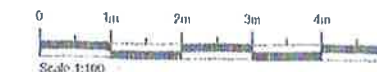

NORTH ELEVATION

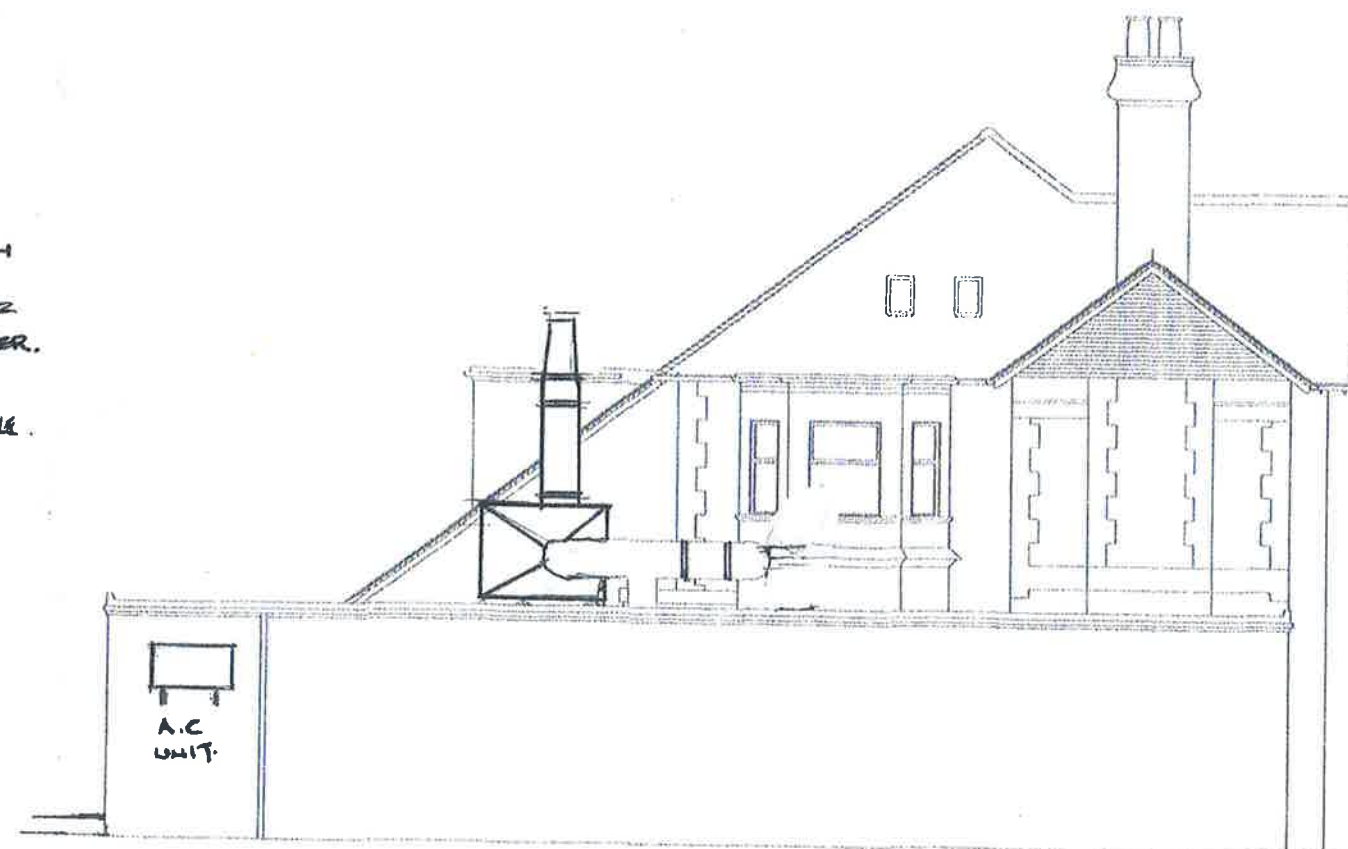

WEST ELEVATION

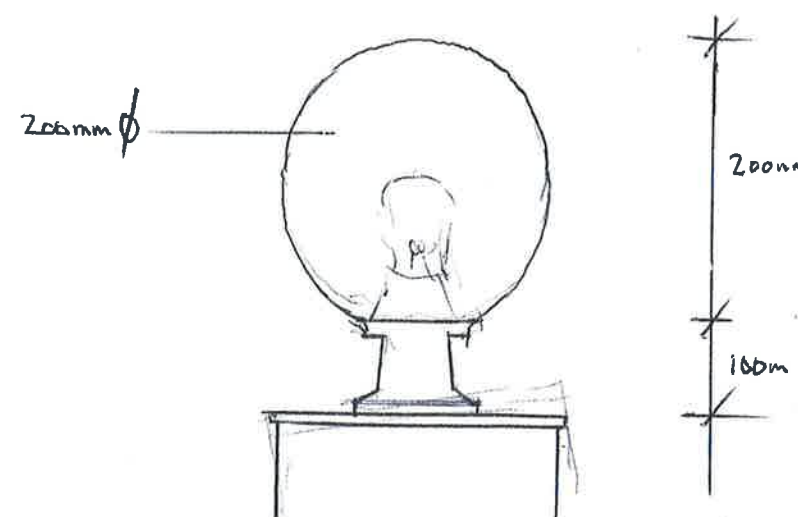

New Extraction Unit With Steel Flue
43 Felpham Way Bognor Regis PO22 8PT

FEB 18 '16 AS BUILT. REV.B

C.R. BARROW & ASSOCIATES LTD.
Structural & Architectural Technicians

Studio 1
Manor Nursery
Lagness Road
Chichester
West Sussex
PO20 1LJ

Tel: 01243 771158
Mobile: 07816 591480

E-Mail: chris.barrow@hotmail.co.uk

NORTH AND WEST ELEVATIONS
AS PROPOSED

Scale 1:100
Date 17/08/2015

Drawn By ACB
Checked CB

Drawing Number 1240 - 05B

