


- NOTES:
1. Do not scale this drawing. Use figured dimensions only, except for Planning purposes.
 2. All dimensions must be checked on site by the contractor prior to commencement of work.
 3. All construction details are indicative and are to be checked and confirmed on site and any divergence's are to be agreed with the Contract Administrator.



New Extraction Unit With Steel Flue
43 Felpham Way Bognor Regis PO22 8PT

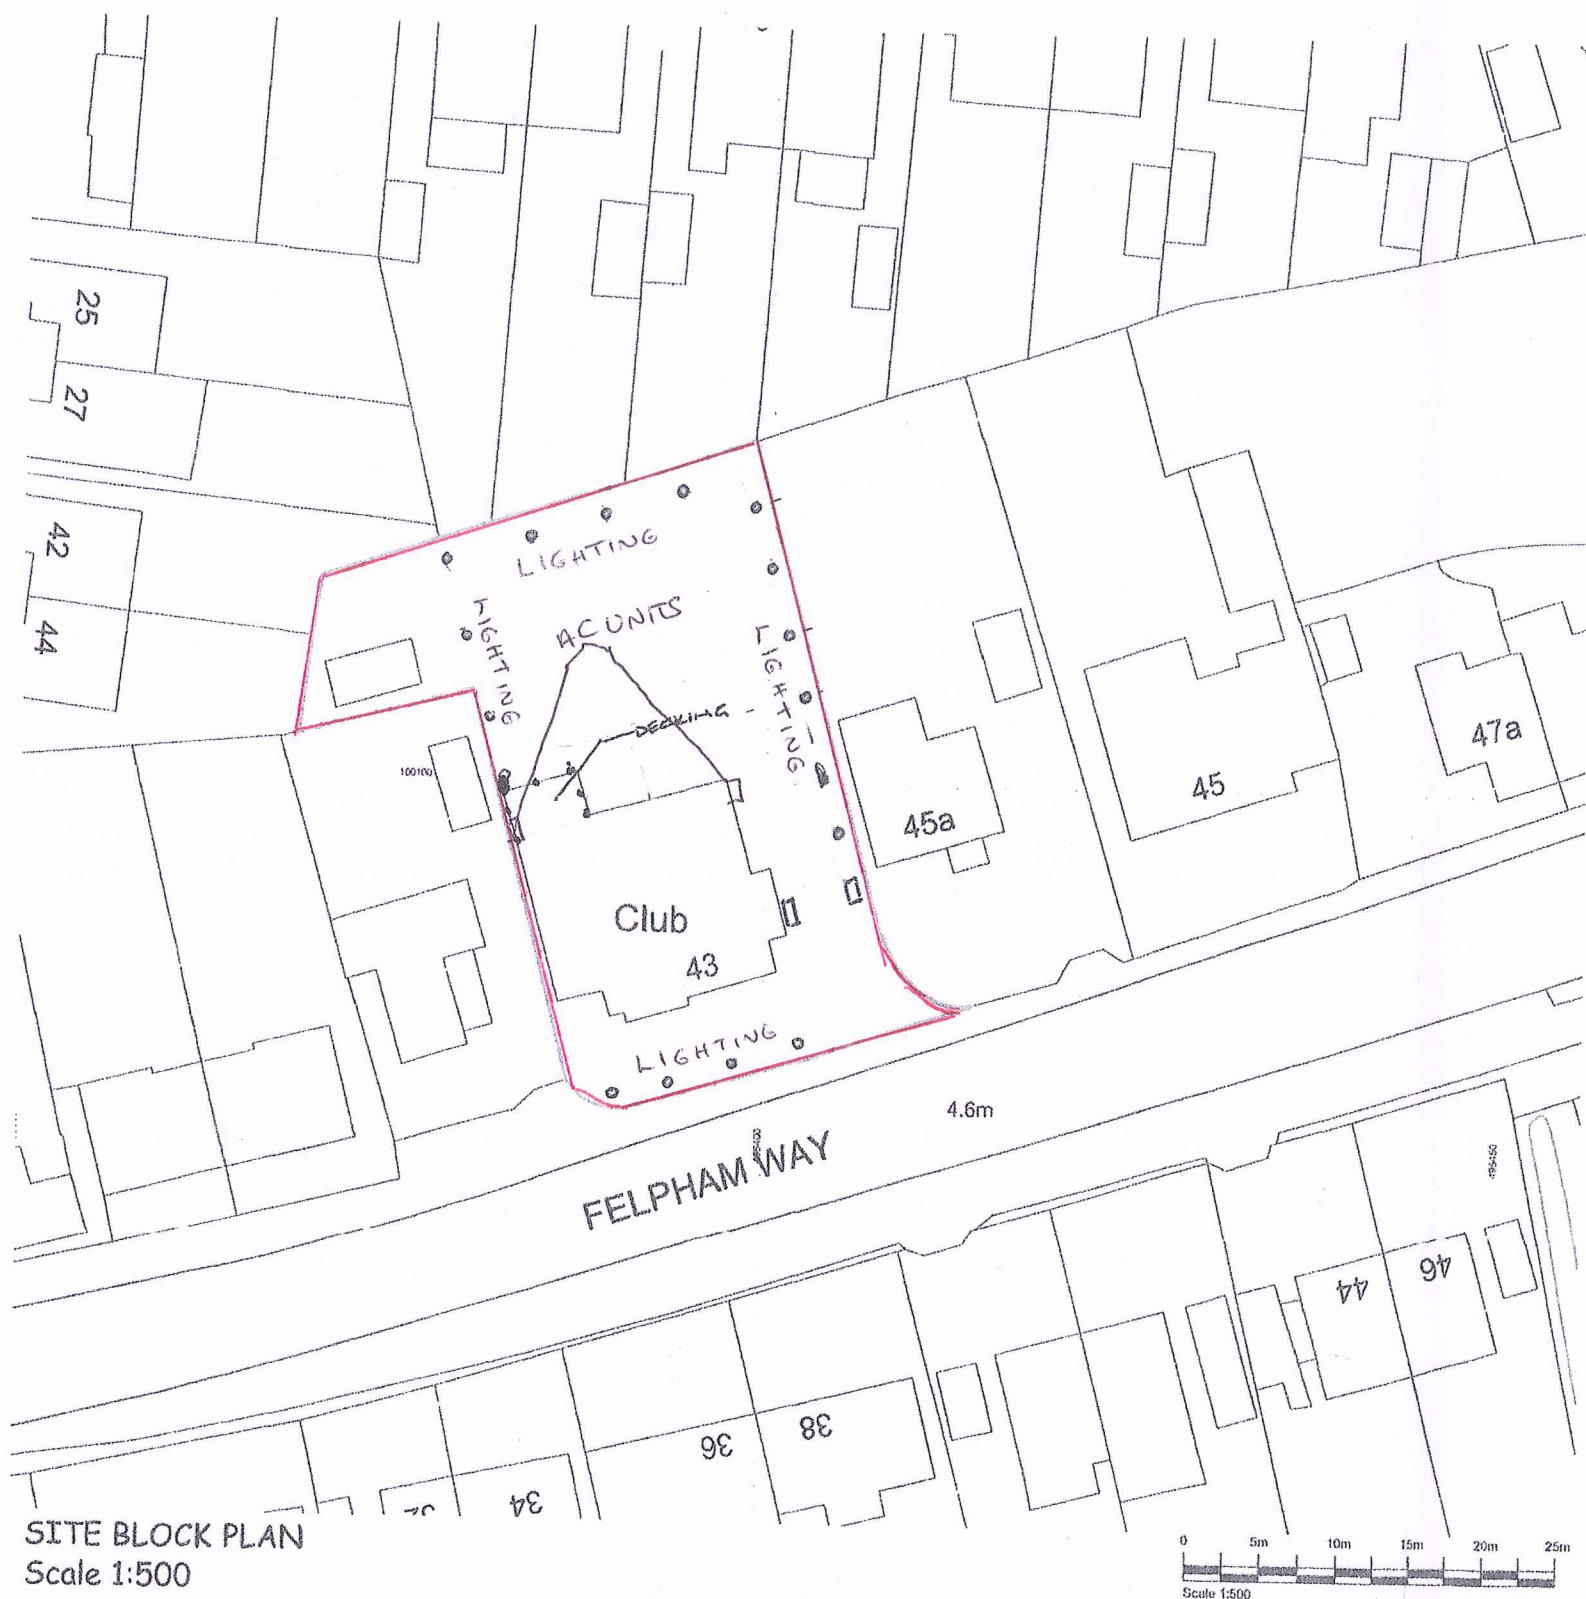

Ordnance Survey, (c) Crown Copyright 2015. All rights reserved. Licence number 100022432

FEB18 AS BUILT REV.B

C.R. BARROW & ASSOCIATES LTD.
Structural & Architectural Technicians

Studio 1
Manor Nursery
Lagness Road
Chichester
West Sussex
PO20 1LJ

Tel: 01243 771158
Mobile: 07816 591480
E-Mail: chris.barrow@hotmail.co.uk

SITE LOCATION & BLOCK PLANS			
Scale	1:1250 - 1:500	Drawn By	ACB
Date	17/08/2015	Checked	CB
Drawing Number	1240 - 01		