





Ground Floor Plan Proposed
Scale 1:100

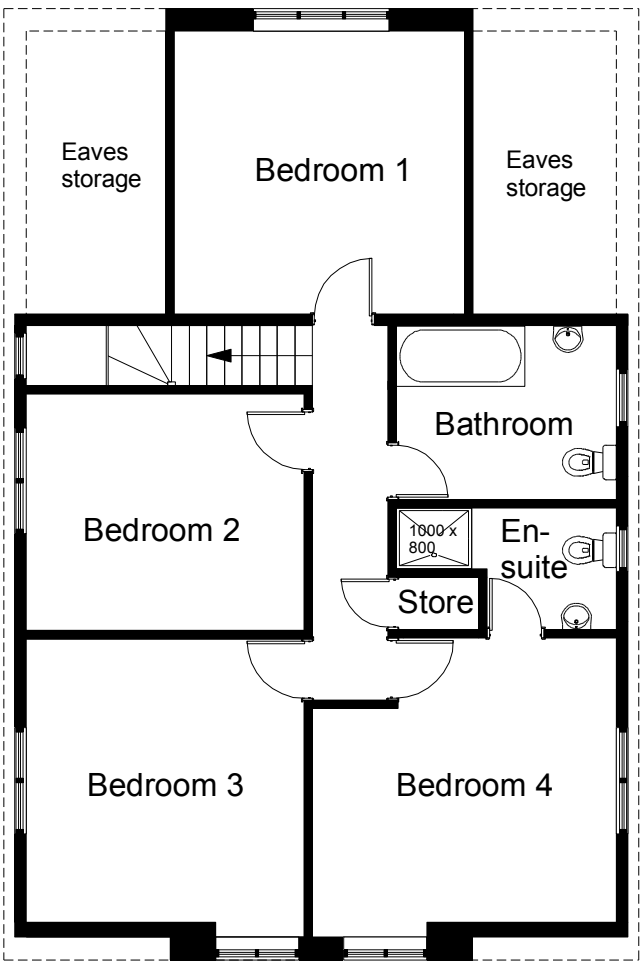


First Floor Plan Proposed
Scale 1:100

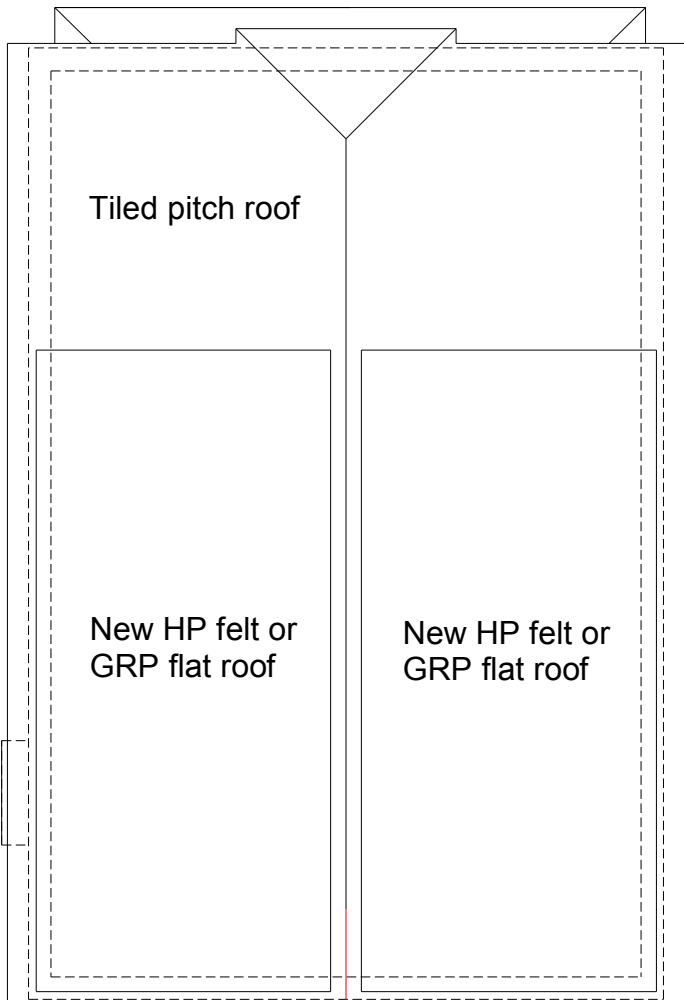

Roof Plan Proposed
Scale 1:100

Red line to show new ridge line and gable end wall to replace former hip end roof

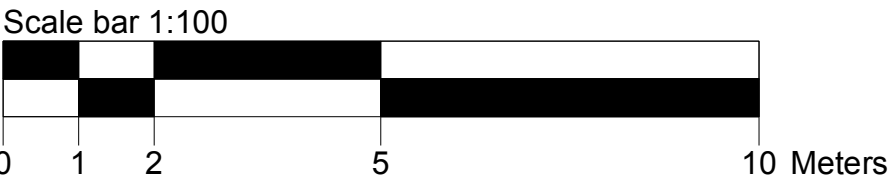

All dims and details to be checked on site prior to any commencement of work. This plan is not a full specification or schedule of work and has been produced solely for the purpose of obtaining the necessary local authority consents/approvals For Party Wall etc. Act 1996 see Government booklet or website.	Status:		Client: Mr & Mrs Gilbert 31 Overdown Road Felpham Bognor Regis West Sussex PO22 7HW	Revision: A	Project: Loft conversion
	Preliminary	☐ Tender		Scale: 1:50 & 100 @A3	Content: Proposed floor and roof plans
	Planning	☒ Construction		Date: May 20	
	Building Regulations	☐ As Built		Dwg No: PG004	