


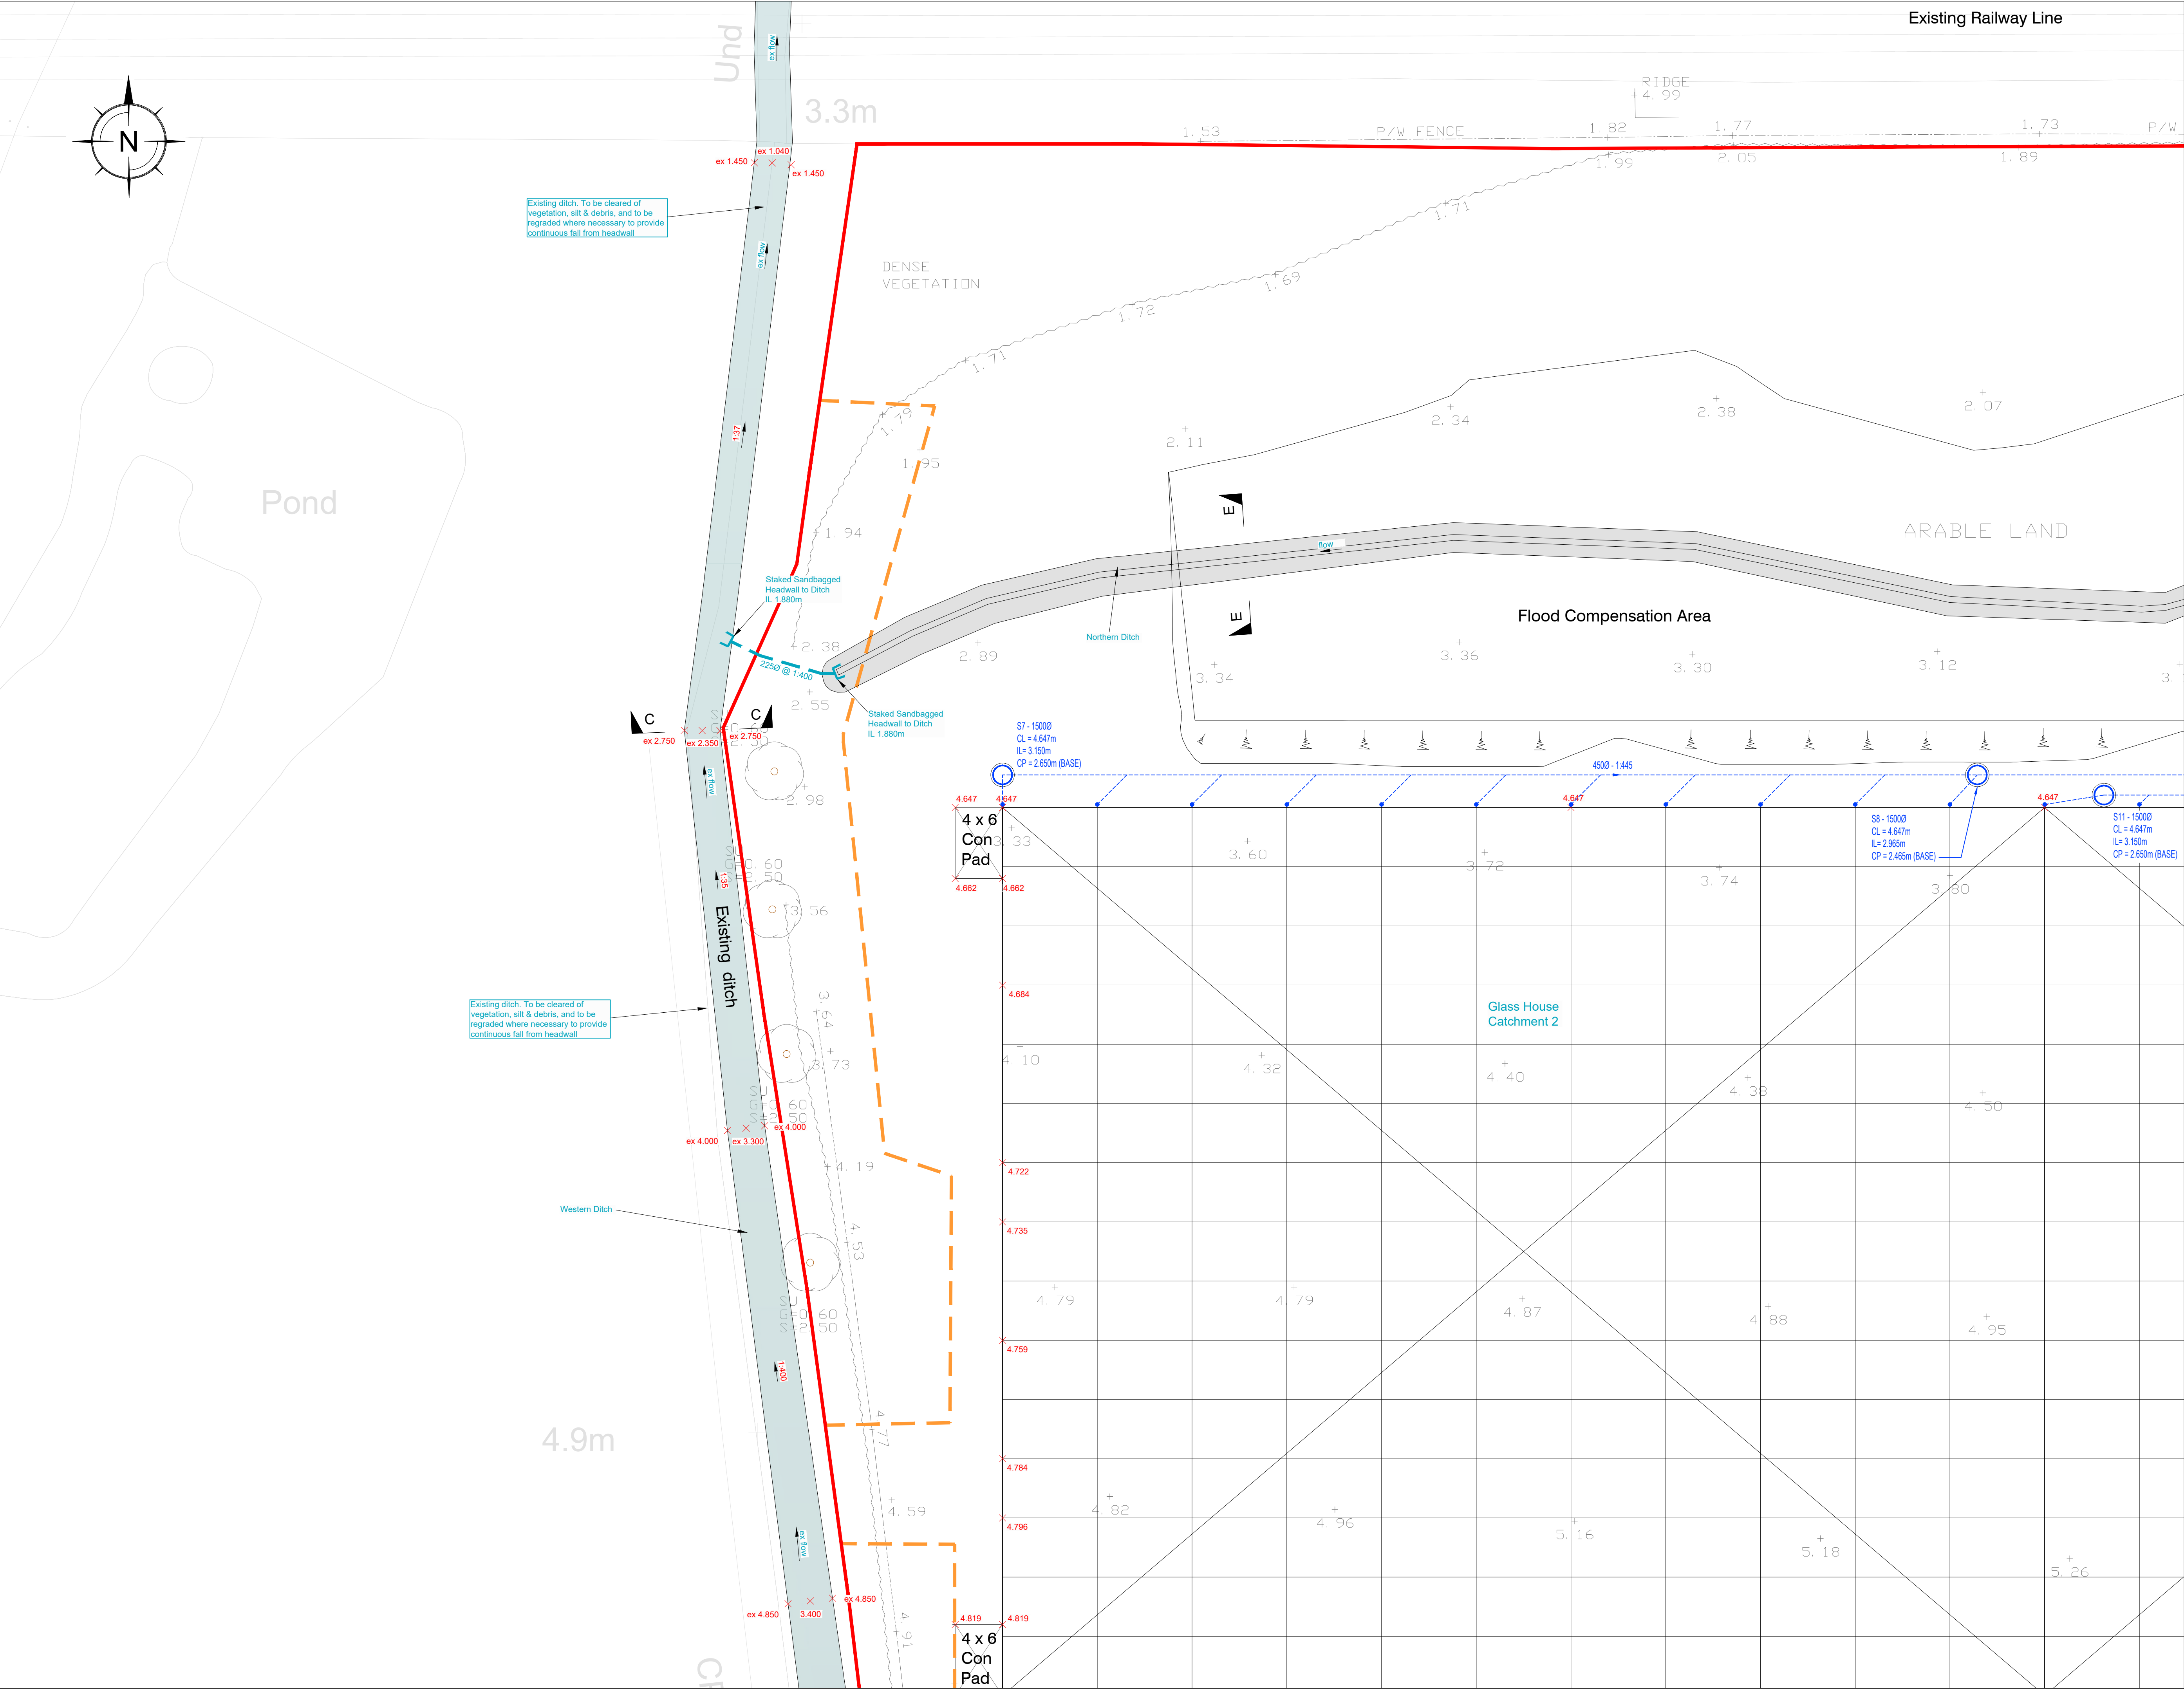

GENERAL NOTES:

1. All dimensions to be checked on site. All details and dimensions relating to sub-Contractors work must be checked and agreed between the sub-Contractor or supplier and the general Contractor.

2. This drawing is to be read in conjunction with all relevant Architect's and Engineer's drawings and specification.

3. The main Contractor is responsible for ensuring the stability of the structure whilst the works are in progress.

4. Any information given regarding existing underground services is given in good faith after consultation with the relevant authority. No liability is accepted by the Consultant and the main Contractor is responsible for obtaining and checking all information and taking due care and attention whilst undertaking the works.

DRAINAGE NOTES:

1. All adoptable pipes, bends and junctions shall be vitrified clay to BS EN 295-1, with flexible joints and kitemark certified.

2. All Adoptable sewers shall be in strict accordance with the 7th edition of Sewers For Adoption. Unless otherwise stated adoptable sewers shall be 150mm diameter and shall be laid in a class S bedding. Where the depth to soffit is less than 1.2m under a public highway or 0.9m elsewhere the pipe shall be laid with a class Z bedding.

3. All private building drainage shall be constructed in strict accordance with BS EN 752:2008. Unless otherwise specified building drainage shall be 100mm diameter and shall be laid at a minimum gradient of 1 in 40 for foul drains and 1 in 80 for surface water drains. All building drains shall be laid in class B bedding unless otherwise specified.

4. Where a pipe is within 1m of a foundation the trench shall be filled with class GEN 3 concrete up to the lowest level of the foundation. Where the trench is further than 1m from the foundation, the trench shall be filled with class GEN 3 concrete to a level below the lowest level for the foundation equal to the distance from the foundation less 150mm. In both cases the pipe shall be bedded and surrounded in 150mm thick class GEN 3 concrete.

5. Where pipes, external to the structures, have a depth to soffit from ground level of less than 450mm they shall have a class GEN 3 concrete encasement (150mm thick). In all other cases the pipes shall be bedded and surrounded with 100mm thick granular material.

6. In any circumstances where pipes are bedded and surrounded in concrete flexible joints should be provided. Compressible boards (fibreglass or polystyrene) shall be provided at a maximum of 6m centres (consolidating with pipe joints). The boards shall be pre-cut to pipe diameter and to a height and width equal to the concrete cross section. A board thickness of 18mm for pipes up to 450mm nominal diameter and 38mm for pipes over 450mm nominal diameter.

7. All syps shall have rodding access plates fitted at their bases (ground floor level).

8. Where existing pipes are to be abandoned they shall be dug out together with any abandoned manholes.

9. Any discrepancy between the drawing and site should be reported immediately to the Engineer.

10. All manhole and chamber sizes are given as a minimum to meet the 7th edition of Sewers For Adoption.

11. All pipes to connect soffit to soffit.

SHEET PLAN

LEVELS KEY

5. 31+ Existing Topographical Survey Level

ex 4.684 X Existing Tie into Level

4.684 X Proposed Spot Level

1:11 Proposed Gradient

Proposed Contours

50mm intervals on site

250mm intervals on pond

DRAINAGE KEY

Private Storm Drainage

Type 2 Precast Concrete Manhole Type

CP Catchpit Manholes

Aco Channels

Fin Drain

French Drain

Surface Water Drainage by Jackson Purdue Lever - See Drawings 001679-DR-D-4001 to 4004

Private Foul Drainage

Type 2 Precast Concrete Manhole Type

Type 3 Inspection Chambers

Rising Main

Root Protection Area

G 02.11.21 | PR | Condensation Drainage by others added. As built SB drainage and ditch added.

F 24.09.20 | PR | Minor Note changes. Jackson Purdue Lever SB Drainage added.

E 21.08.20 | PR | Levels and Drainage updated.

D 25.06.20 | PR | Flood compensation area revised.

C 12.06.20 | PR | Existing Ditches added

B 19.03.20 | PR | Sewer on western boundary revised. Reservoir and compensation areas revised as per Geodine Drawings

A 03.03.20 | PR | Minor Amendments.

REV	DATE	BY	DESCRIPTION	CWN
-----	------	----	-------------	-----

PRELIMINARY

The Civil Engineering Practice
11 Tungsten Building
George Street
Fishergate
Sussex
BN41 1RA
01273 424424
reception@civil.co.uk
www.civil.co.uk

CLIENT
DPS Limited

PROJECT
Wicks Farm
Ford

TITLE
Proposed Levels and Drainage
Sheet 1 of 6

DRAWN	DATE	PROJECT NO.
PR	Feb 2020	23314

DESIGNER	CHECKED	DWG NO.	REV
SB		21	G

SCALE
1:250 @ A1