


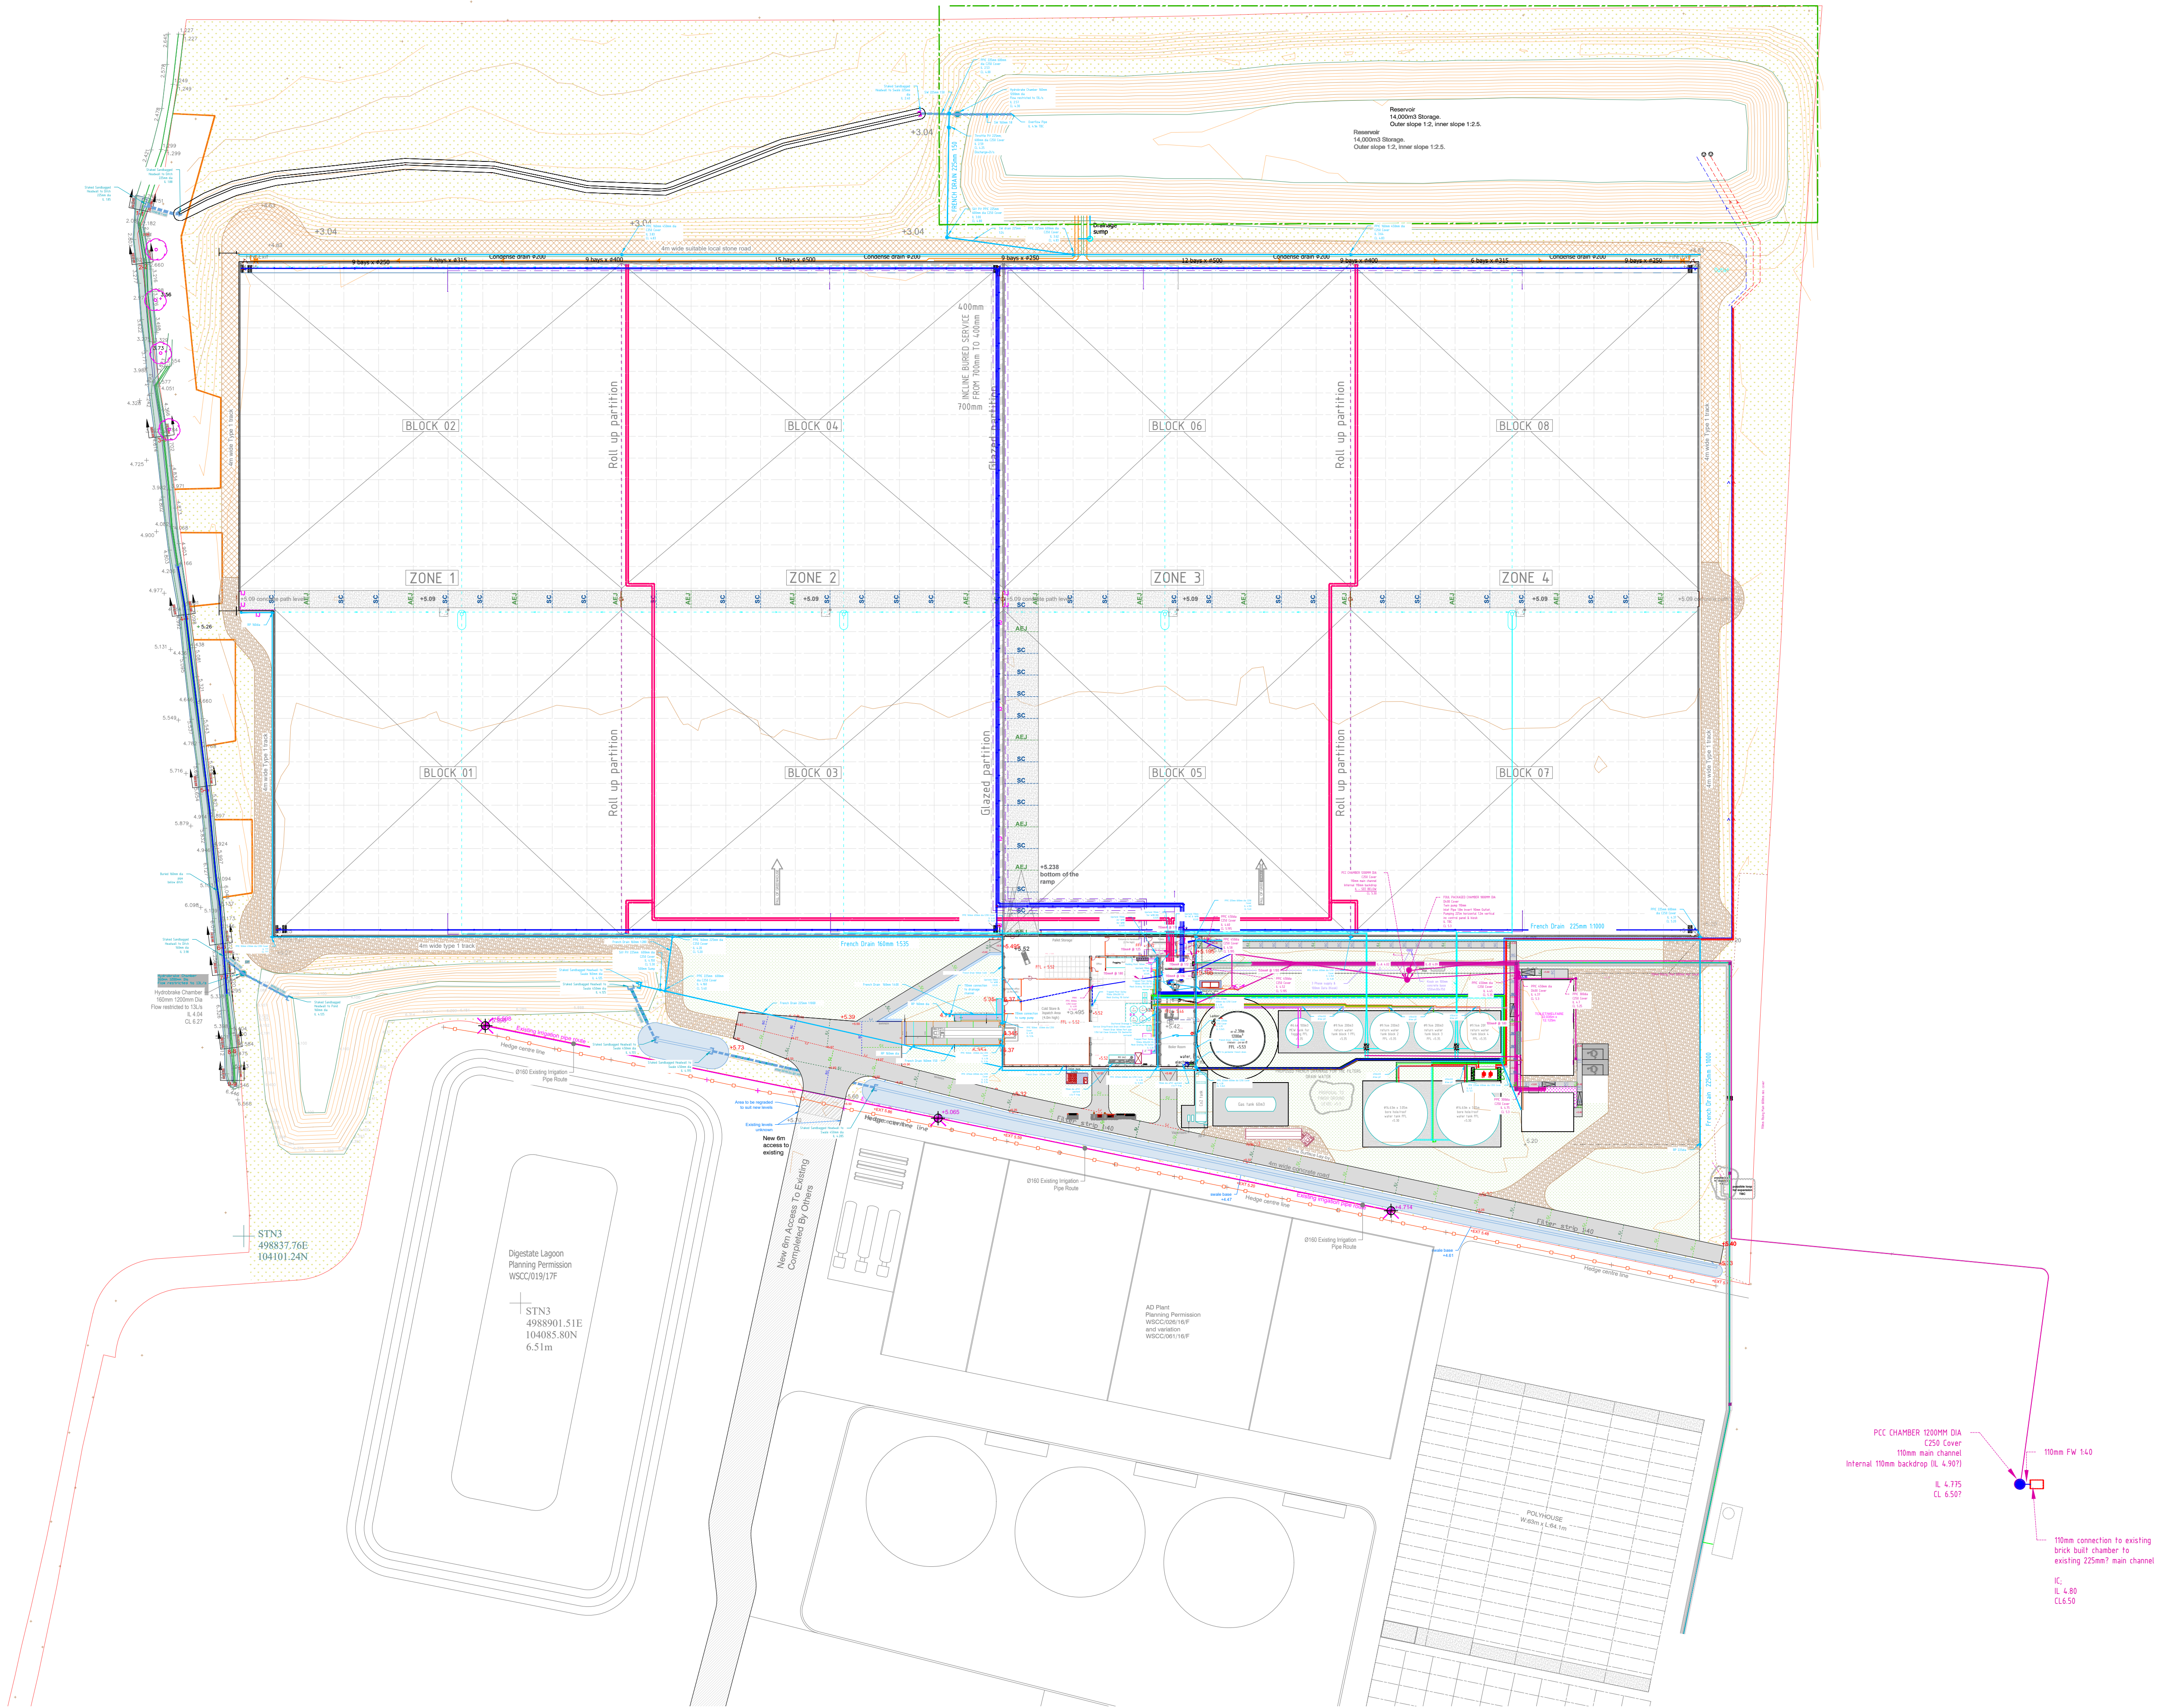

General Tolerances: Dim to no DP = +/-1mm
Dim to 1 DP = +/-0.5mm
Dim to 2 DP = +/-0.1mm

Wallingfen Park
236 Main Road
Newport
Brough
East Yorkshire
HU15 2 RH
e-mail - info@cambridgehok.co.uk
Web - www.cambridgehok.co.uk

This drawing is copyright, it must not be copied, used or disclosed to third parties without our permission.

General Notes:

Revisions

rev	date	description	Drawn
L	28-04-21	Revised to ASBUILT	MK
K	04-12-20	Path & foul drain revised	MC
J	03-12-20	Path detail revised	MC
I	19-11-20	Revised to ASBUILT	MC
H	20-08-20	Concrete spot heights added.	MC
G	12.08.20	Drainage amended	MK
F	08.08.20	North swale modified	MK
E	03.08.20	Drainage details amended	AWH
D	23.07.20	Drainage details amended	AWH
C	10.07.20	Drainage details amended	AML
B	03.07.20	Drainage details amended	AML
A	02.07.20	Drainage Layout Added	AML

Client
Berry Farming Ltd
Unit 4, Conqueror Court
Watermark, Vellum Drive
Sittingbourne, Kent, ME10 5BH

Project
Wicks Farm
New Glasshouse Development

Drawing Title
Proposed Drainage Layout

Revision	Scale	Date	Drawn	Checked
K	1:1000	02.07.20	AML	ID

Drawing No
6648-CHOK-GH-GF-DR-G-0210-006

Drawing Status
ASBUILT