


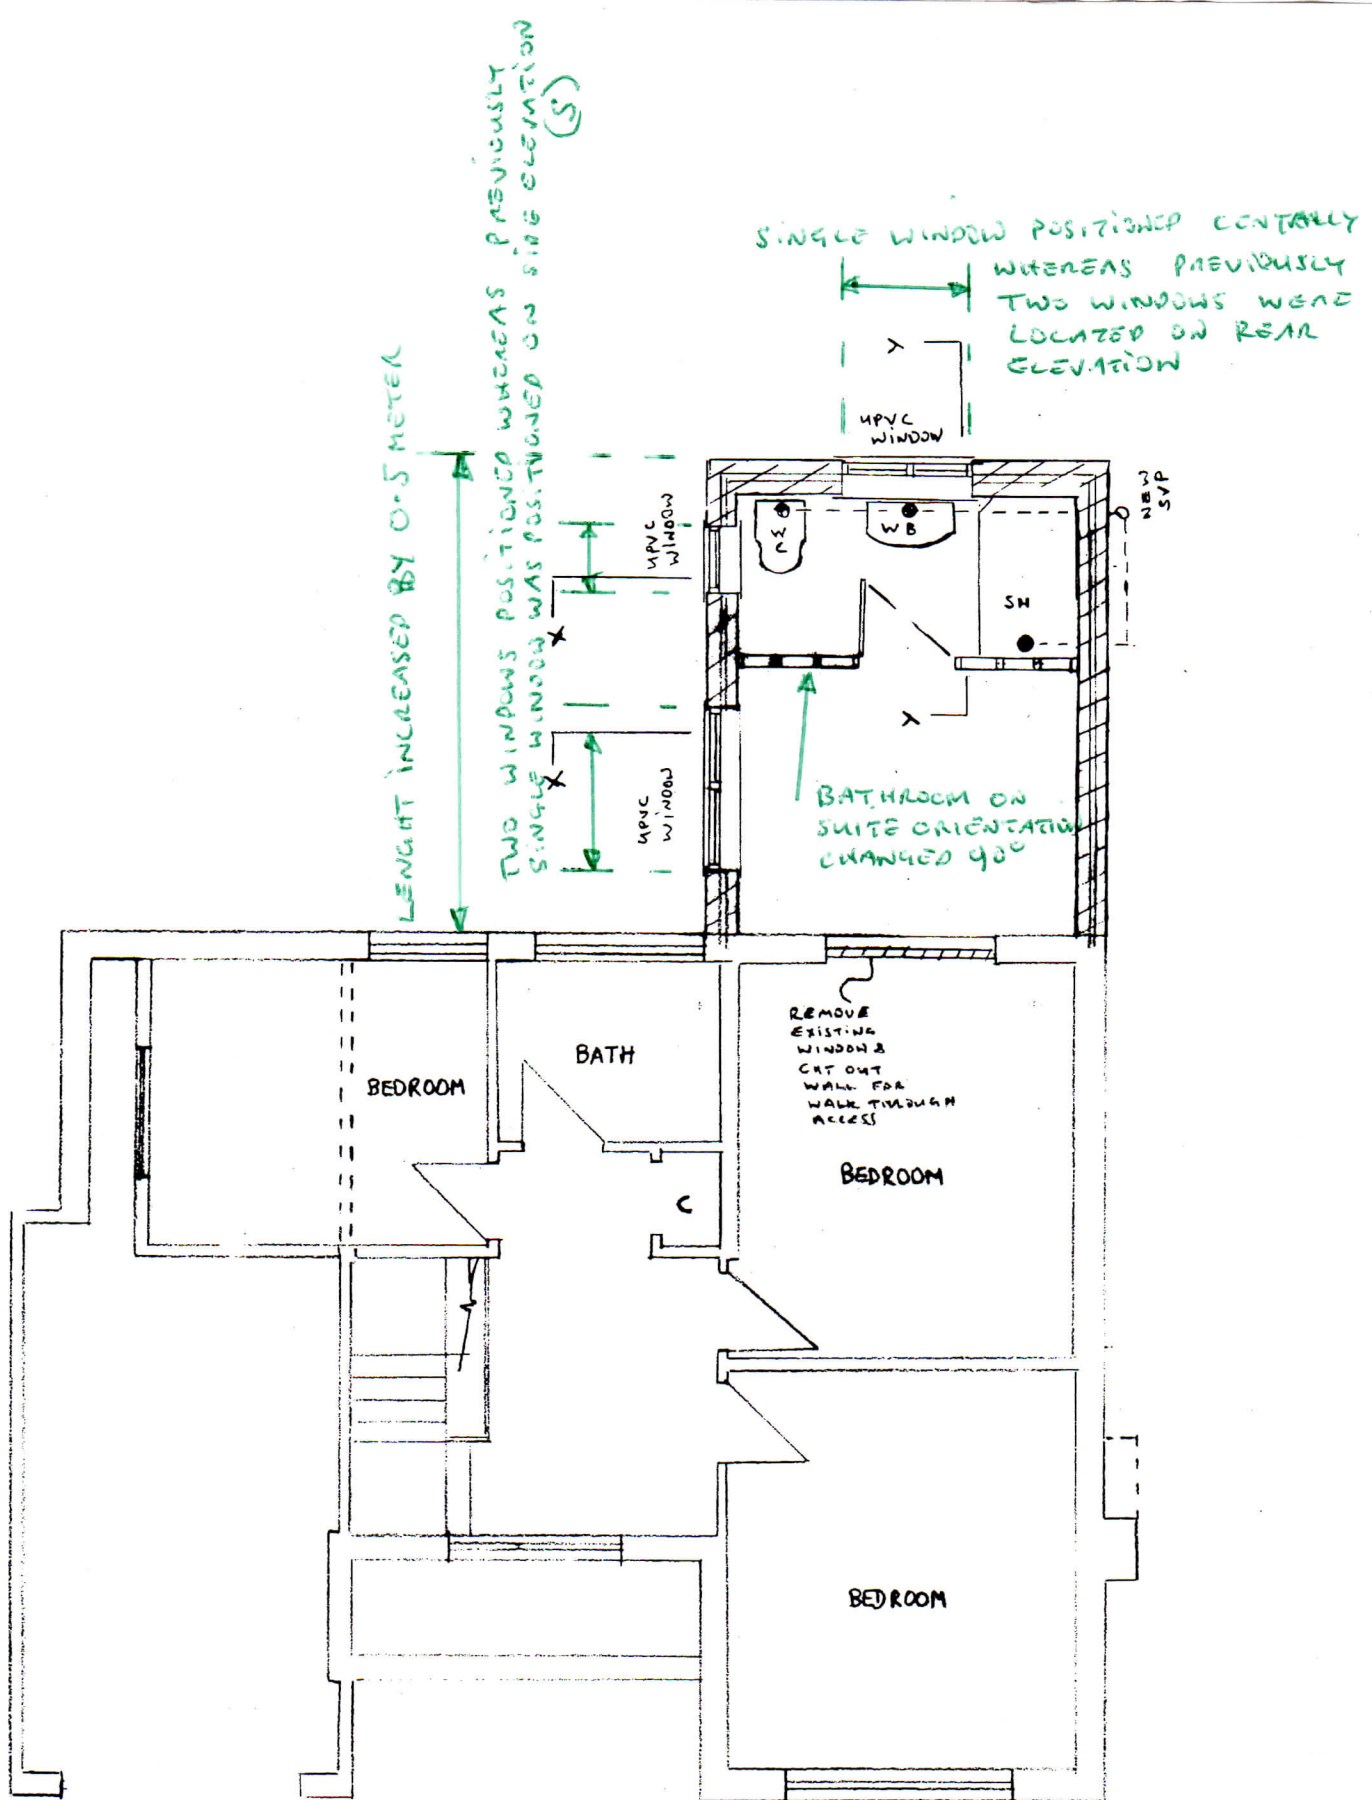

FIRST FLOOR PLAN

* CHANGES TO PLANS ARE HIGHLIGHTED INDICATED IN GREEN INK.

DRAWING TITLE: PROPOSED EXTENSION
 TITLE: 87 GOLDEN AVENUE
 EAST PRESTON
 SCALE: 1:50
 DATE: FEBRUARY 2018 REV1 FEB2019
 DRA NO: JW SHGT 30F5
 NOTE: THIS DRAWING IS TO BE
 READ IN CONJUNCTION WITH
 APPENDIX A