



MATERIALS:
Natural timber cladding
Grey tin roof


**STABLE 3
new**

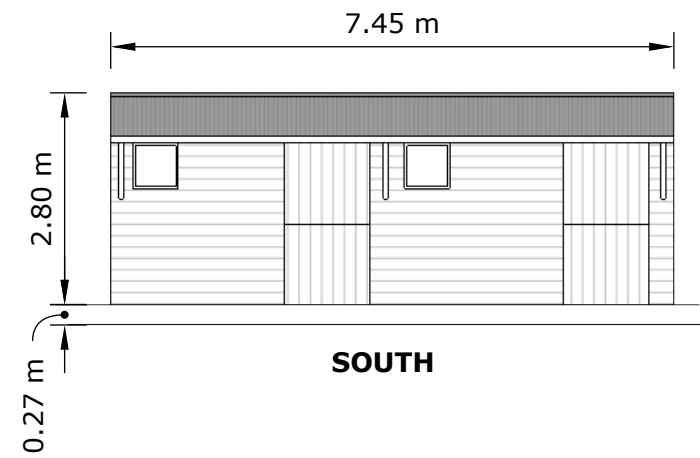


SOUTH

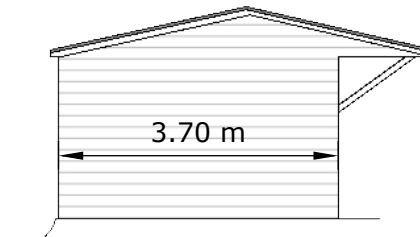

EAST

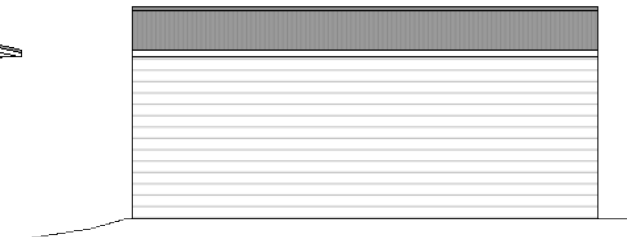


NORTH

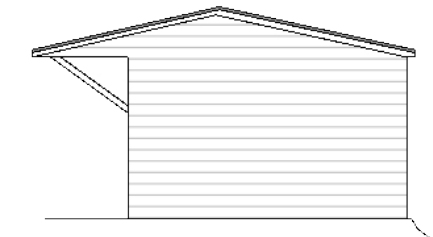


EAST


**STABLE 2
new**

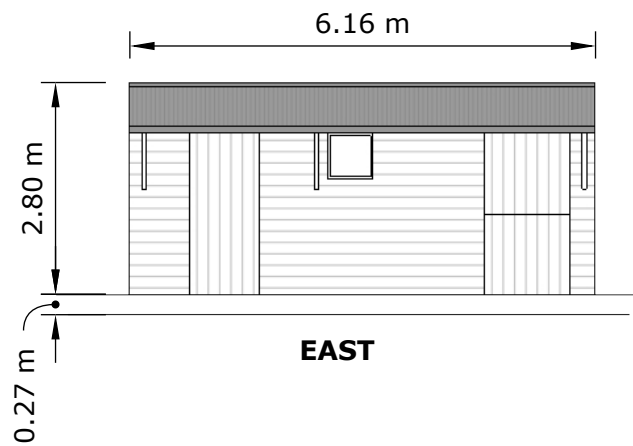


EAST

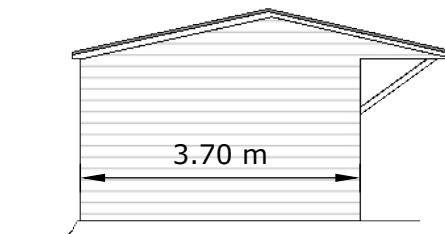

SOUTH

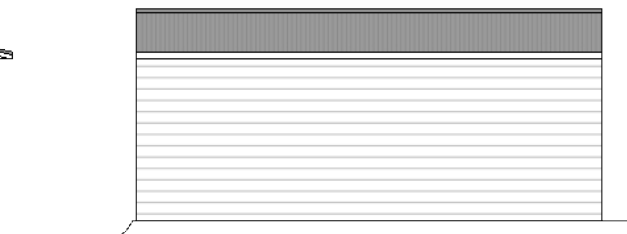


WEST

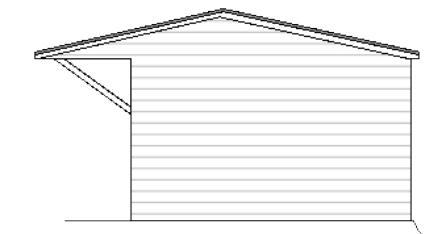


NORTH

**STABLE 1
new (re-built)**

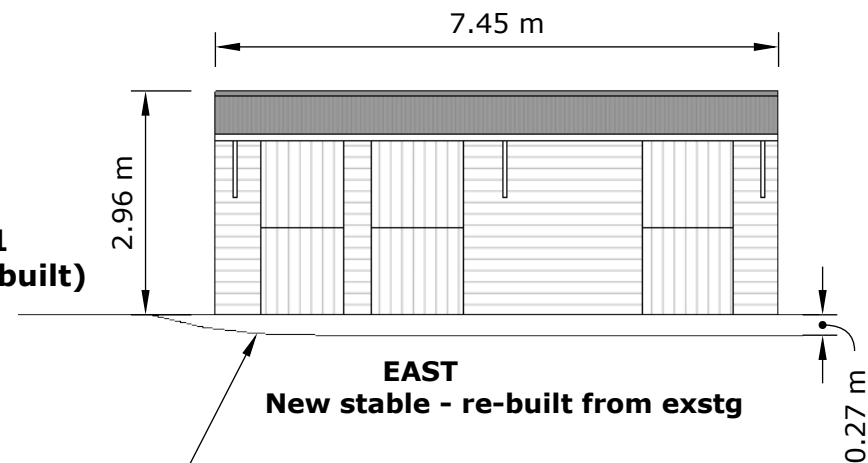


EAST


New stable - re-built from exstg

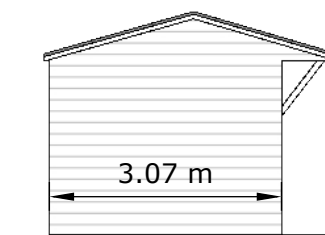

SOUTH

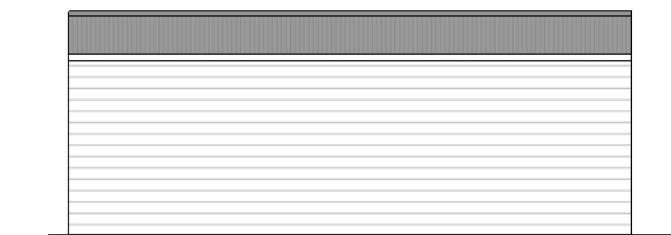

WEST

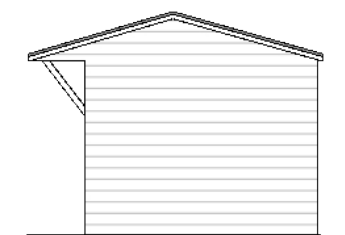

NORTH

Ground built up
with hardcore/gravel
and topped with bark
chippings - to bring level
with access through gate



ERECTION OF 3X STABLES ON RAISED BASE OF HARDCORE, GRAVEL AND BARK
Land Northeast of West Kingston House, Kingston Lane, Kingston, West Sussex BN16 1RP

DRAWING: AS BUILT ELEVATIONS

SCALE: 1:100 @ A3

DATE: 26/06/2018

DRAWING No: DS/NAOMI/01rev1

