


MATERIALS:
Natural timber cladding
Grey tin roof

BOUNDARY HEDGEROW/TREES

Height ranging from 2.5m up to approx 4m

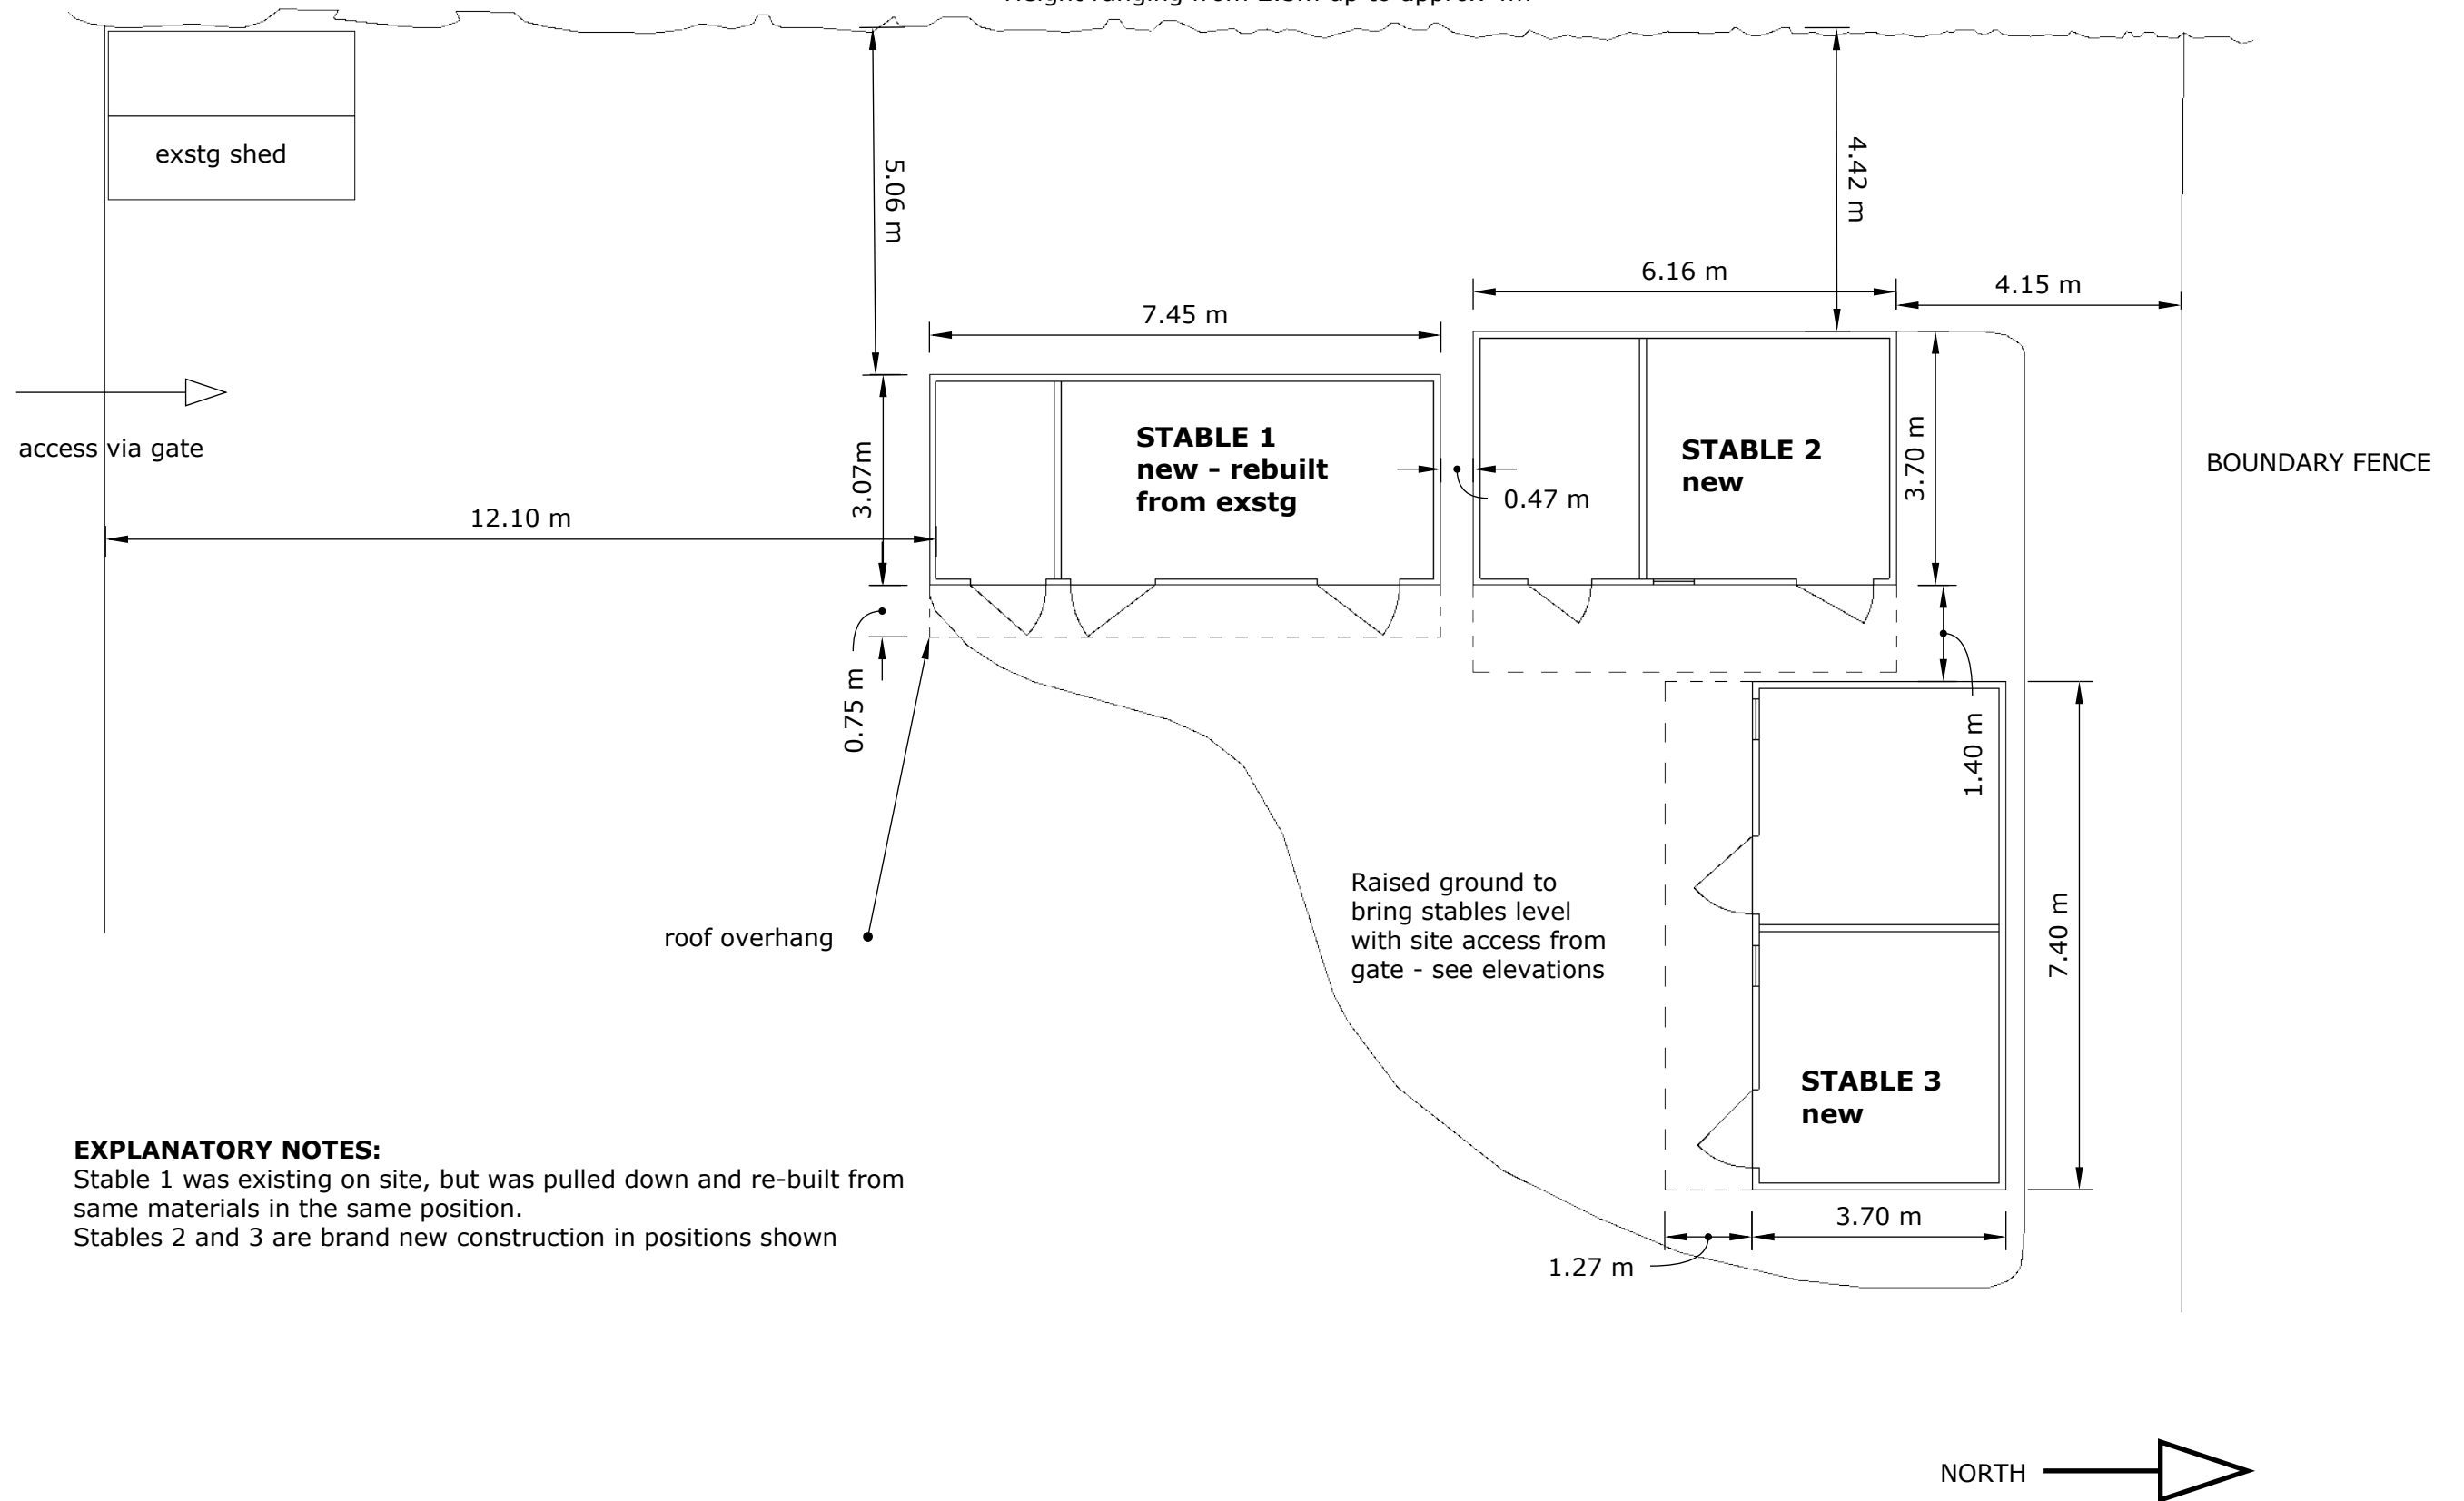

EXPLANATORY NOTES:

Stable 1 was existing on site, but was pulled down and re-built from same materials in the same position.
Stables 2 and 3 are brand new construction in positions shown



ERECTION OF 3X STABLES ON RAISED BASE OF HARDCORE, GRAVEL AND BARK
Land Northeast of West Kingston House, Kingston Lane, Kingston, West Sussex BN16 1RP

DRAWING: AS BUILT PLANS

SCALE: 1:100 @ A3

DATE: 26/06/2018

DRAWING No: DS/NAOMI/02/rev1

