 




From: Kevin Eaton [REDACTED]
Sent: 10 December 2021 15:40
To: Kathryn Welch <Kathryn.Welch@arun.gov.uk>
Subject: Re: Flint Barn K/49/21/HH

CAUTION: This email originated from outside of the organisation. You should take extra care when clicking links or opening attachments - if you are unsure the content is safe contact the IT Helpdesk before clicking or opening.

References:

- 1 - Approved Planning Application - [K/52/20/HH](#)
- 2 - Approved NMA
- <https://www1.arun.gov.uk/aplanning/OcellaWeb/planningDetails?reference=K/12/21/NMA&from=planningSearch>

Dear Kathryn,

Further to your e-mail below I have requested a revised plan drawing showing the Juliet balcony from my architect. As soon as I receive this I will forward it to you.

In the meantime I have annotated the existing drawing to show the balcony (although I cannot guarantee the accuracy of the scale). This is attached at the end of this e-mail.

Re' the major changes from the agreed planning proposal (Reference 1) and the amended application (the one you are considering) the main points of change are:

A - Front (North) dormer - The 'as-built' dormer is approx' 350mm higher than the original (application). The current application was submitted primarily to regularize this non-compliance with the original approved proposal.

B - Rear first floor corridor extension - Part of original approved plan but omitted from this application as no longer required.

C - East Elevation Roof Velux - proposed in this application. Fitted in lieu of the roof Velux on the south elevation roof which was agreed in the approved application but has now has been removed.



D - Roof Covering to new (North) dormer - As built roof covering is a folded lead effect GRP roof finish. This was originally a clay tile roof covering in the approved plan but due to the change in roof pitch on the 'as-built' dormer (see A), the tile was not compatible - hence the necessity to change the design and material.

Please also note that the window designs and positions in this application have picked up all of the changes in the approved non material amendment (Reference 2).

I hope this is helpful in determining this application but please come back to me if you require anything else.

Regards

Kevin

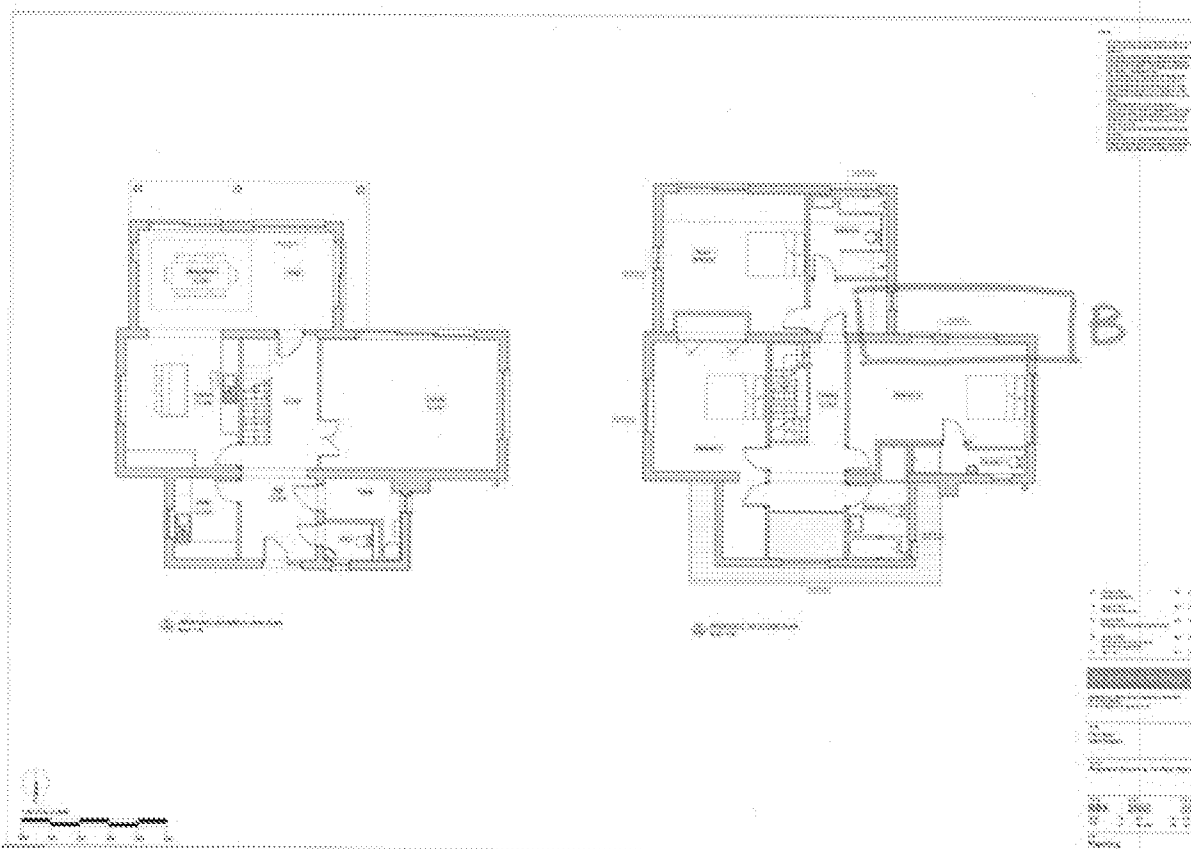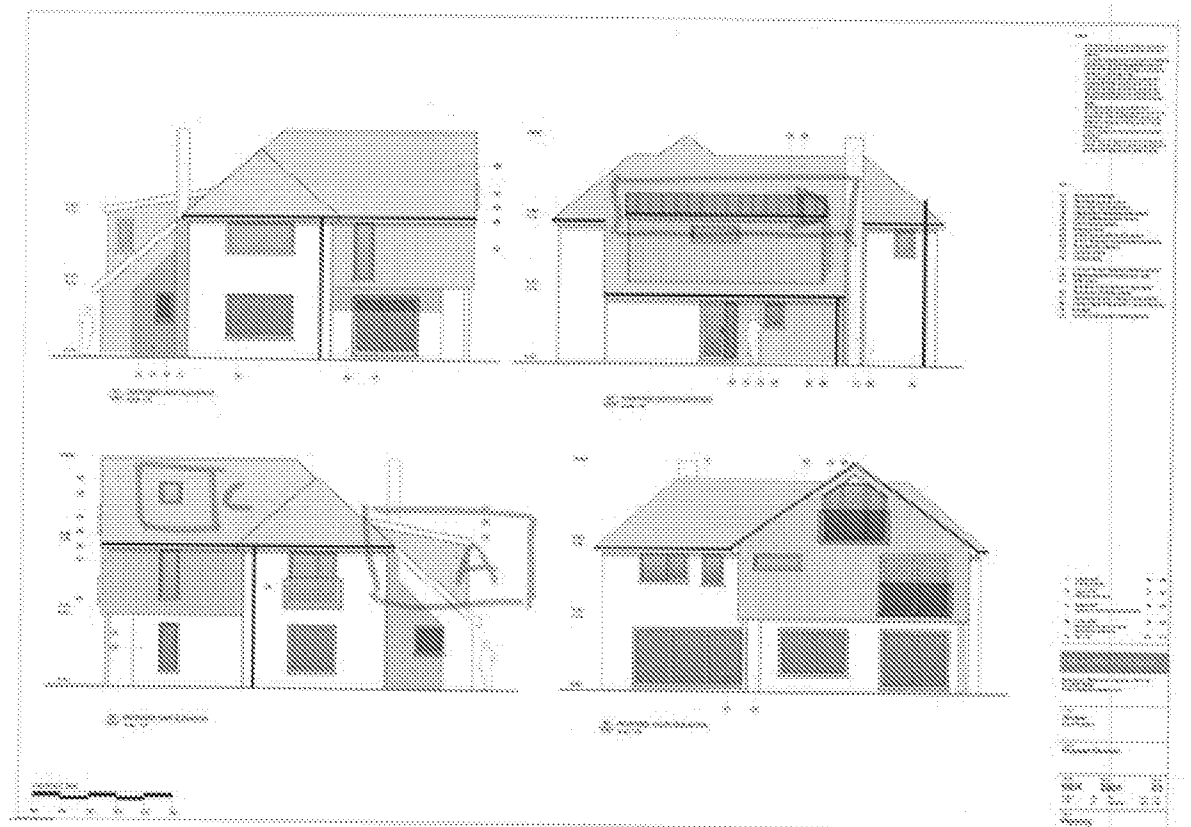

From: Kathryn Welch <Kathryn.Welch@arun.gov.uk>

Sent: 09 December 2021 14:57

To: [REDACTED]

Subject: Flint Barn K/49/21/HH

Dear Mr Easton,

Many thanks for taking my phone call and helping with my enquiries.

I would be grateful if you could amend the plan showing the juliette balcony on the eastern elevation to bedroom 3, if this is what is going to be/has been built.

I would also be grateful if you could summarise the differences between the current application and the already approved scheme i.e. dormer to northern elevation higher than approved, just so that I can focus my work on the relevant areas.

Many thanks,

Kathryn Welch
Planning Officer, Planning Department



T: 01903 737789

E: kathryn.welch@arun.gov.uk

Arun District Council, Civic Centre, Maltravers Rd, Littlehampton, West Sussex, BN17 5LF
www.arun.gov.uk

To register to receive notification of planning applications in your area or to search for particular applications, please go to
<https://www1.arun.gov.uk/planning-application-finder>



Sign up to our newsletter [here](#)

<http://www.arun.gov.uk>

DX 57406 Littlehampton

You can view Arun District Council's Privacy Policy from <https://www.arun.gov.uk/privacy-policy>

Important Notice This e-mail is intended exclusively for the addressee and may contain information that is confidential and/or privileged. If you are not the intended recipient (or authorised to receive it for the addressee), please notify the sender and delete the e-mail immediately; using, copying, or disclosing it to anyone else, is strictly prohibited and may be unlawful. Any views, opinions or options presented are solely those of the author and do not necessarily represent those of Arun District Council. The information in this e-mail may be subject to public disclosure under the Freedom of Information Act 2000, therefore we cannot guarantee that we will not provide the whole or part of this e-mail to a third party. The Council reserves the right to monitor e-mails in accordance with relevant legislation. Whilst outgoing e-mails are checked for viruses, we cannot guarantee this e-mail is virus-free or has not been intercepted or changed and we do not accept liability for any damage caused. Any reference to "e-mail" in this disclaimer includes any attachments.
