


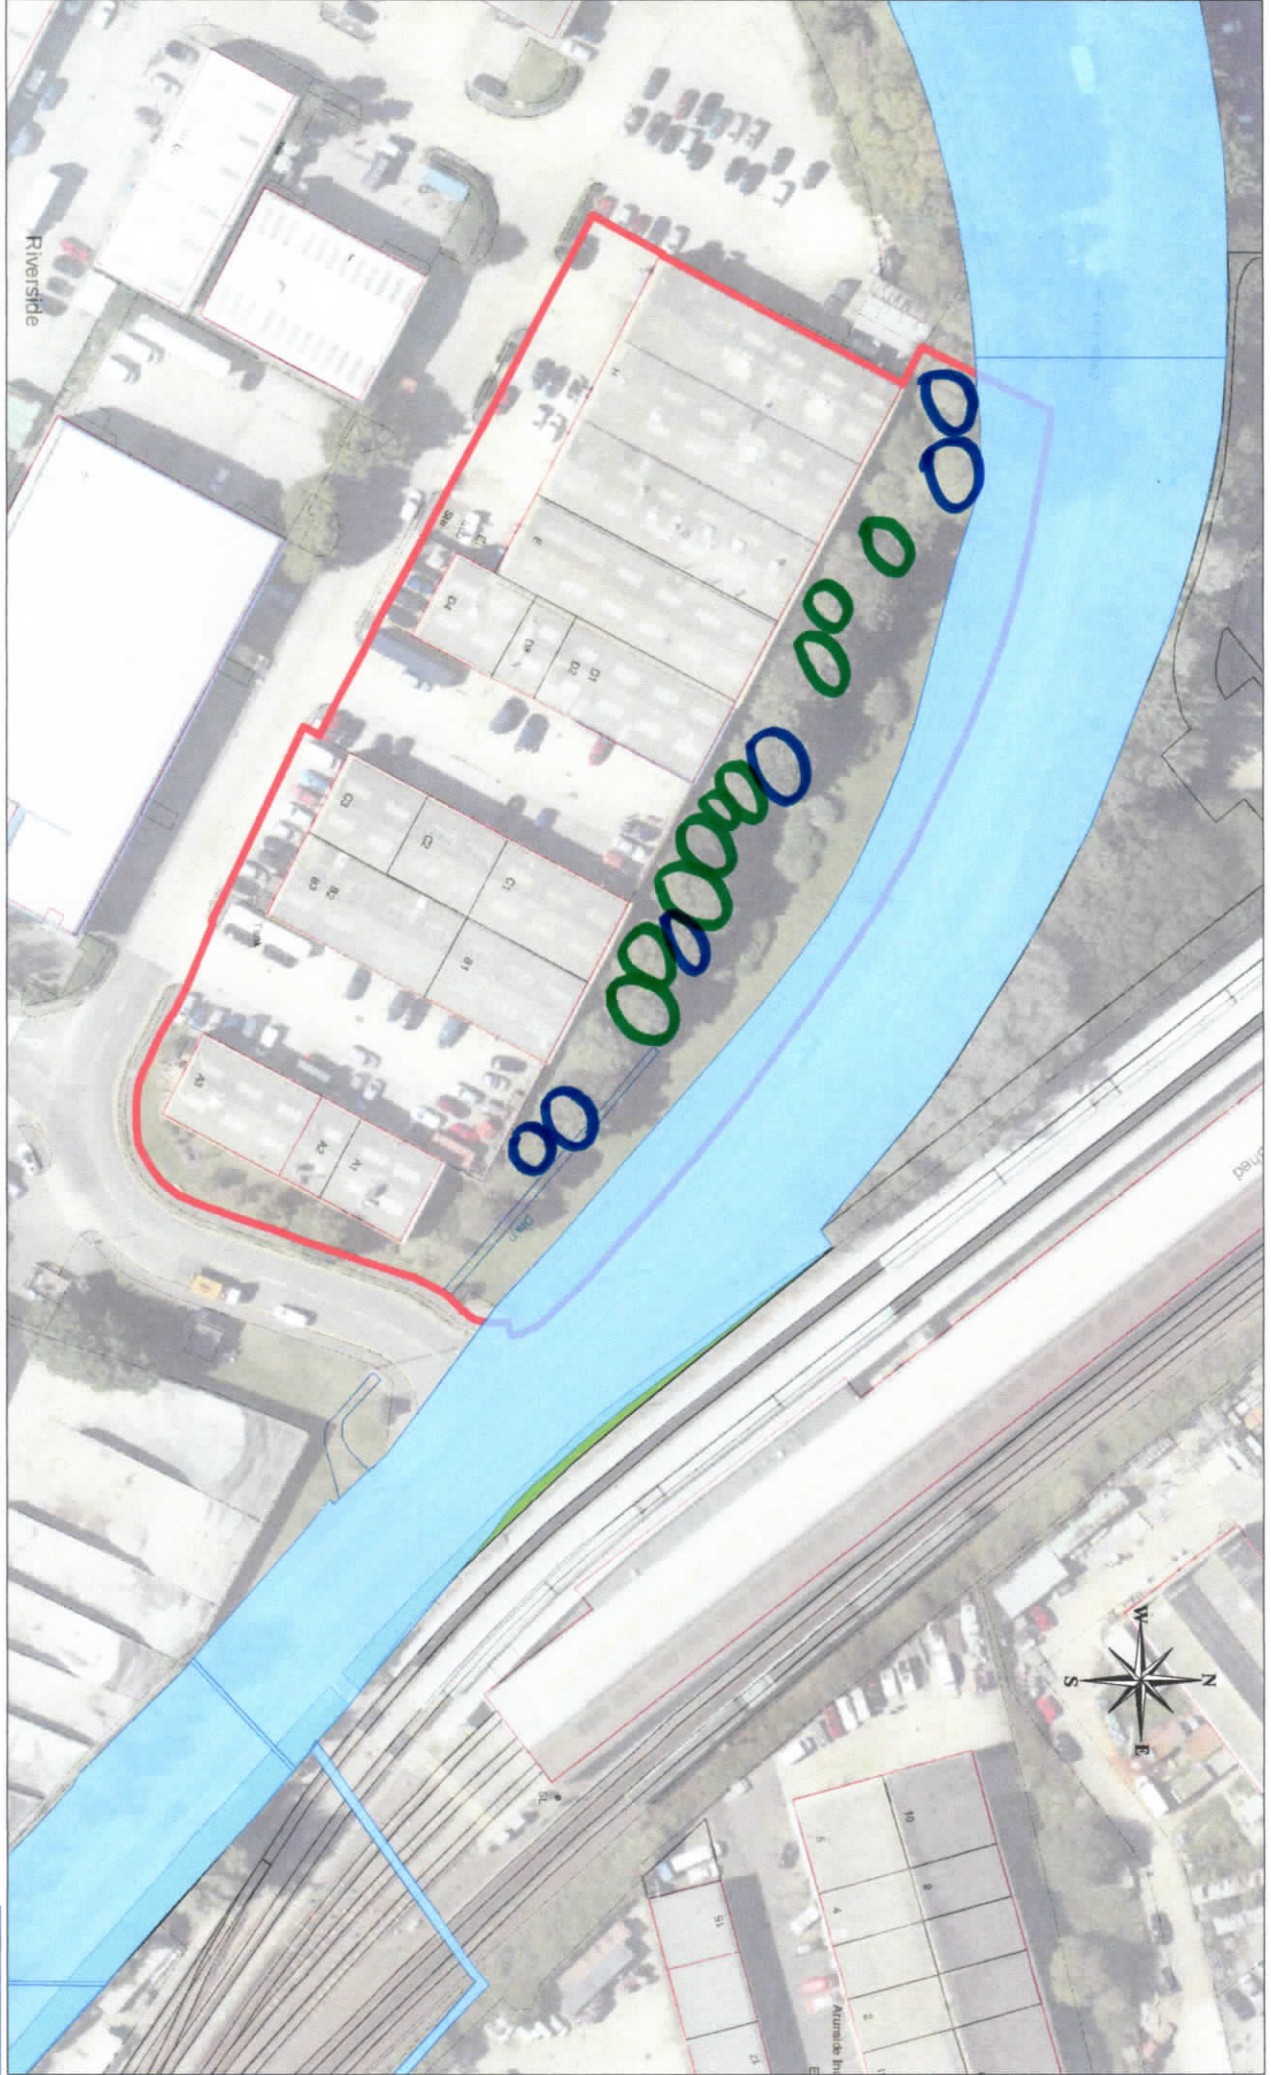

Red line denotes TPO'd trees

© Arun District Council and Crown Copyright. All rights reserved. Licence No: 100018487, 2015
Production Date: 09 November 2015

○ = Scots Pine x 9
○ = Sycamores x 6