



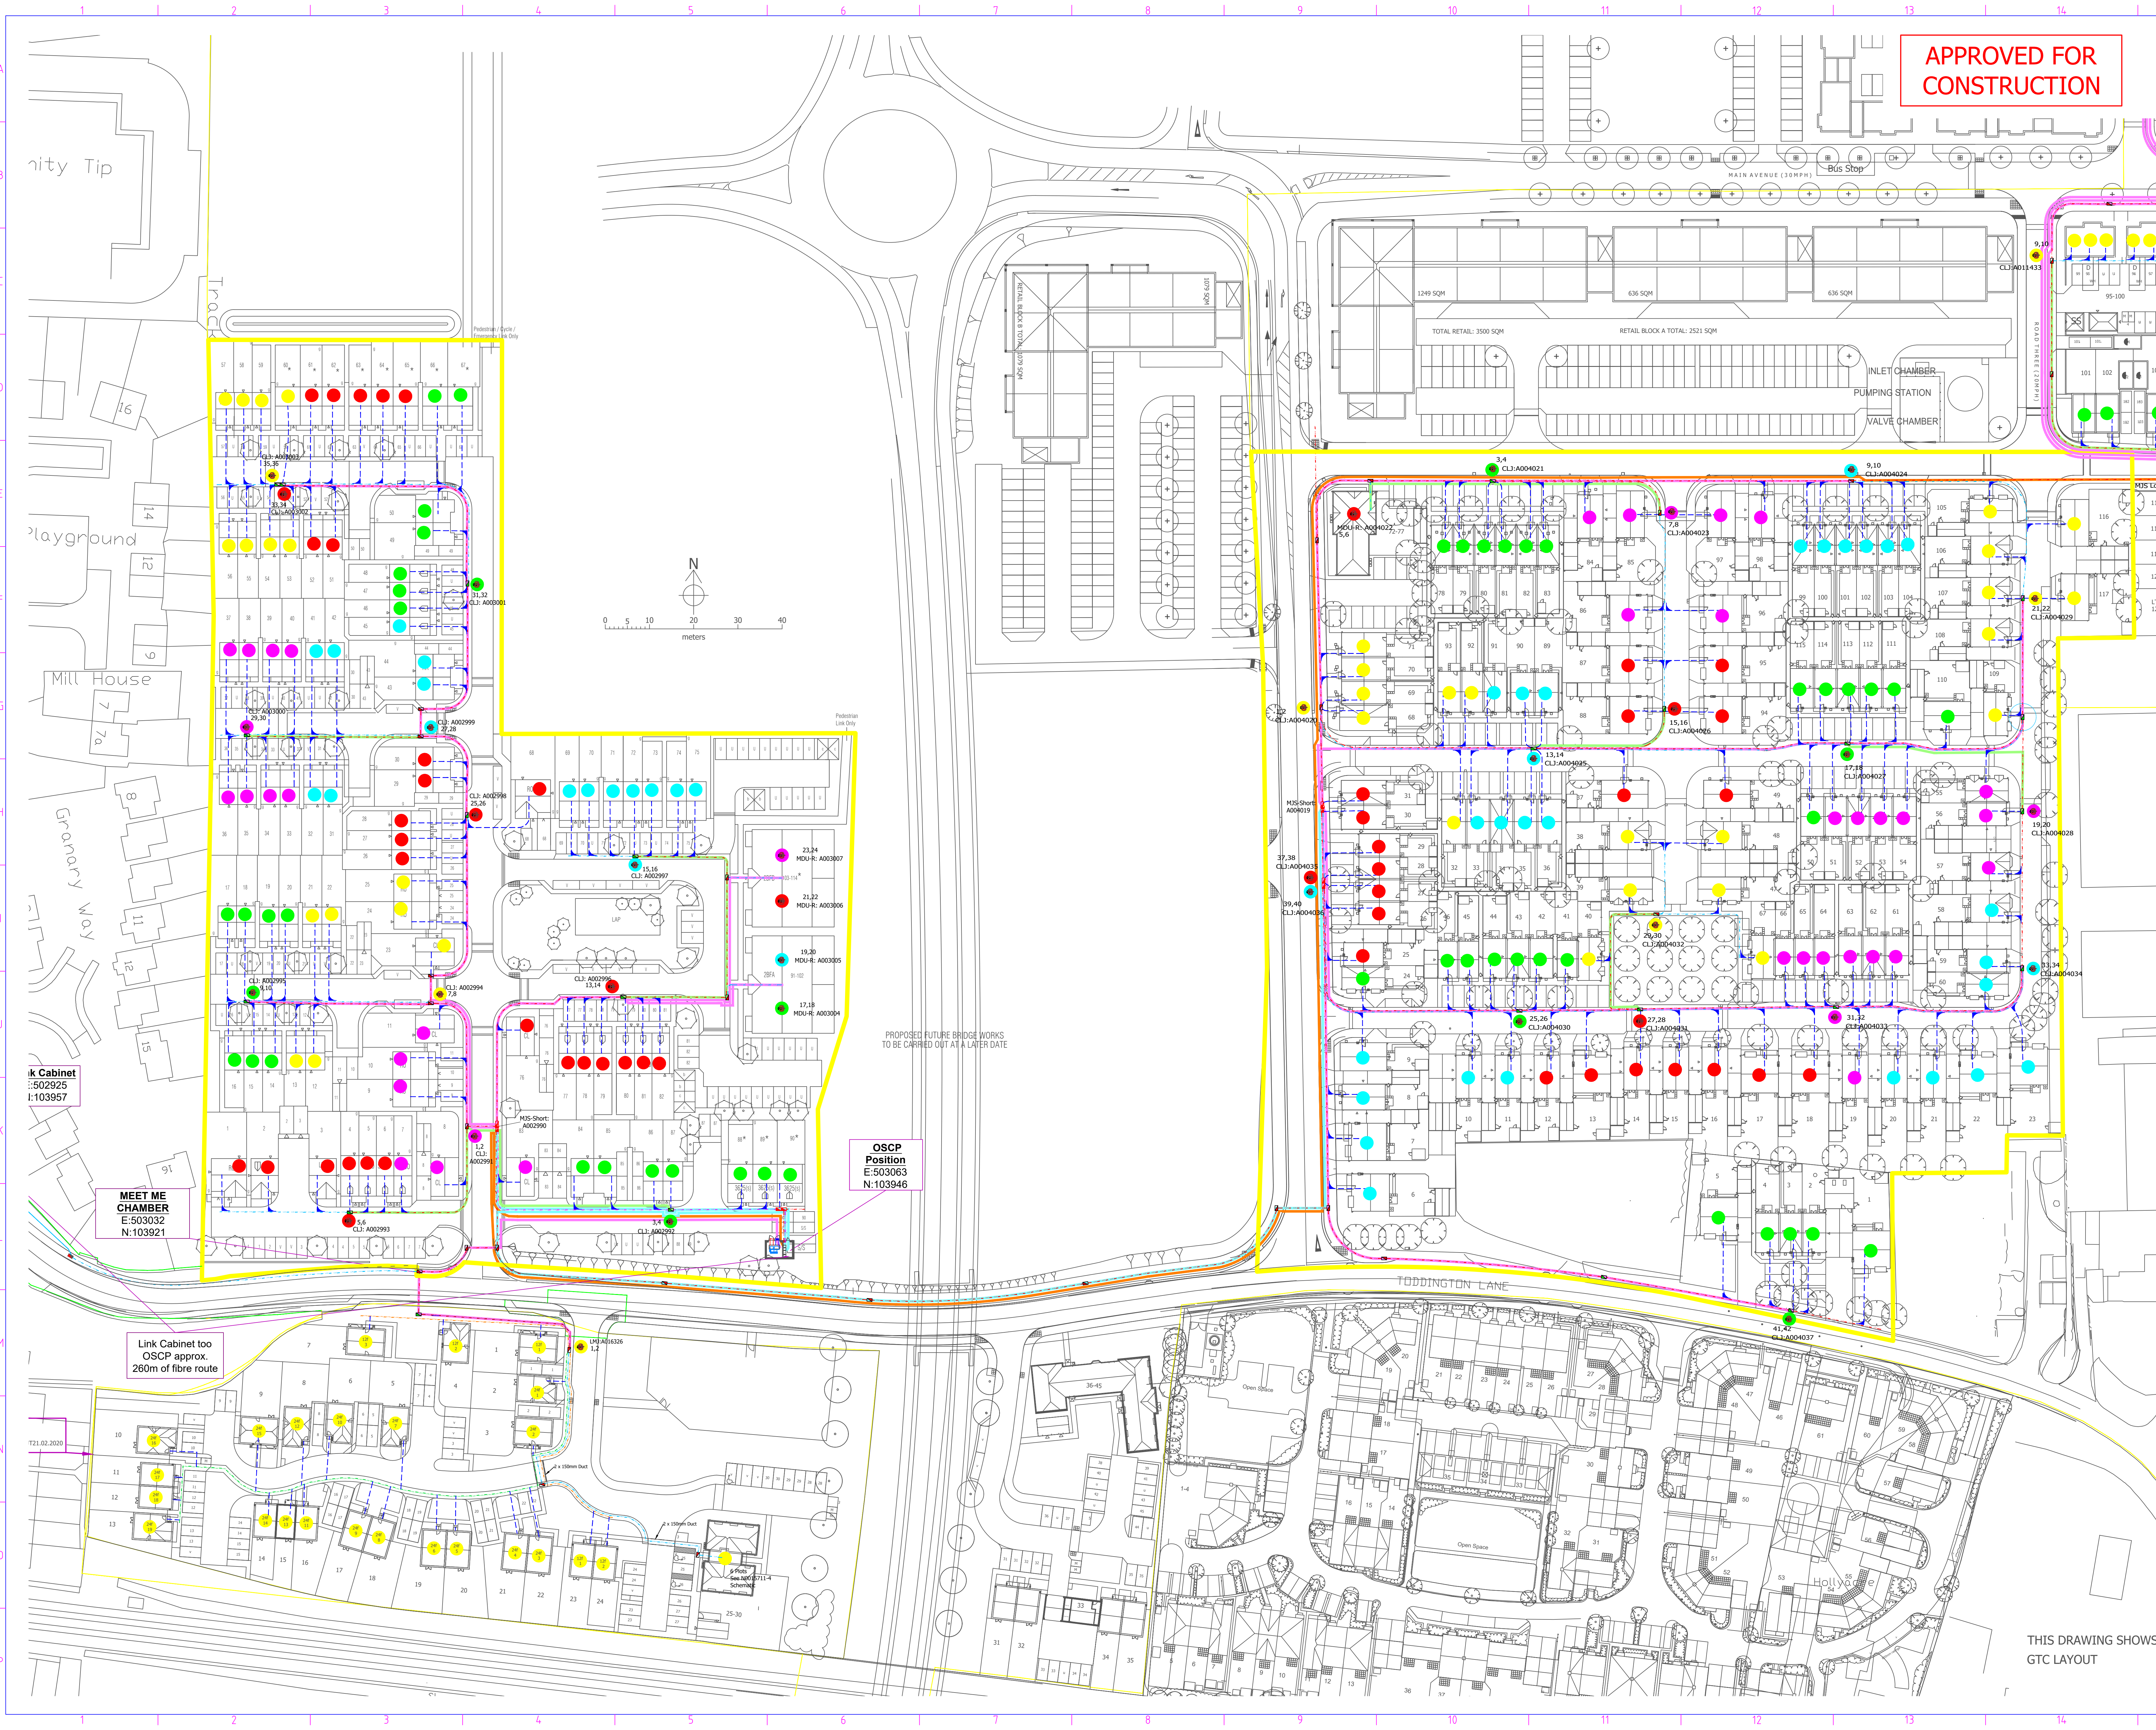

Rev	Revision Note	Date	Drawn by	Approved
1-1	Sub project 2 added	09/04/16	LAP	DC
1-2	S278 works boundary and additional ducting added	27/07/16	DC	DC
1-3	Row phase -3 added	22/03/18	SC	N/A
1-4	Offsite as-laid added	14/05/18	JO	DC
1-5	As Laid Data added from Job ID: 2476644 & 2476645; As Laid tube added	30/01/19	SH	N/A
1-6	As Laid Data added from Job ID: 2320759, 2358077, 2407882, 2425724, 2445416, 2439731, 2468741	25/02/19	BW	N/A
1-7	As Laid Data added as per RA, 3PDC: 239265 & 239293	17/05/19	SH	N/A
1-8	As Laid Data added as per SW, 3PDC: 239283	14/06/19	HW	N/A
1-9	As Laid Data added from Job ID: 2602871, 2614266, 2626243, 2626328	24/01/20	HW	N/A
2-0	N0015711-4 Added	12/06/20	CO	CC

Fibre Allocation Design Layer		
288 Fibre		
144 Fibre		
96 Fibre		
48 Fibre		
24 Fibre		
12 Fibre		
4 Fibre		
Verticasa		
Telecom's Infrastructure Legend		
Proposed	As-Laid	
As Laid Data added from Job ID: 2476644 & 2476645; As Laid tube added		
As Laid Data added from Job ID: 2320759, 2358077, 2407882, 2425724, 2445416, 2439731, 2468741		
As Laid Data added as per RA, 3PDC: 239265 & 239293		
As Laid Data added as per SW, 3PDC: 239283		
As Laid Data added from Job ID: 2602871, 2614266, 2626243, 2626328		
N0015711-4 Added		
As Laid Data added from Job ID: 2476644 & 2476645; As Laid tube added		
As Laid Data added from Job ID: 2320759, 2358077, 2407882, 2425724, 2445416, 2439731, 2468741		
As Laid Data added as per RA, 3PDC: 239265 & 239293		
As Laid Data added as per SW, 3PDC: 239283		
As Laid Data added from Job ID: 2602871, 2614266, 2626243, 2626328		
N0015711-4 Added		

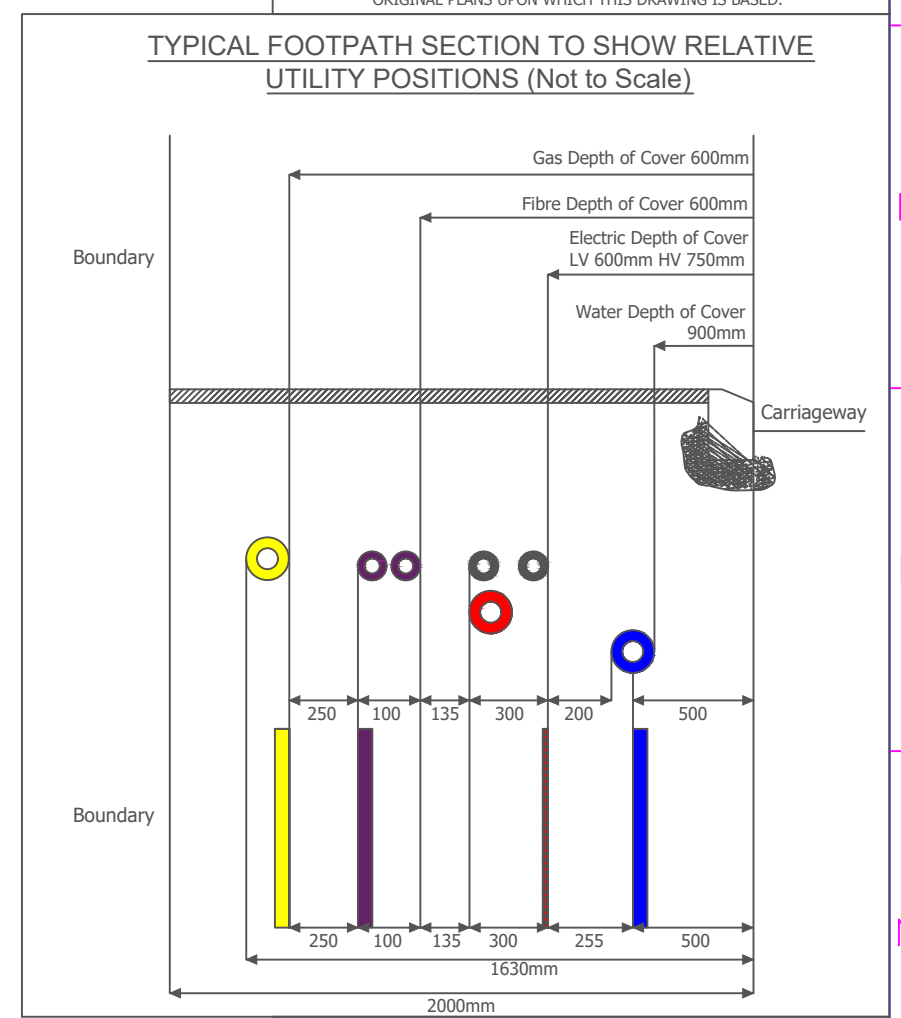

This plan shows the proposed fibre network layout as carried out by GTC Design Engineer. The information shown on this plan is given without warranty, the accuracy thereof is not guaranteed. No liability of any kind whatsoever is accepted by GTC for any loss or damage, including consequential loss, arising from the use of this plan. It is the responsibility of the client to ensure that the information provided is correct and that it is used for the purpose intended. The plan is not to be used for any other purpose without the written consent of GTC.

Drawing Scale : 1:500
O.S. REF : 503063, 103946
Network Number : N0015711-1
Linked Networks :
Drawing Number : N0015711-1_R1-9_2_of_9

Developer : Persimmon Homes Ltd
Location : Toddington Lane
Littlehampton
BN17 7PP

THIS DRAWING SHOWS:
GTC LAYOUT