



EXISTING APPROVED 126 UNIT SCHEME
CURRENTLY UNDER CONSTRUCTION

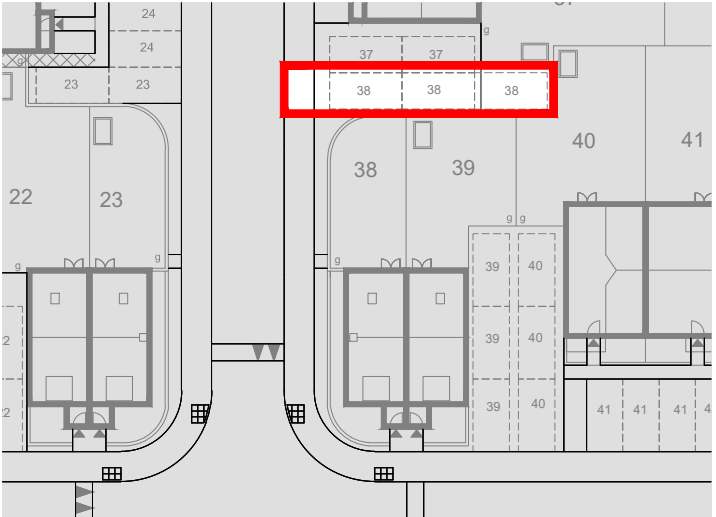


able Discharge=
es / Second

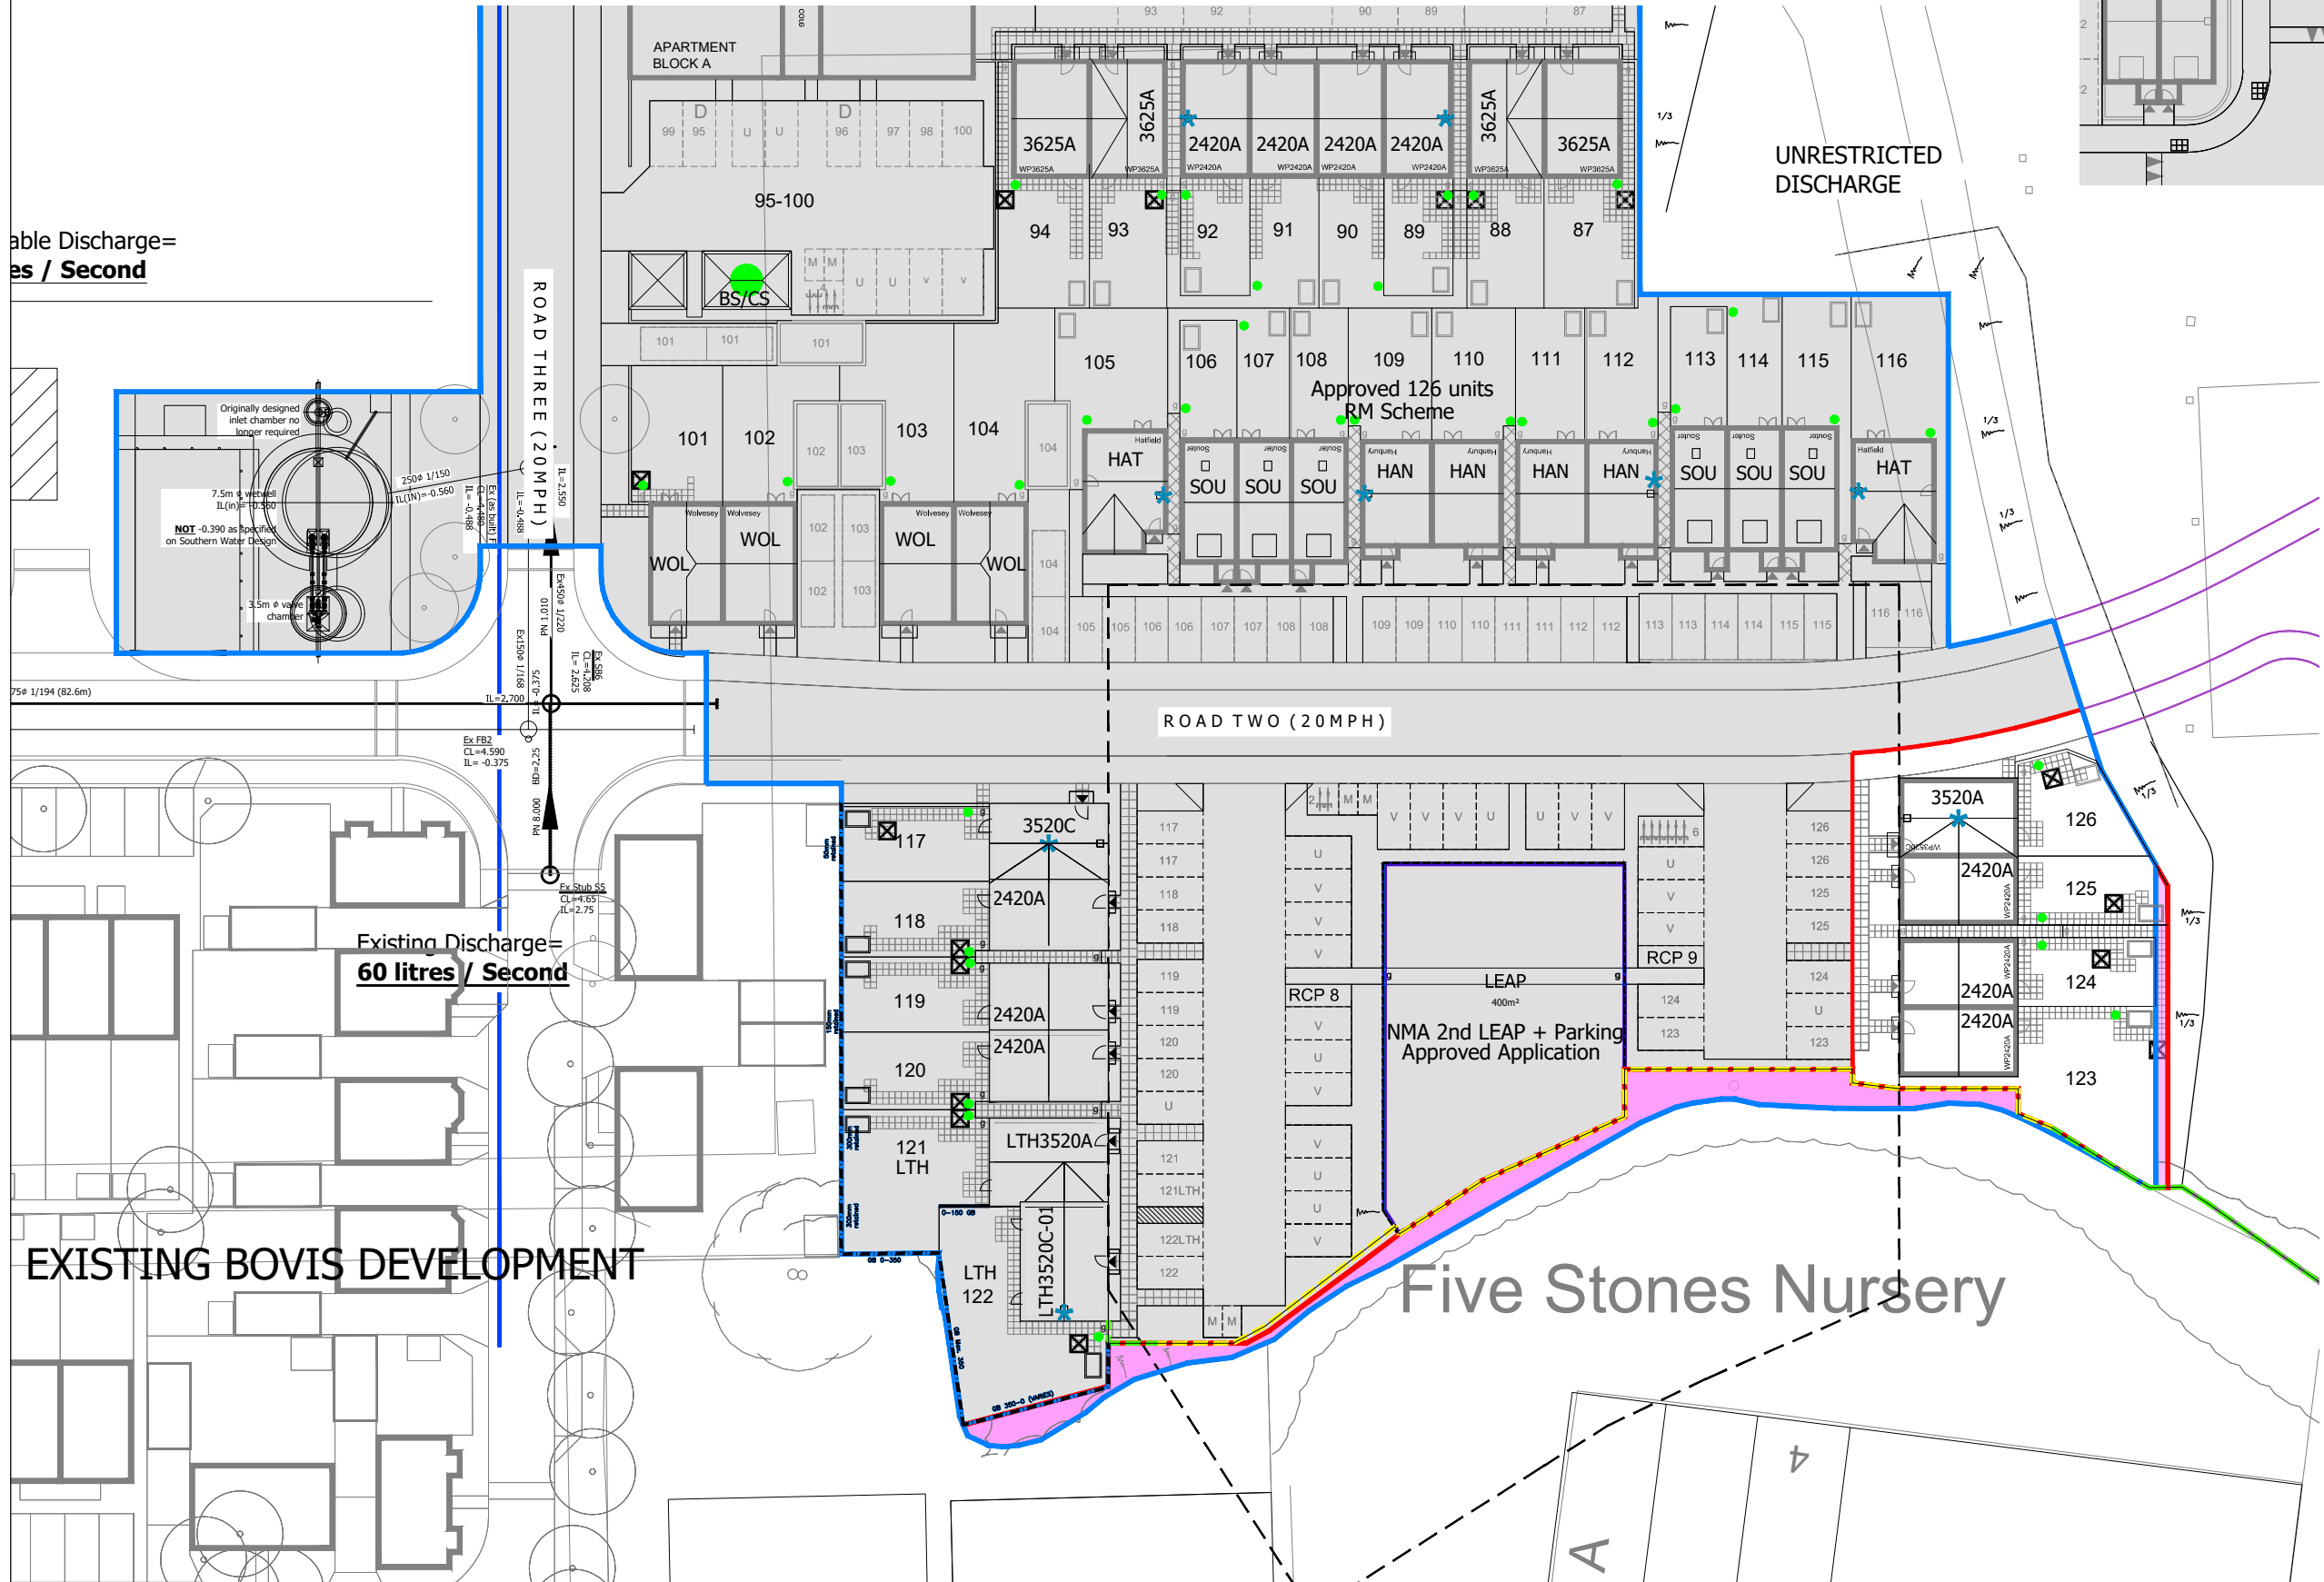

UNRESTRICTED
DISCHARGE

- LEGEND
- Proposed 3rd NMA Application Boundary
 - Redline Boundary
 - Approved LU/121/17/RES Application Boundary
 - Location of Proposed 2.8m Acoustic Fence on retaining wall.
 - Location of Proposed 2.8m Acoustic Fence
 - Location of required gravel board - as per Engineer's details
 - Areas already Approved.

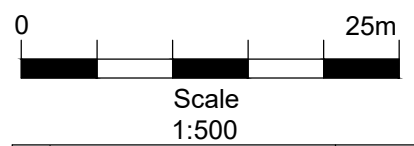

Rev		Date	
 PERSIMMON Together, we make a home			
Persimmon Homes Thames Valley Persimmon House, Knoll Road, Camberley, Surrey GU15 3TQ Tel: 01276 808080			
Site:	Phase 2 Littlehampton		Date: Jan. 2021
	Scale: 1:500 @ A3		
	Org No: 543_PL_APP3_100		
Drawing Title: 3rd NMA Application Site Layout - Plots 123 - 126 & Ancillary			
Drawing Status: SUBMITTED		Drawn by: AT	Checked by: ME/RC
		Rev:	