


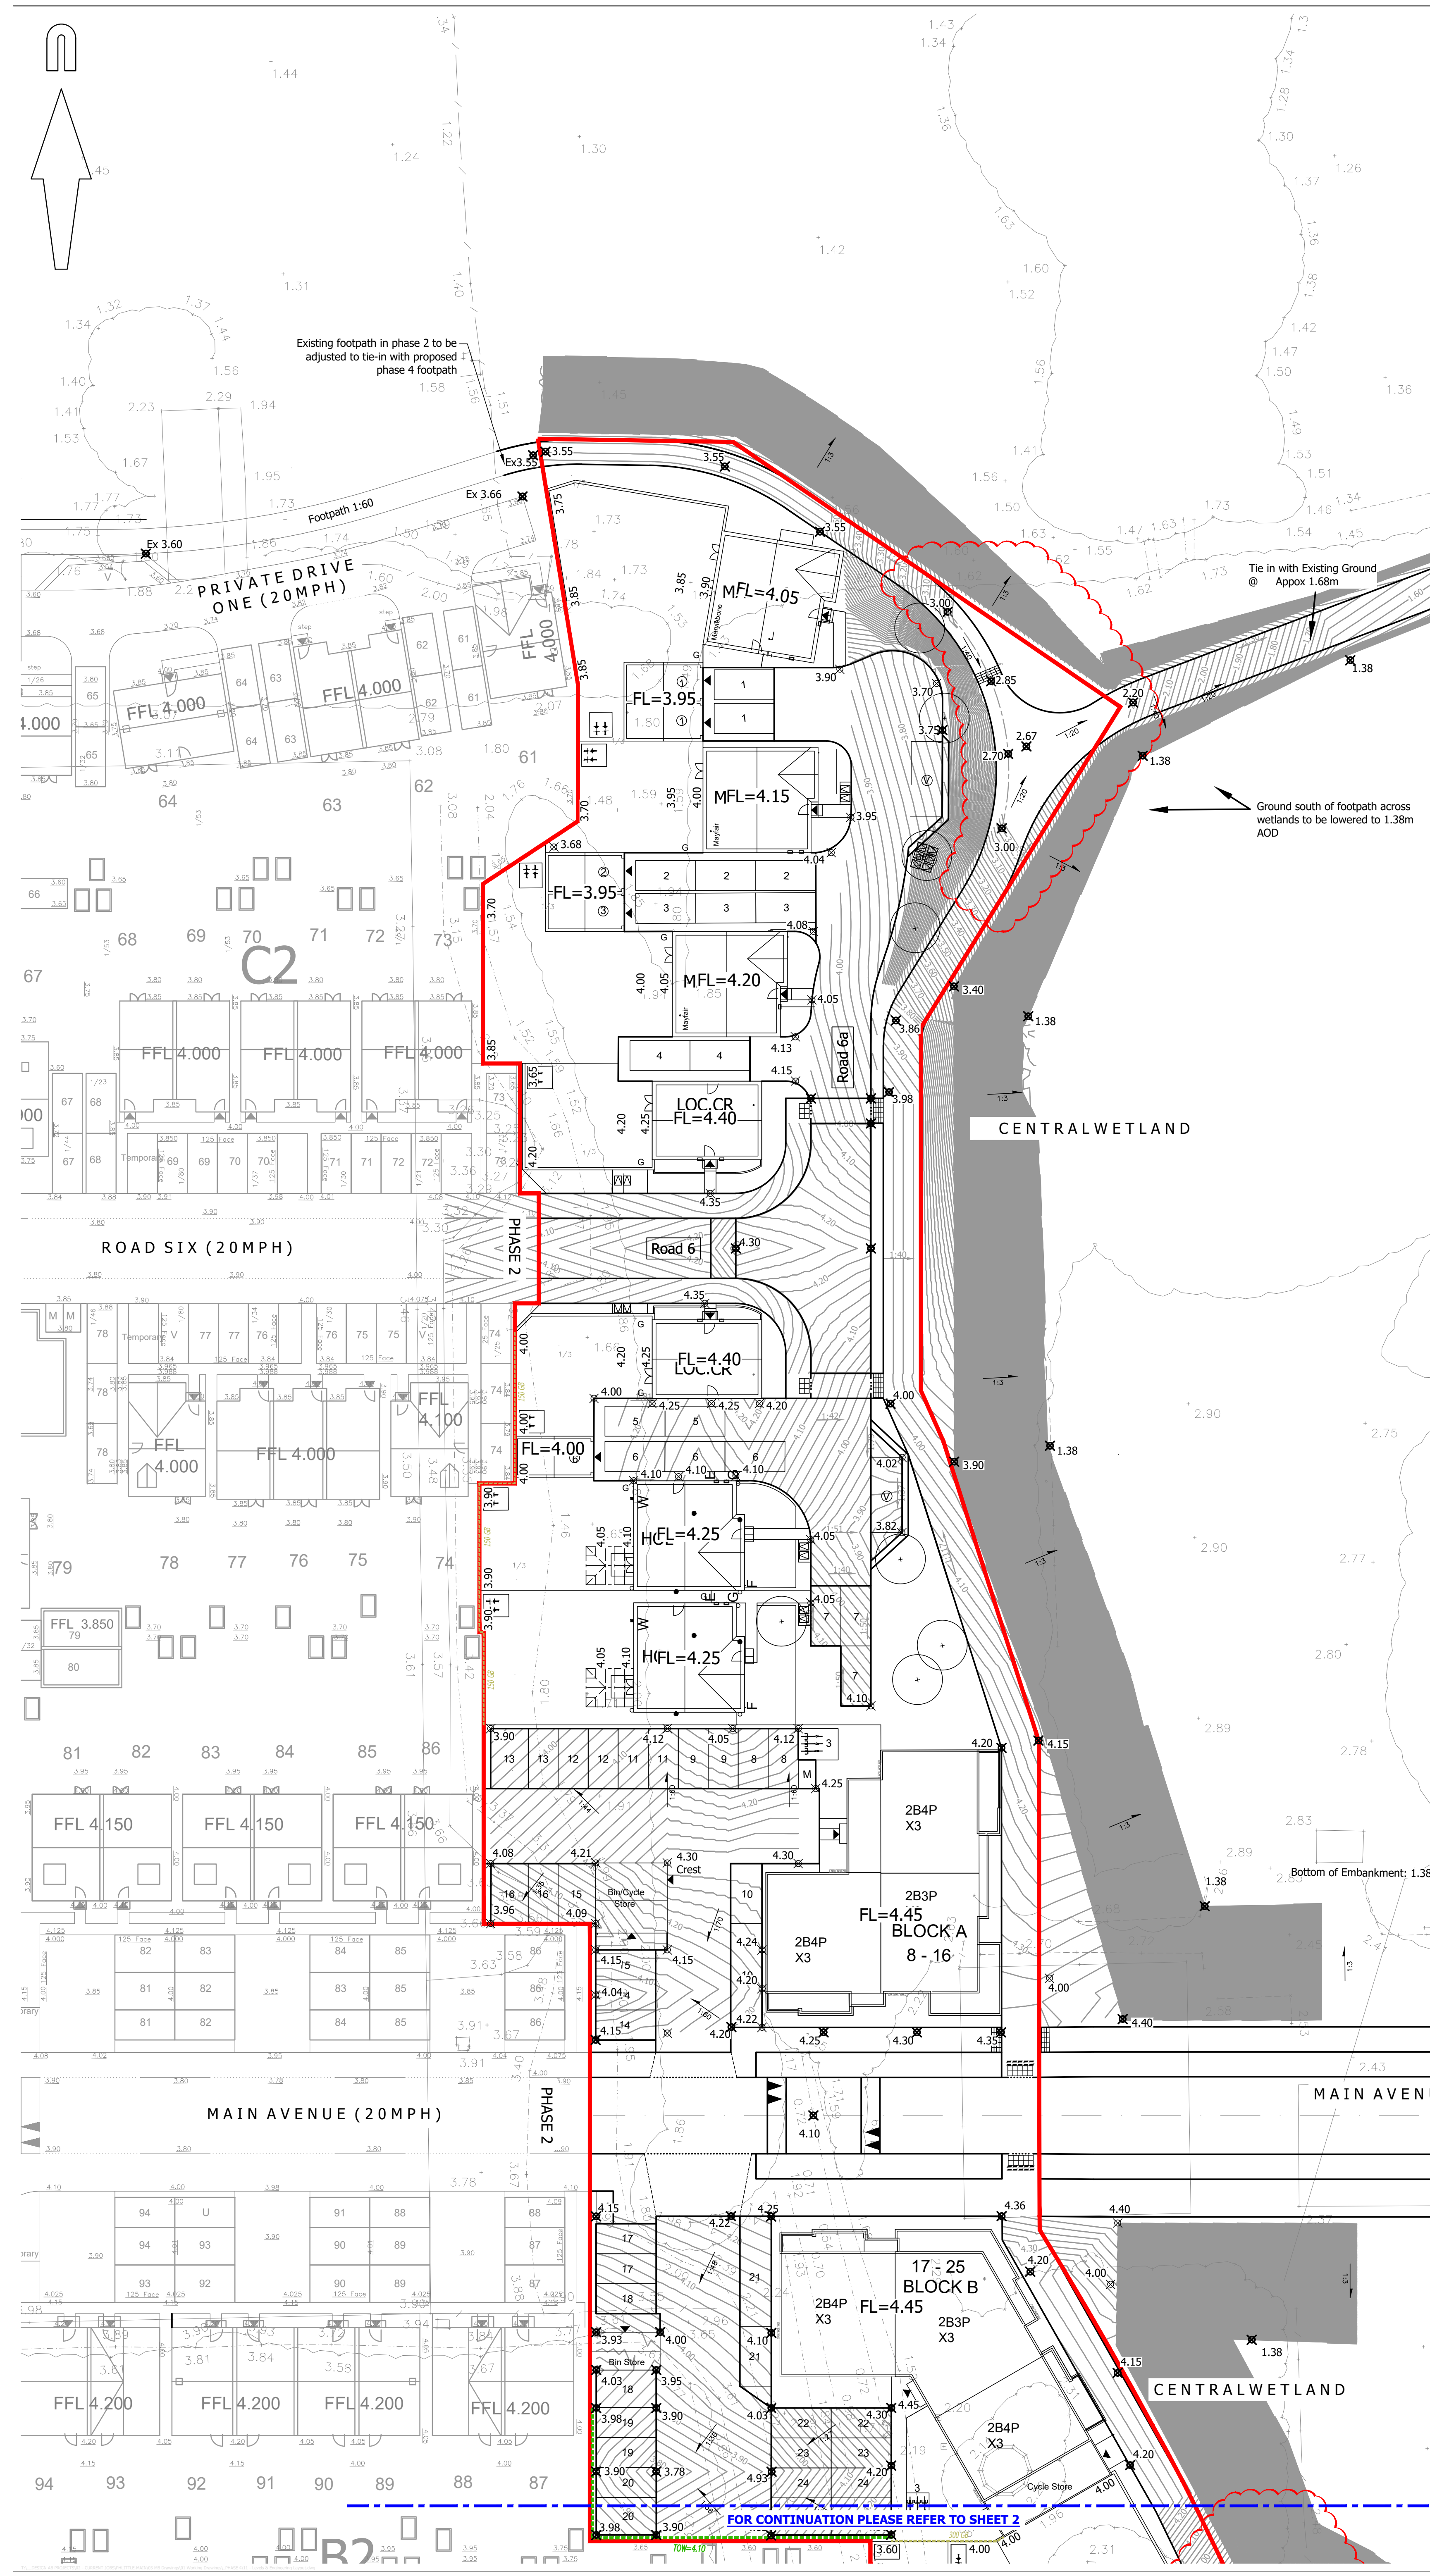

© Mayer Brown Limited Copyright. The drawings, information and data recorded in this document ("the information") is the property of Mayer Brown. This document and the information are solely for the use of the authorised recipient and this document may not be used, copied or reproduced in whole or part for any purposes other than which it was supplied by Mayer Brown. Mayer Brown makes no representation, undertakes no duty and accepts no responsibilities to any third party who may use or rely upon this document or the information.

A1 ORIGINAL

© Crown copyright and database rights 2021. Ordnance Survey 0100031673.

LEVELS KEY:

- FL=1.45
 - 1/100
 - 4.35
 - 150 GB
 - TOW=3.85
 - 4.35
 - 4.00
 - 1/12
 - SITE BOUNDARY
- PROPOSED FLOOR LEVEL
PROPOSED GRADIENT
PROPOSED SPOT LEVEL
PROPOSED GRAVEL BOARD RETENTION
PROPOSED RETAINING WALL
PROPOSED CONTOUR
PHASE 2 PROPOSED SPOT LEVEL
PHASE 2 PROPOSED GRADIENT

NOTES:

- This drawing is not to be scaled.
- Drawing based on Persimmon Homes Thames Valley Architect's 'Site Layout' drawing reference 545_PL_101, received on 04/06/2020.

FOR INFORMATION NOT FOR CONSTRUCTION

P6	Junction between footpath linking phase 2 and 4, and cycleway amended to match revised Architect's layout received on 26/03/2021 (clouded). Red line boundary amended. (IC)	SF	30/03/21
P5	Footpath linking phase 2 and 4 amended to a constant 2m width. (TC)	SF	18/03/21
P4	Drawing updated following revised layout. (TC)	SF	02/10/20
P3	Kerbs updated in parking courts A & B and along the main avenue. (TC)	SF	09/06/20
P2	Drawing updated following revised layout. (TC)	SF	05/06/20
P1	Initial Issue. (TC)	SF	14/04/20

rev.	amendment	checked	date
------	-----------	---------	------



Mayer Brown Limited
Lion House Oriental Road Woking Surrey GU22 8AR
Telephone 01483 750 508 Fax 01483 750 437
wokingoffice@mayerbrown.co.uk www.mayerbrown.co.uk

client
PERSIMMON HOMES THAMES VALLEY

project
PHASE 4
LITTLEHAMPTON

scale
1:250

drawn by
TC

checked by
SF

date
FEBRUARY 2020

cad file
11.DWG

title
ENGINEERING AND LEVELS DRAWING
(SHEET 1 OF 3)

Mayer Brown Limited jobcode
suitability
revision
P6

drawing number
PHLITTLE P4-11-1



© Mayer Brown Limited Copyright. The drawings, information and data recorded in this document ("the information") is the property of Mayer Brown. This document and the information are solely for the use of the authorised recipient and this document may not be used, copied or reproduced in whole or part for any purposes other than which it was supplied by Mayer Brown. Mayer Brown makes no representation, undertaking or warranty as to the accuracy or completeness of the information who may use or rely upon this document or the information.

A1 ORIGINAL

© Crown copyright and database rights 2021. Ordnance Survey 0100031673.

LEVELS KEY:

- FL=1.45 PROPOSED FLOOR LEVEL
- 1/200 PROPOSED GRADIENT
- 4.35 PROPOSED SPOT LEVEL
- 150 GB PROPOSED GRAVEL BOARD RETENTION
- TOW=3.85 PROPOSED RETAINING WALL
- 4.35 PROPOSED CONTOUR
- 4.00 PHASE 2 PROPOSED SPOT LEVEL
- 1/12 PHASE 2 PROPOSED GRADIENT
- ACOUSTIC FENCE DESIGNED BY OTHERS
- SITE BOUNDARY

NOTES:

- This drawing is not to be scaled.
- Drawing based on Persimmon Homes Thames Valley Architect's 'Site Layout' drawing reference 545_PL_101, received on 04/06/2020.

FOR INFORMATION NOT FOR CONSTRUCTION

P5	Footpath in clouded area amended to match revised Architect's layout received on 26/03/2021. Red line boundary amended. (TC)	SF	30/03/21
P4	Gravel board amended along boundary to the rear of plots 31-33. Bike storage in rear of plot 27 moved. (TC) (clouded).	SF	11/03/21
P3	Drawing updated following revised layout. (TC)	SF	02/10/20
P2	Drawing updated following revised layout. (TC)	SF	05/06/20
P1	Initial Issue. (TC)	SF	14/04/20

rev.	amendment	checked	date
------	-----------	---------	------



Mayer Brown Limited
Lion House Oriental Road Woking Surrey GU22 8AR
Telephone 01483 750 508 Fax 01483 750 437
wokingoffice@mayerbrown.co.uk www.mayerbrown.co.uk

client	PERSIMMON HOMES THAMES VALLEY		
project	PHASE 4 LITTLEHAMPTON		
scale	1:250	drawn by	TC
date	FEBRUARY 2020	checked by	SF
title	ENGINEERING & LEVELS DRAWING (SHEET 2 OF 3)		
Mayer Brown Limited jobcode	suitability	revision	
	-	P5	
drawing number	PHLITTLE P4-11-2		



© Mayer Brown Limited Copyright. The drawings, information and data recorded in this document ("the information") is the property of Mayer Brown. This document and the information are solely for the use of the authorised recipient and this document may not be used, copied or reproduced in whole or part for any purposes other than which it was supplied by Mayer Brown. Mayer Brown makes no representation, undertaking, no duty and accepts no responsibilities to any third party who may use or rely upon this document or the information.

A1 ORIGINAL

© Crown copyright and database rights 2020, Ordnance Survey 0100031673.

LEVELS KEY:

- FL=1.45 PROPOSED FLOOR LEVEL
- 1/200 PROPOSED GRADIENT
- 4.35 PROPOSED SPOT LEVEL
- 150 GB PROPOSED GRAVEL BOARD RETENTION
- TOW=3.85 PROPOSED RETAINING WALL
- 4.35 PROPOSED CONTOUR
- 4.09 PHASE 2 PROPOSED SPOT LEVEL
- 1/12 PHASE 2 PROPOSED GRADIENT
- SITE BOUNDARY

- NOTES:
- This drawing is not to be scaled.
 - Drawing based on Persimmon Homes Thames Valley Architect's 'Site Layout' drawing reference 545_PL_101, received on 04/06/2020.

FOR INFORMATION
NOT FOR CONSTRUCTION

P3	Drawing updated following revised layout. (TC)	SF	02/10/20
P2	Drawing updated following revised layout. (TC)	SF	05/06/20
P1	Initial Issue. (TC)	SF	14/04/20

rev.	amendment	checked	date
------	-----------	---------	------

Mayer Brown Limited
Lion House, Oriental Road, Woking, Surrey, GU22 8AR
Telephone 01483 750 508 Fax 01483 750 437
wokingoffice@mayerbrown.co.uk www.mayerbrown.co.uk

client
PERSIMMON HOMES THAMES VALLEY

project
PHASE 4
LITTLEHAMPTON

scale 1:250	drawn by TC	checked by SF
----------------	----------------	------------------

date FEBRUARY 2020	cad file 20.DWG
-----------------------	--------------------

title
ENGINEERING & LEVELS DRAWING
(SHEET 3 OF 3)

Mayer Brown Limited jobcode	suitability -	revision P3
-----------------------------	------------------	----------------

drawing number
PHLITTLE P4-11-3