


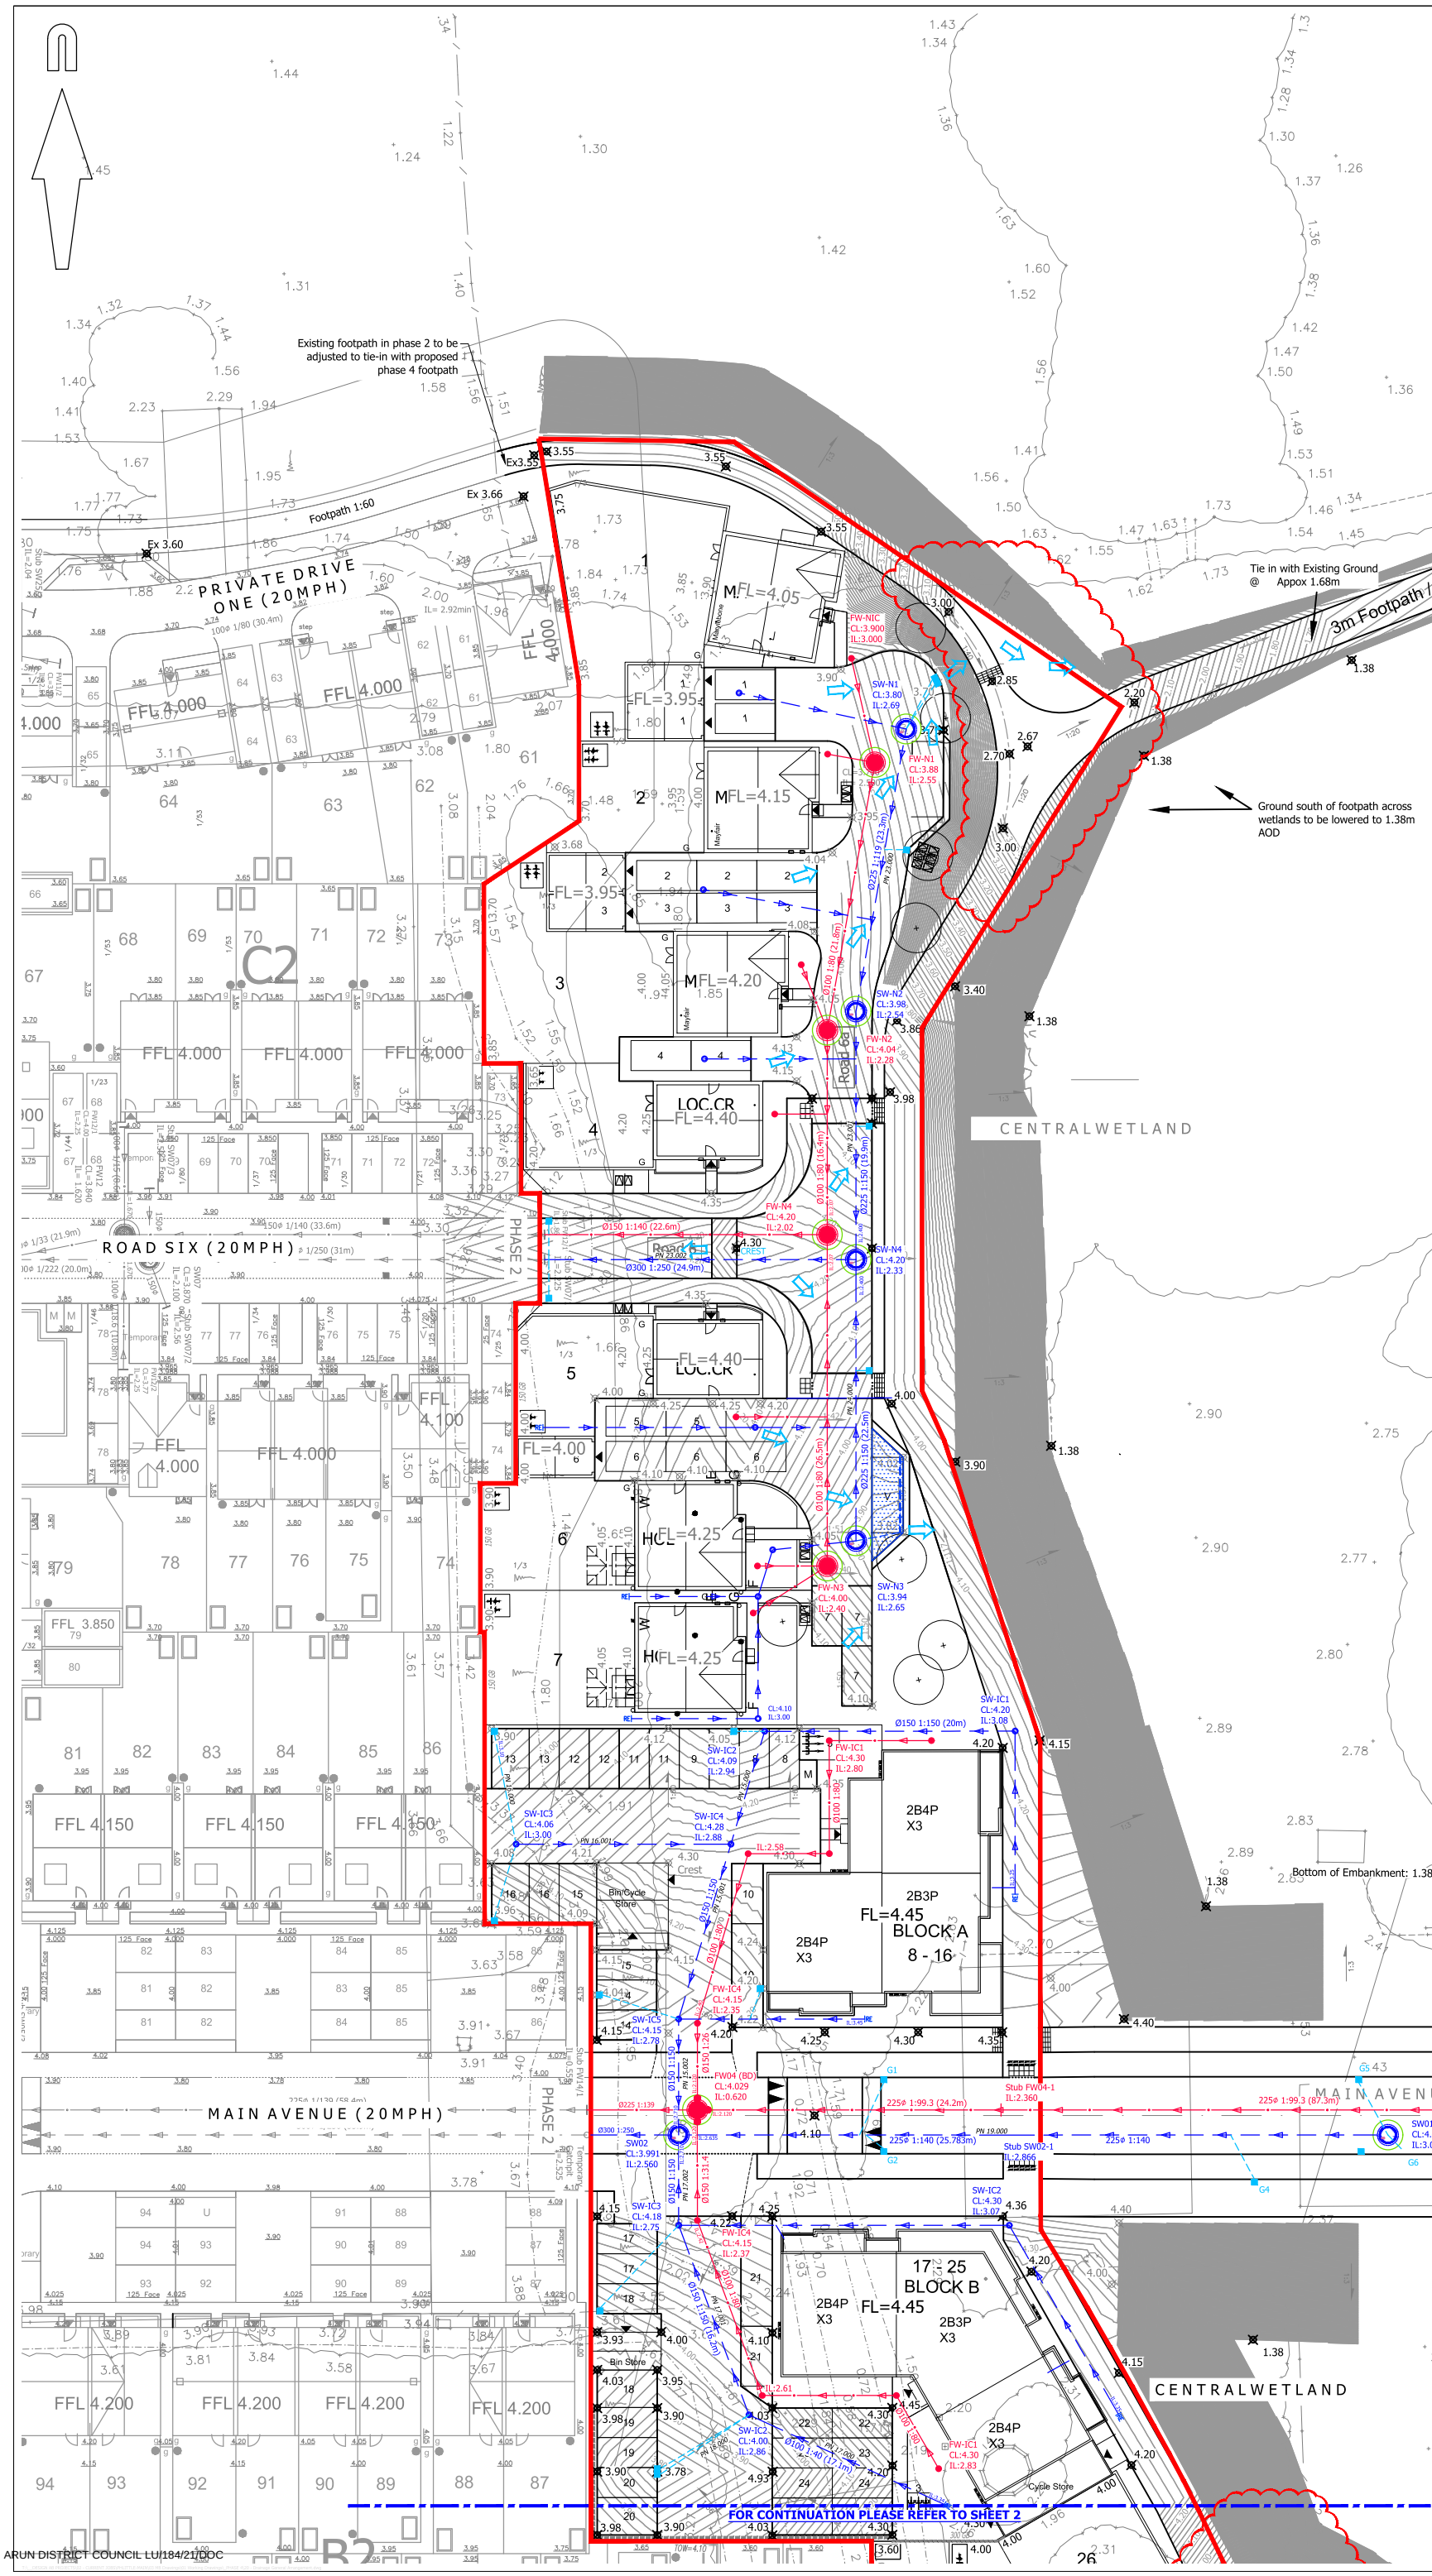

© Mayer Brown Limited Copyright. The drawings, information and data recorded in this document ("the information") is the property of Mayer Brown. This document and the information are solely for the use of the authorised recipient and this document may not be used, copied or reproduced in whole or part for any purposes other than which it was supplied by Mayer Brown. Mayer Brown makes no representation, undertakes no duty and accepts no responsibility to any third party who may use or rely upon this document or the information.

A1 ORIGINAL

© Crown copyright and database rights 2020. Ordnance Survey 0100031673.

DRAINAGE KEY:

- PROPOSED SURFACE WATER SEWER AND MANHOLE
- PROPOSED FOUL WATER SEWER AND MANHOLE
- PROPOSED FOUL WATER BACKDROP
- PROPOSED SURFACE WATER SEWER AND INSPECTION CHAMBER
- PROPOSED FOUL WATER SEWER AND INSPECTION CHAMBER
- PROPOSED ROAD GULLY
- PROPOSED RODDING EYE
- PROPOSED SURFACE WATER OUTFALL
- PROPOSED ATTENUATION TANK
- PROPOSED PERMEABLE PAVING & FIN DRAIN
- EXCEEDENCE FLOW ARROWS
- PROPOSED CONTOURS
- PROPOSED FOUL RISING MAIN
- SITE BOUNDARY

LEVELS KEY:

- PROPOSED FLOOR LEVEL
- PROPOSED GRADIENT
- PROPOSED GRAVEL BOARD RETENTION
- PROPOSED RETAINING WALL

FL=1.45
1/200
150.68
TCW=3.05

NOTES:

- This drawing is not to be scaled.
- Drawing based on Persimmon Homes Thames Valley Architect's 'Site Layout' drawing reference 545_PL_101, received on 04/06/2020.

FOR INFORMATION

NOT FOR CONSTRUCTION

P7	Junction between footpath linking phase 2 and 4, and cycleway amended to match revised Architect's layout received on 26/03/2021 (clouded). Red line boundary amended. (IC)	SF	30/03/21
P6	Footpath linking phase 2 and 4 amended to a constant 2m width. (TC)	SF	18/03/21
P5	Microdrainage pipe labels added. (TC)	SF	22/12/20
P4	Drawing updated following revised layout. Key Updated (TC)	SF	02/10/20
P3	Exceedence Flow Arrows Added (SF)	SF	06/07/20
P2	Kerbs updated in parking courts A & B and along the main avenue. (TC)	SF	09/06/20
P1	Initial Issue. (TC)	SF	04/06/2020

rev.	amendment	checked	date

mayer brown

Mayer Brown Limited
Lion House Oriental Road Woking Surrey GU22 8AR
Telephone 01483 750 508 Fax 01483 750 437
wokingoffice@mayerbrown.co.uk www.mayerbrown.co.uk

client

PERSIMMON HOMES THAMES VALLEY

project

PHASE 4
LITTLEHAMPTON

scale	drawn by	checked by
1:250	TC	SF

date	cad file
FEBRUARY 2020	20.DWG

title

PROPOSED DRAINAGE AND LEVELS DRAWING
(SHEET 1 OF 3)

Mayer Brown Limited jobcode	suitability	revision
	-	P7

drawing number

PHLITTLE P4-20-1