

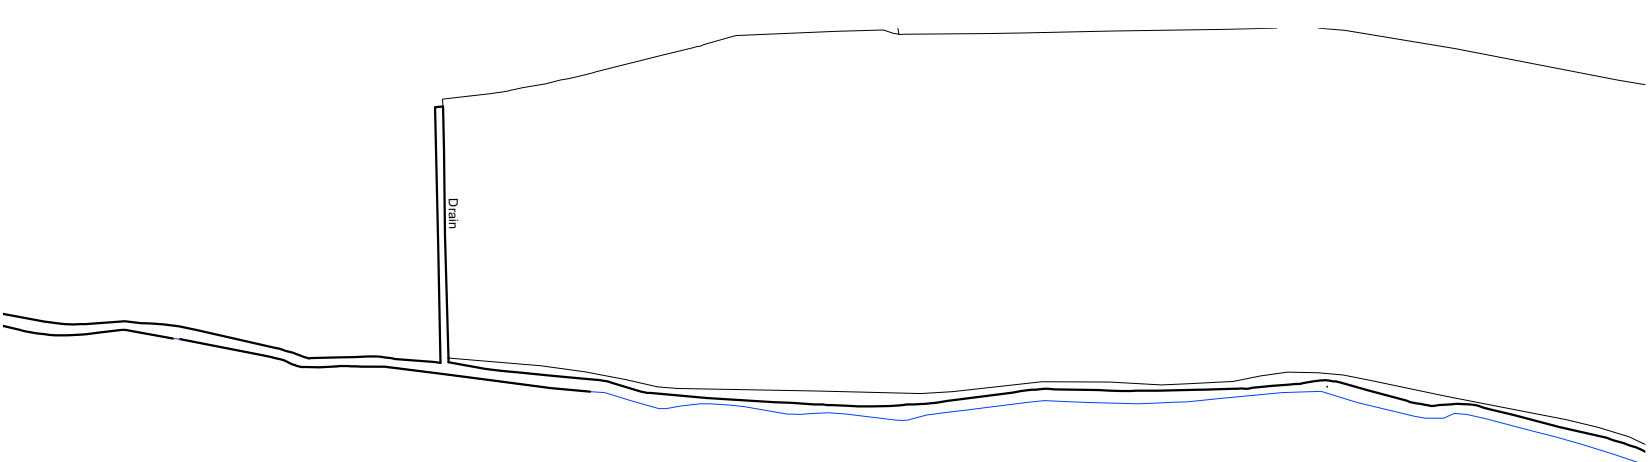
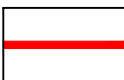
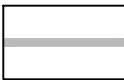
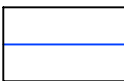


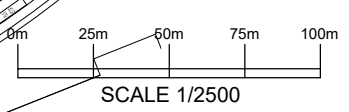

KEY:

-  Revised Redline for Phase 2B
2nd RM Application Redline Boundary
-  Approved Redline for Phase 2B
LU/178/20/RES
-  Overall Development Boundary

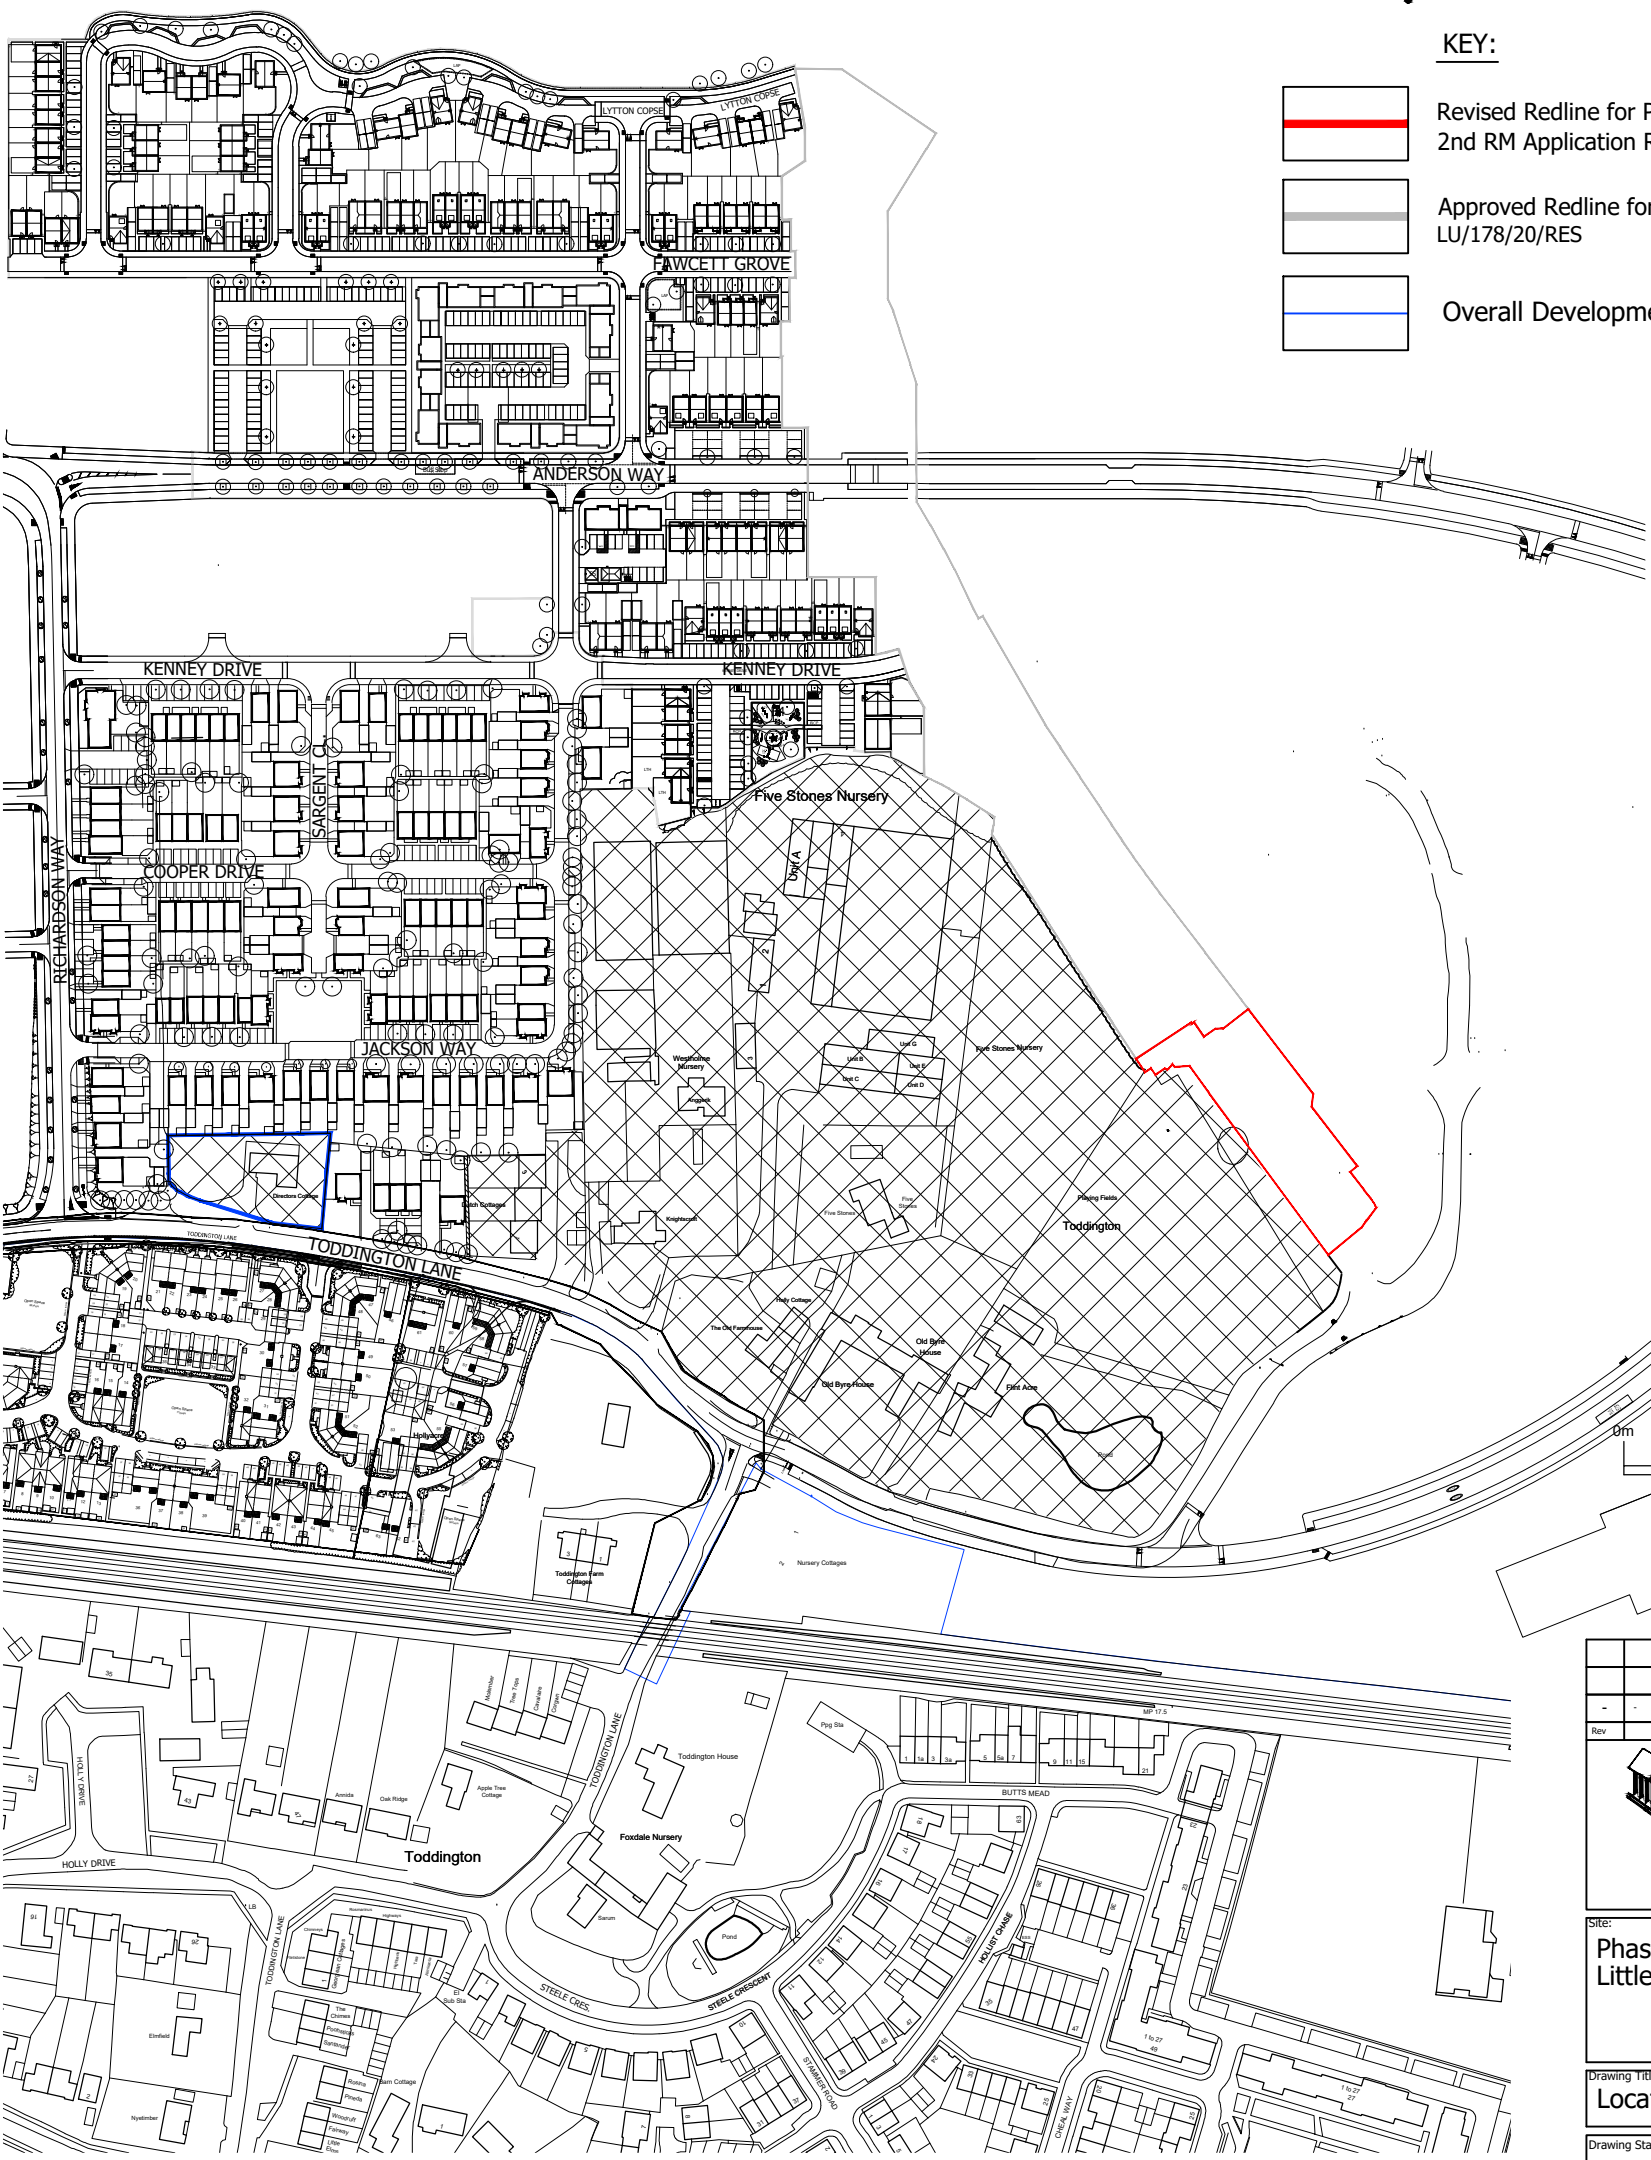

SCALE 1/2500

Rev		Date	
-		-	
 PERSIMMON Together, we make a home			
Persimmon Homes Thames Valley Persimmon House, Knoll Road, Camberley, Surrey GU15 3TQ Tel: 01276 808080			
Site: Phase 2B Littlehampton		Date: April 2021	
		Scale: 1:2500 @ A3P	
		Dwg No: 545_PL_AP2_001	
Drawing Title: Location Plan			
Drawing Status: SUBMITTED		Drawn by: AT	Checked by: RC
		Rev:	-