



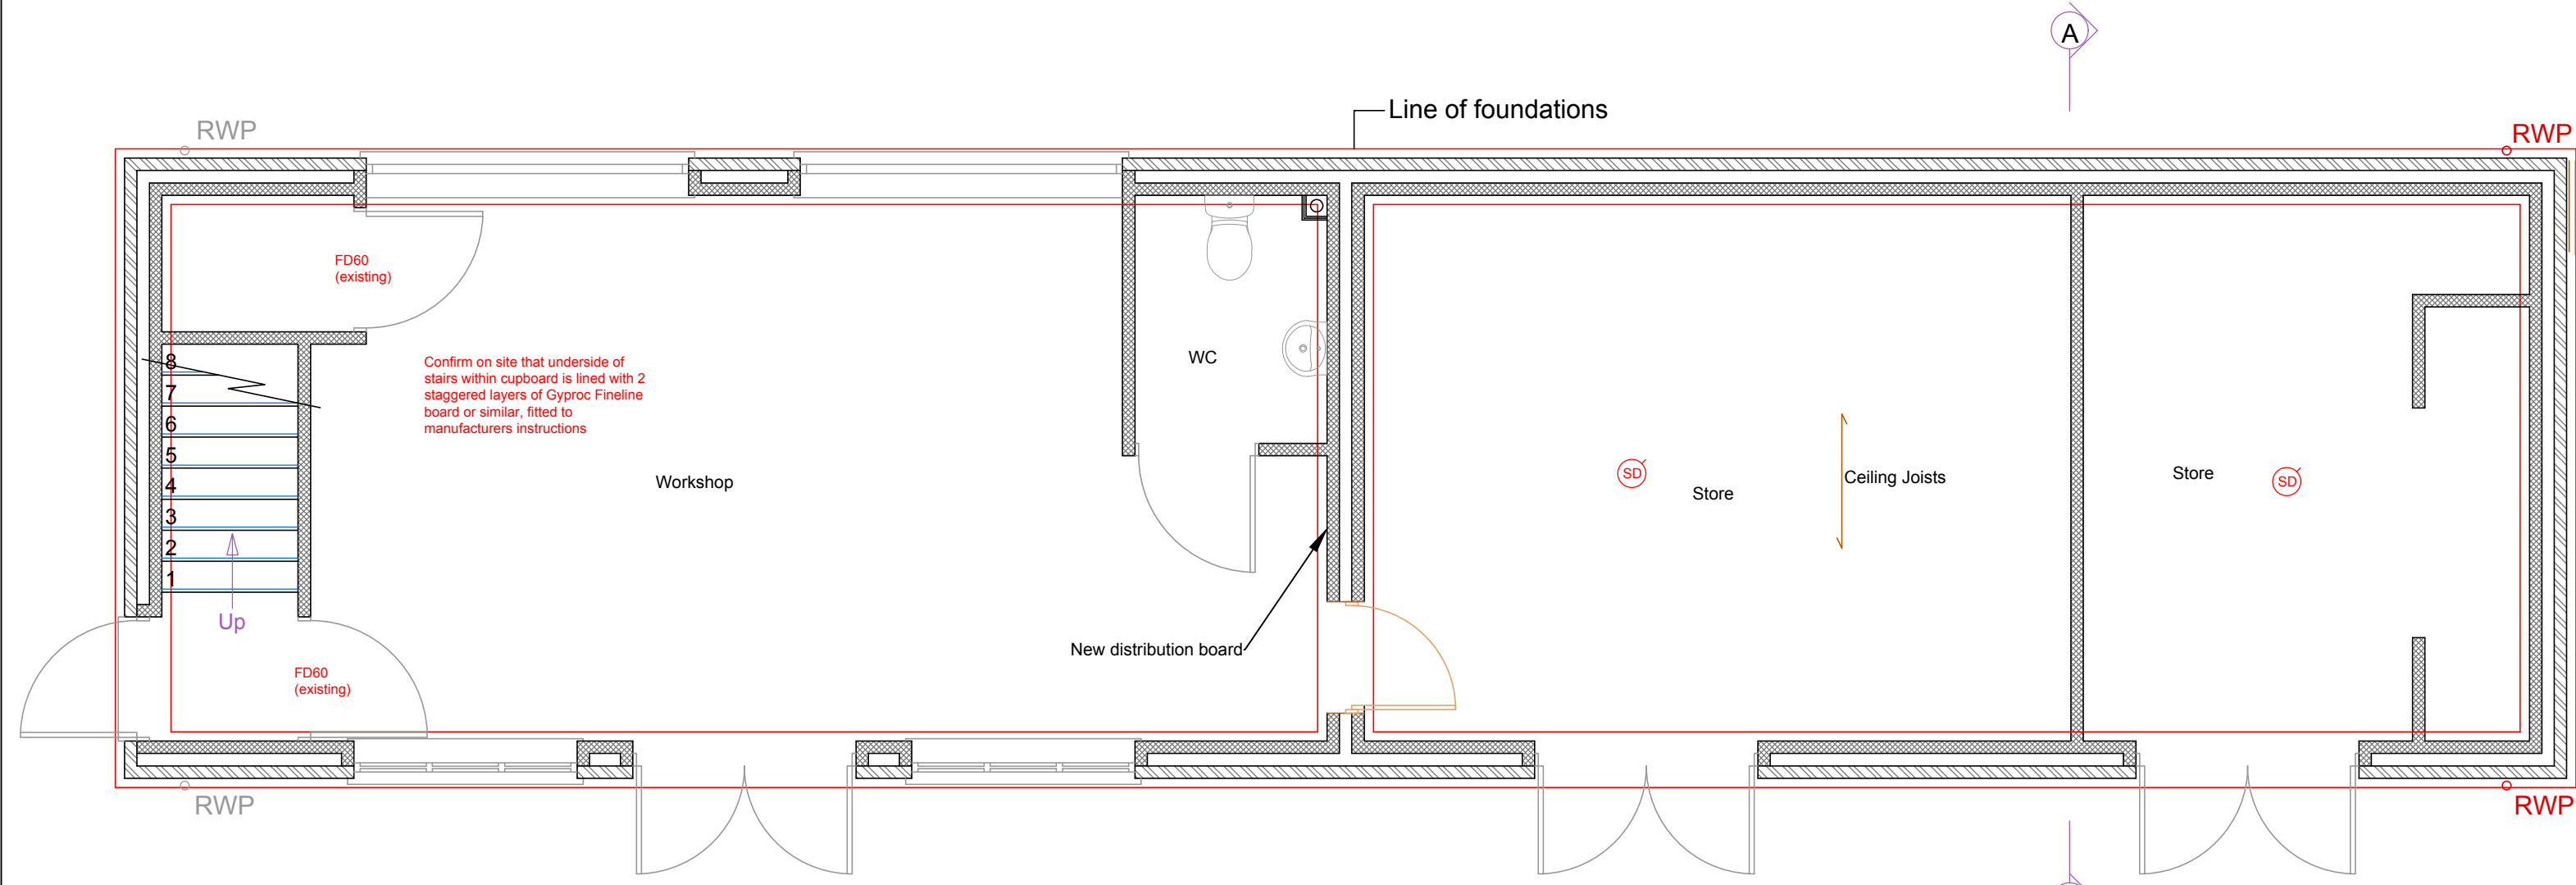


Ground Floor

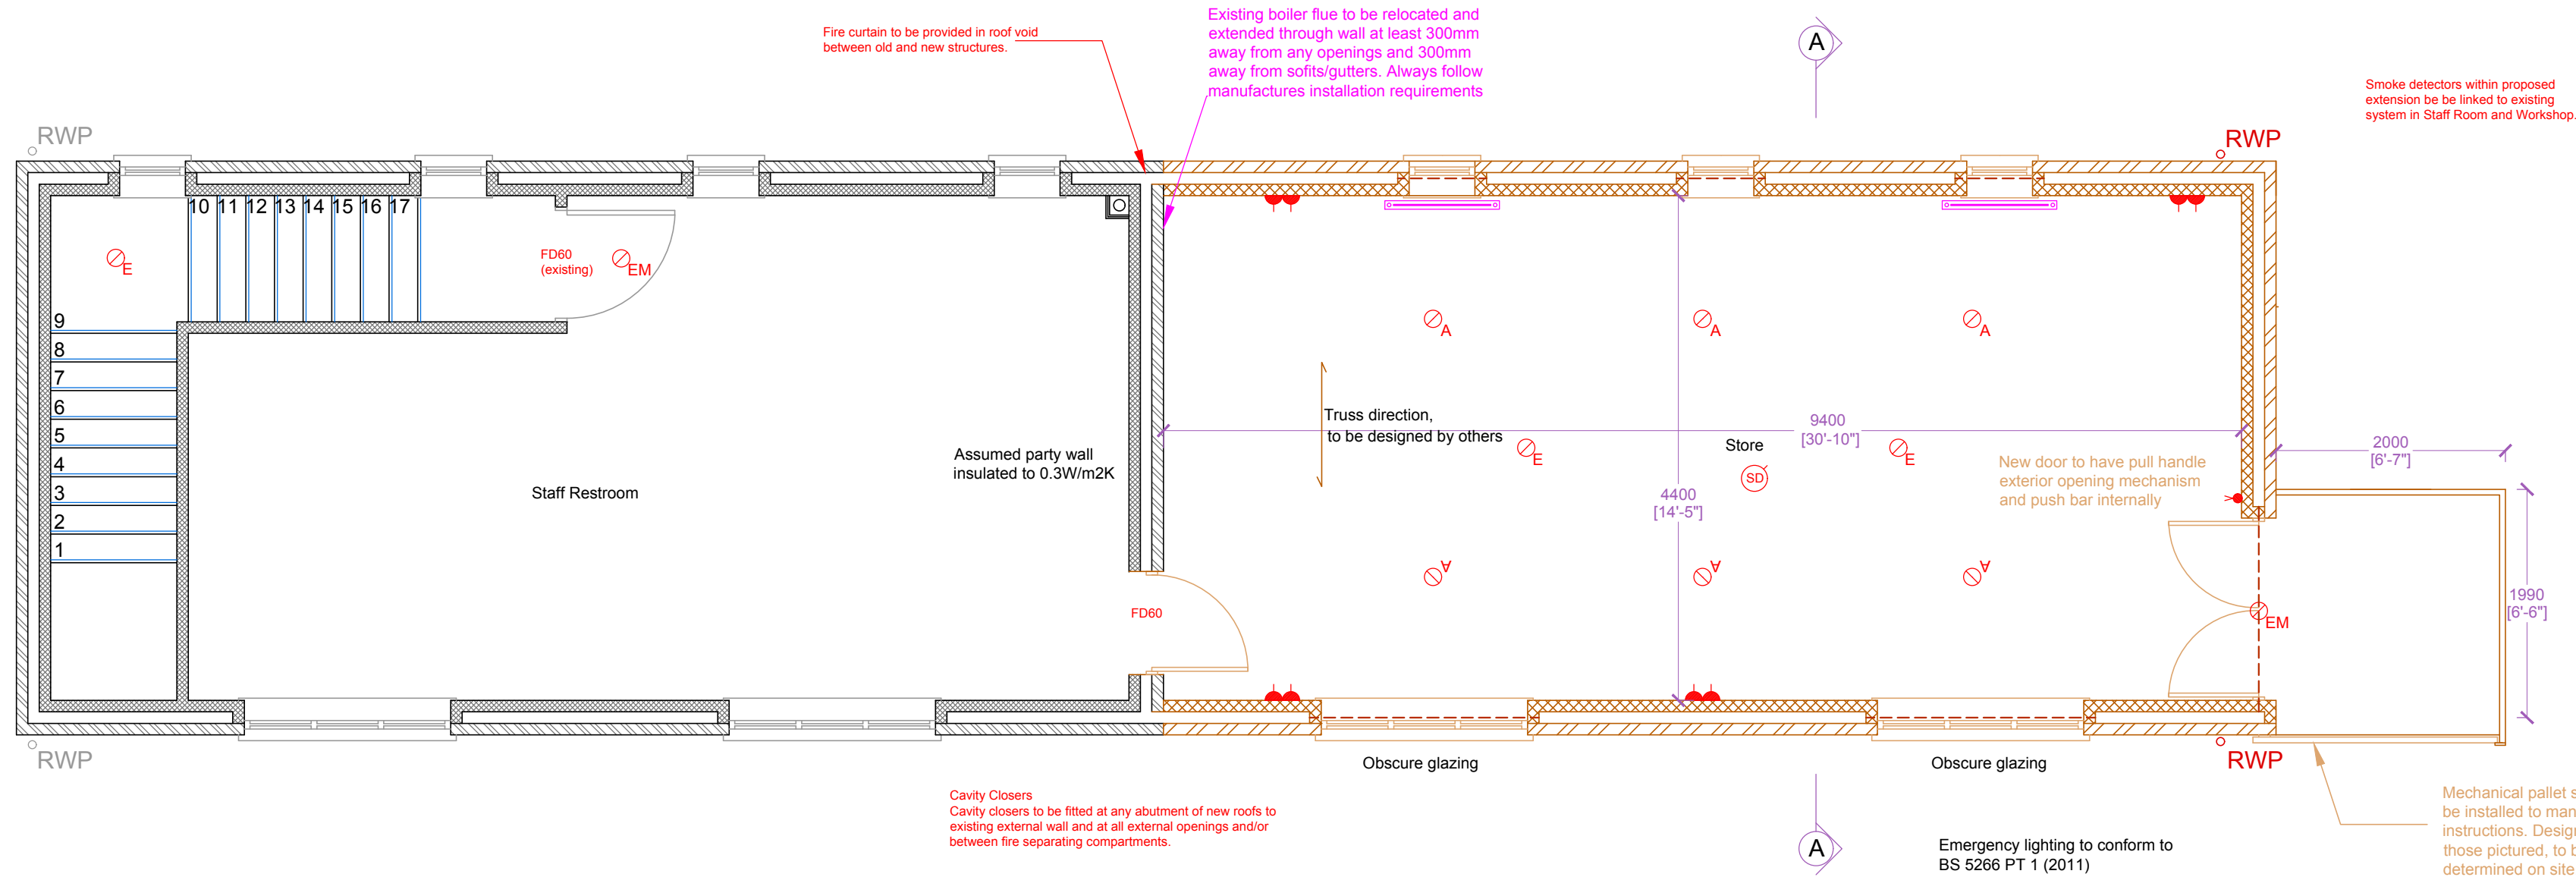

PROPOSED PLANS
1:50

First Floor

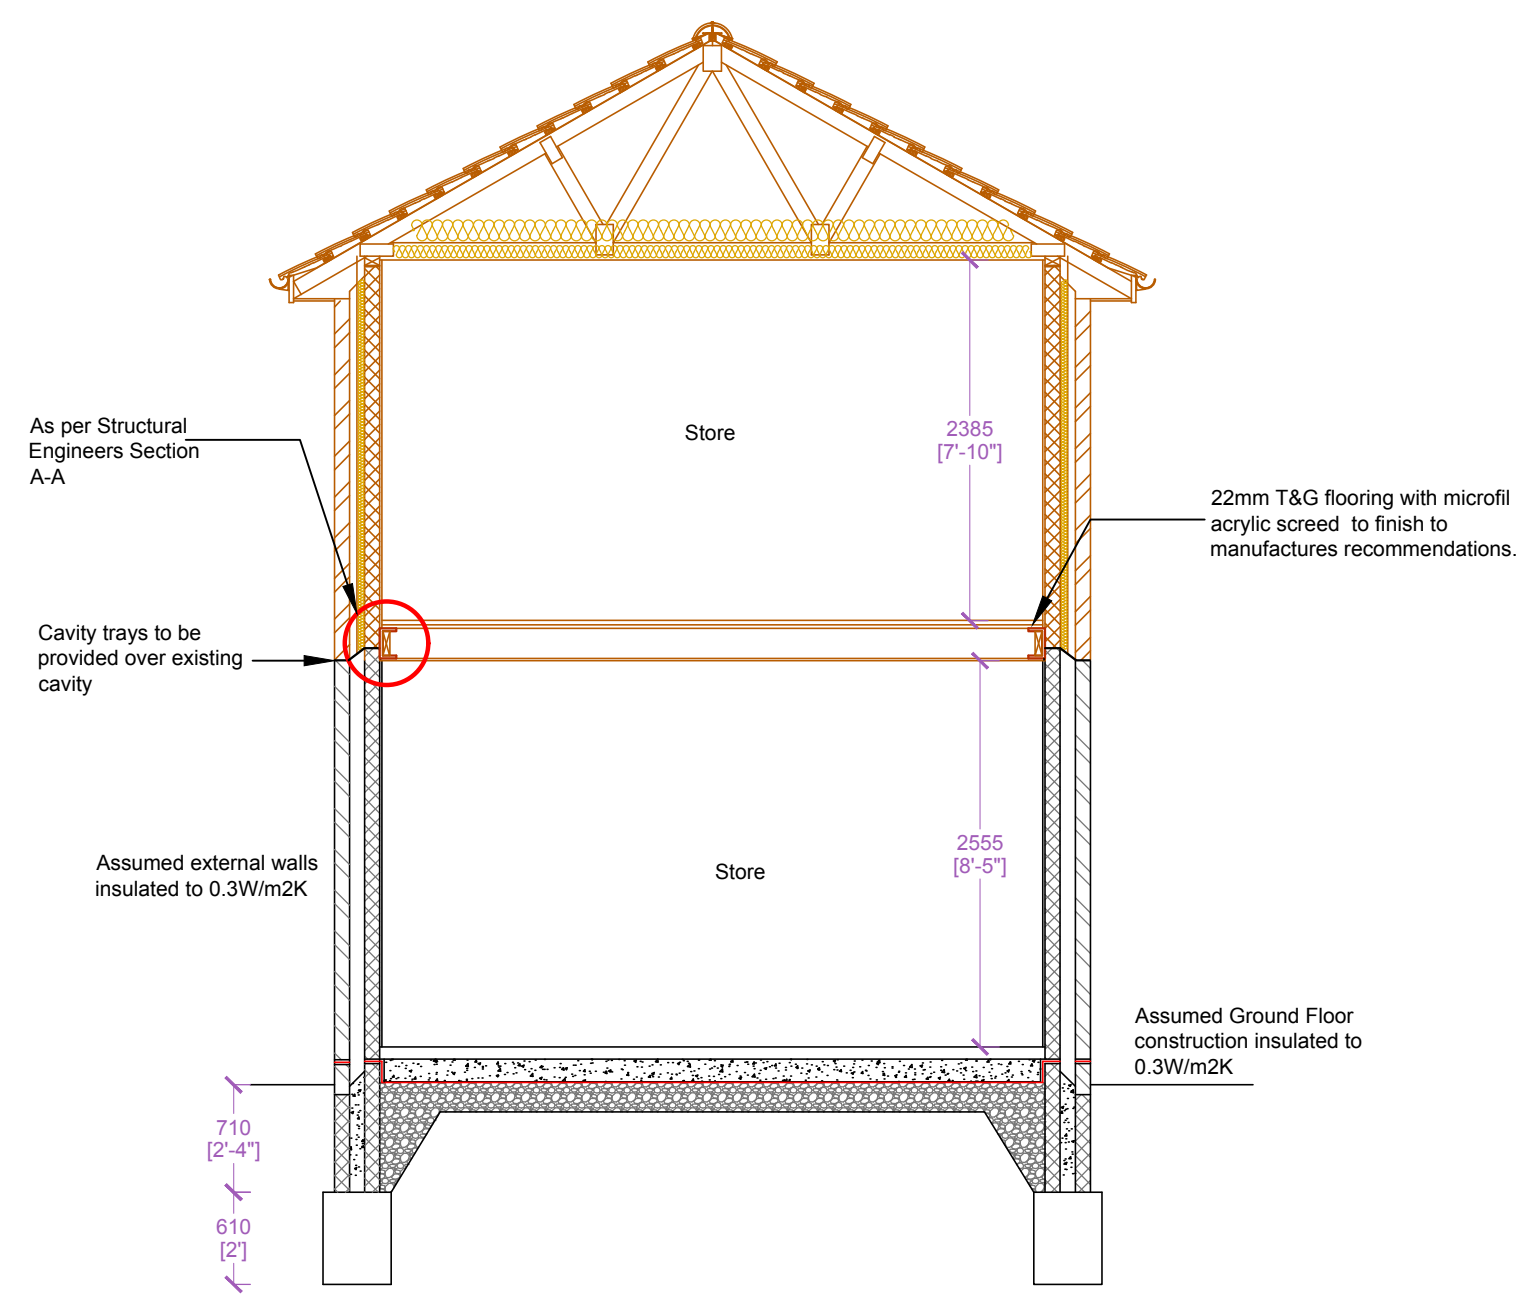


SECTION A-A
1:50


- Legend:
- Switch
 - Indicative radiator, sized and positioned by Contractor's Design
 - Double plug socket
 - Strip light
 - Photozell Light
 - Interlinked, mains operated smoke detector with battery backup
 - Emergency Non Maintained strip lights
 - Emergency lighting maintained with green running man logo
 - Emergency Non Maintained lights



EXAMPLES OF
SAFETY GATES

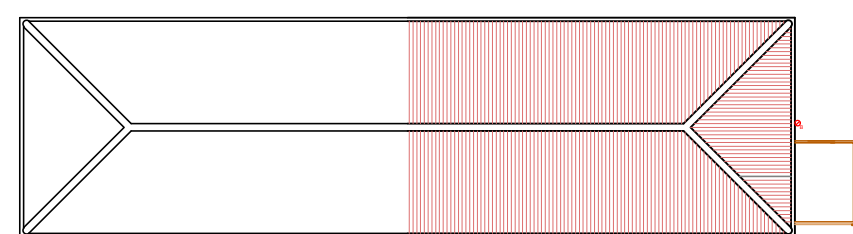

PROPOSED ROOF PLAN
1:200

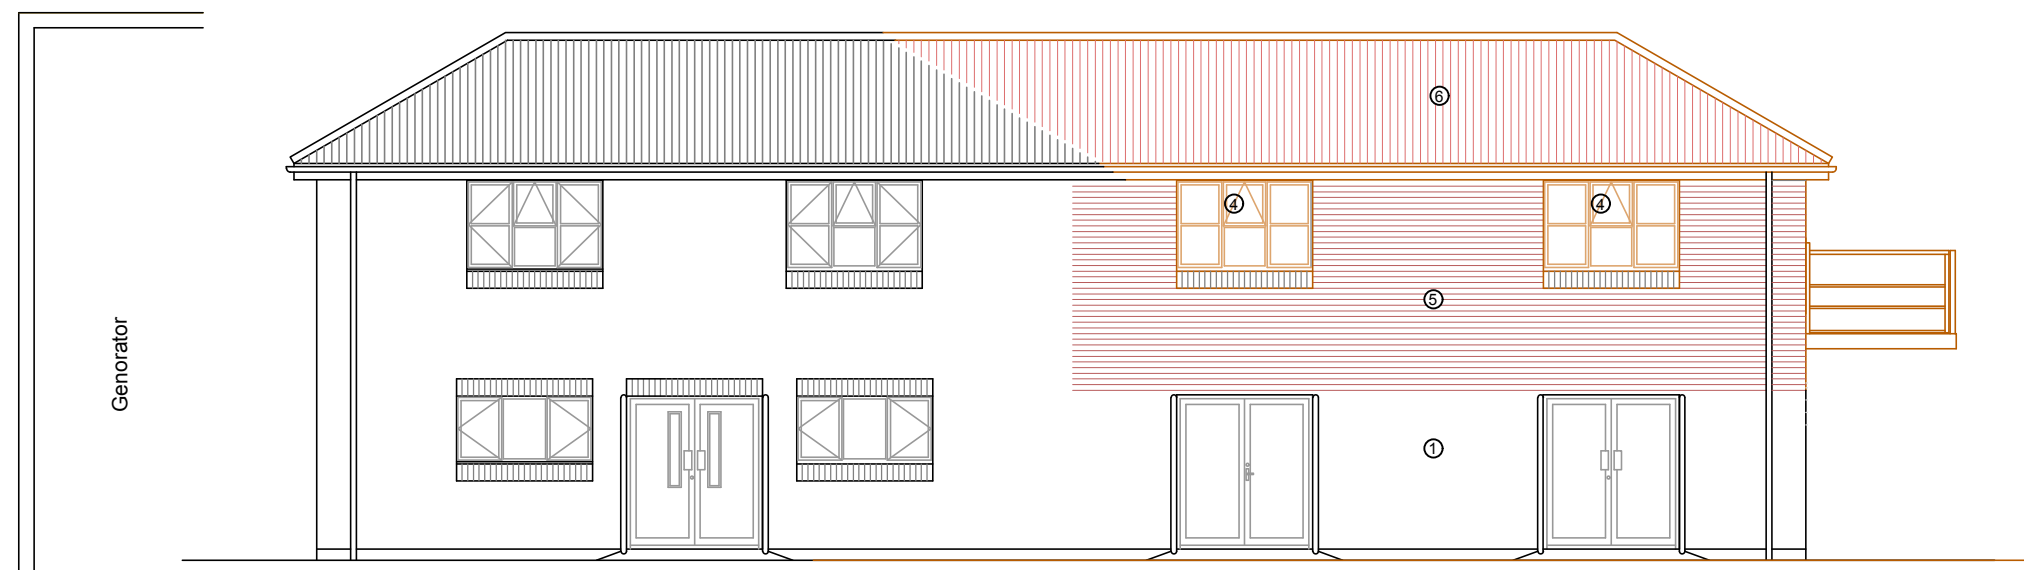


Front Elevation
South


Legend:

Elevations Key:

- ① _ Existing brick wall
- ② _ Existing window
- ③ _ Existing roof tiles
- ④ _ Proposed window
- ⑤ _ New brick wall matching existing
- ⑥ _ New roof tiles matching existing

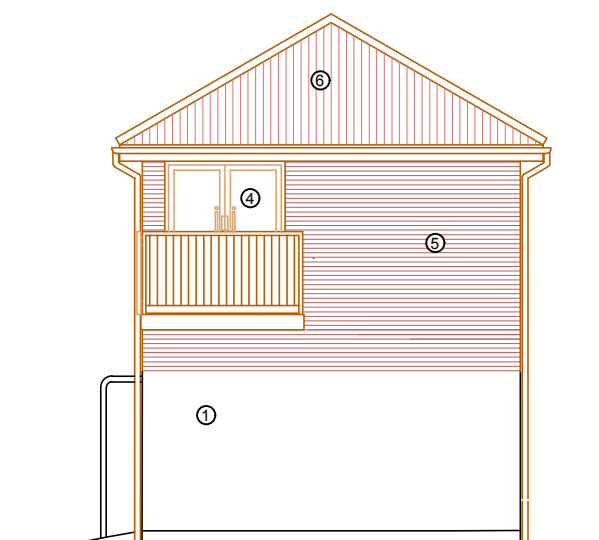


Side Elevation
East

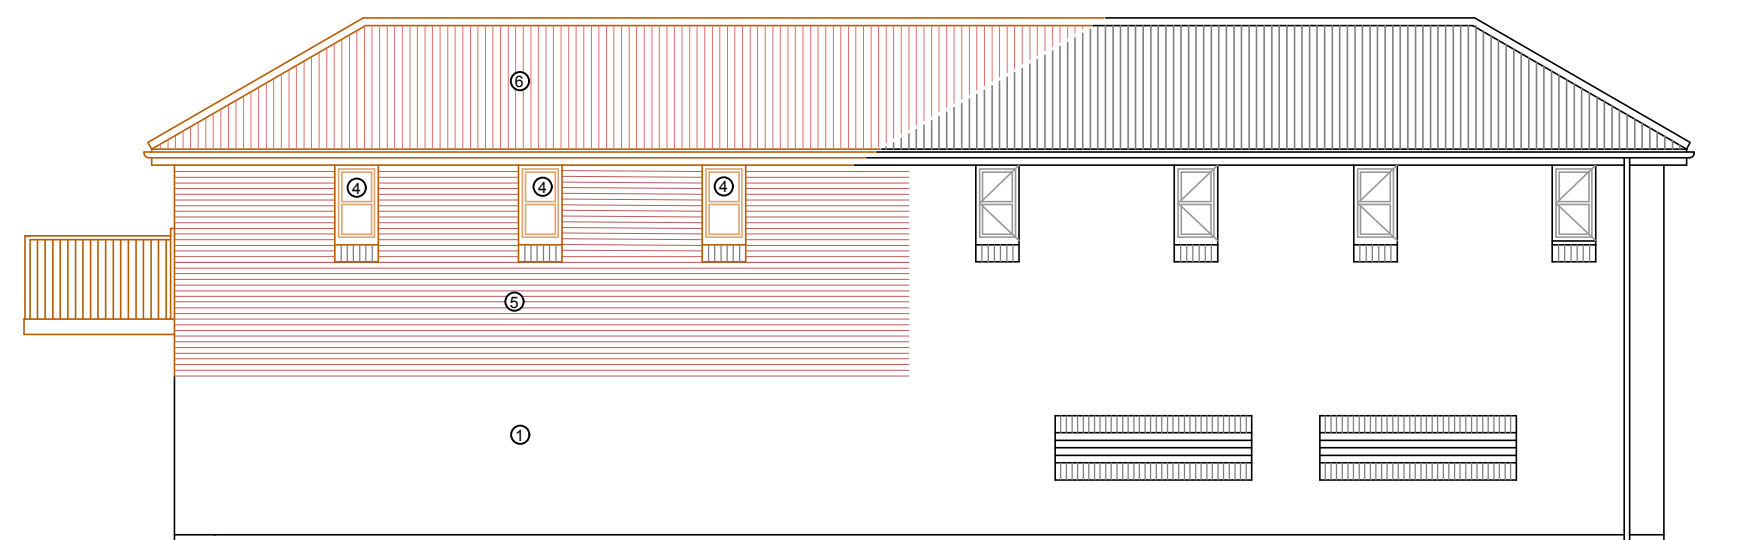


Rear Elevation
North


PROPOSED
ELEVATIONS
1:100

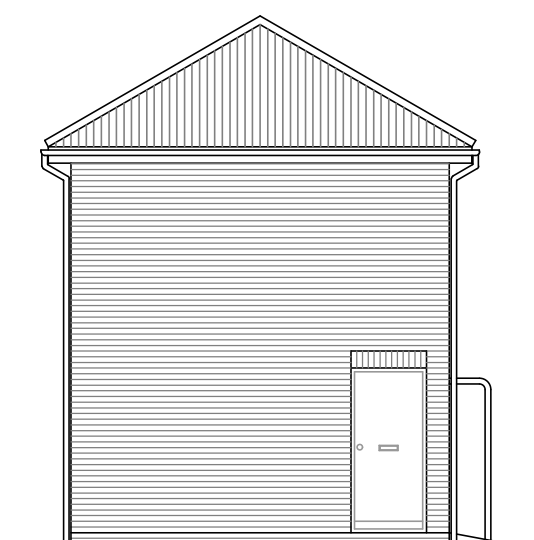

Side Elevation
West

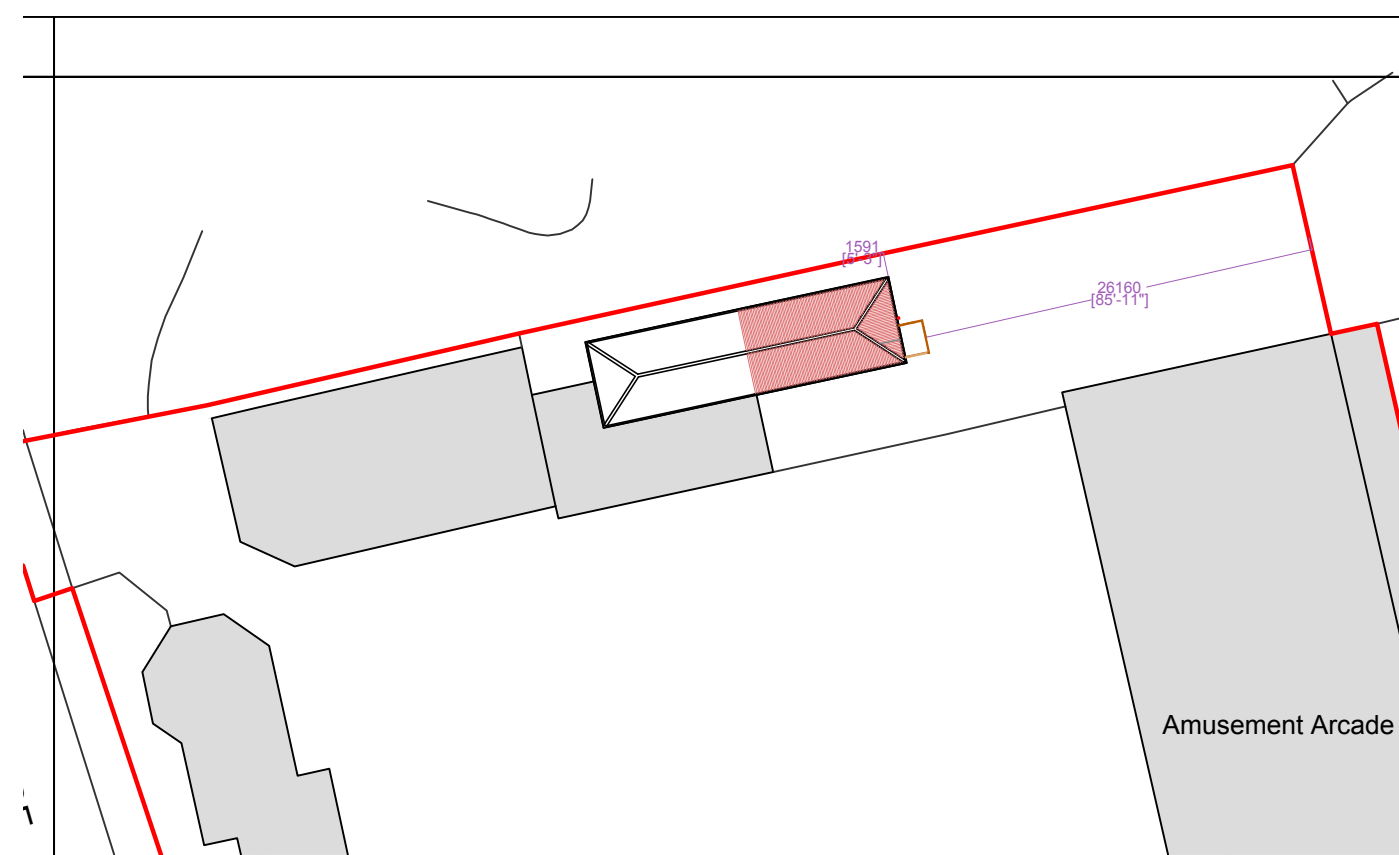

BLOCK PLAN
1:500

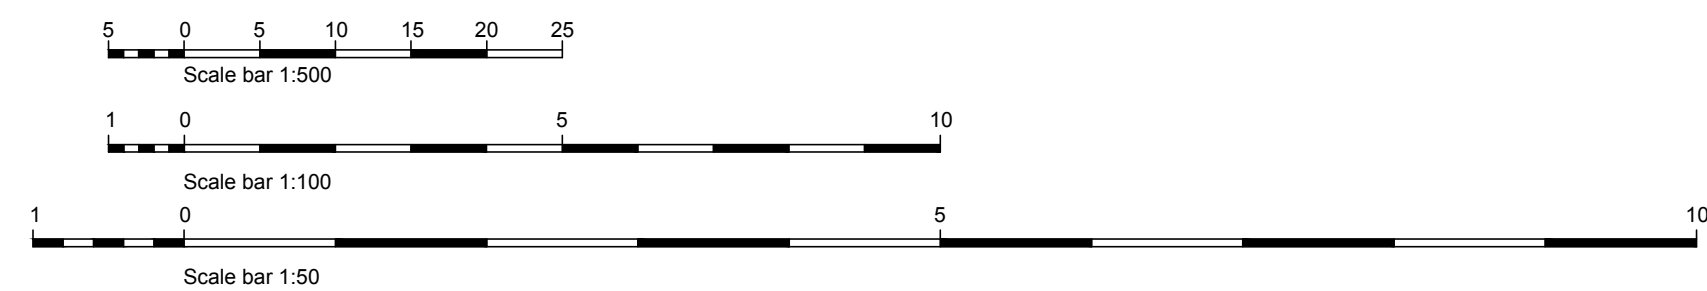

This drawing is the property of Fuller Associates and is not to be copied, reproduced, retained or disclosed to any unauthorised person either wholly or in part without prior consent. Do not scale from this drawing except for Planning purposes. Use all figured dimensions only. All figured dimensions to be checked on site prior to construction. All discrepancies, errors and omissions to be reported to Fuller Associates prior to construction. Layout and dimensions of existing building to be checked on site.

Local Authority Approvals
Any work undertaken before all necessary Planning and Building Regulations Approvals are in place is done entirely at the Client's risk. Any conditions imposed on either Planning or Building Regulations Approvals must be discharged as prescribed on the Decision or Approval Notice. Discharge of Conditions is the responsibility of the Client.

Building Regulations Standards and Inspections
All work must be carried out in accordance with current Building Regulations and to the satisfaction of Building Control or Approved Inspector. The Client/Contractor is responsible for payment of the Inspection Charges to Building Control which will normally become payable upon commencement of works.

Southern Water Drainage Adoption
As of September 2011 Southern Water adopted certain drainage/sewers which were previously privately owned. In this case it may become necessary to obtain a licence from Southern Water to do the work. This would incur a licence fee payable to Southern Water.

Fullers Associates can advise as to whether this may affect your project, but it is the responsibility of the Client to ensure any necessary licences are obtained prior to construction work commencing. Client is responsible for the cost of any Southern Water drainage plans and licenses.

Party Wall Act
It is the responsibility of the Client to ensure compliance with the requirements of the Party Wall Act 1996. A professional Party Wall Surveyor should be employed if further information or guidance is required.

Managing Agent/Landlord Consents
The Client is responsible for obtaining any permission/consent or agreement from Landlords, Estate Management as is necessary for the project. Fuller Associates can assist in facilitating, but any charges for such permission/consent or agreement is payable directly by the Client to the party imposing the charge.

Health & Safety
It is the responsibility of the Client to ensure compliance with the Construction (Design & Management) Regulations 2015. The Regulations impose obligations and responsibilities on Clients, Designers and Contractors. Additional responsibilities are imposed on those acting as Principal Designer, Principal Contractor, Designer and Contractor. Additional information regarding the obligations and responsibilities can be discussed with Fuller Associates or the Principal Designer.

Rev.	Details	Date
A	Checking amendments	14/12/18
B	FOR BC	25/04/19
C	LOADING PLATFORM	31/05/19
D	REMOVAL OF LADDER	14/06/19

FULLER ASSOCIATES
Chartered Surveyors • Architectural Design

10-11 The Parade
Willowhayne Crescent
East Preston
West Sussex
BN16 1NS

01903 774754
www.fuller-associates.co.uk

Issued for:	Drawn	Checked
Discussion	AJ	KW
Planning Application	KW	KW
Building Control	KW	X
Construction Issue	X	X
As Built	X	X

NON MATERIAL AMENDMENT TO EXTERNAL
STAIRCASE - PROPOSED PLANS, ELEVATIONS,
SECTION, ROOF PLAN AND BLOCK PLAN

Client
Site Address
Harbour Park
Littlehampton
West Sussex
BN17 5LL

Harbour Park Ltd.

Printed
Date
Drawing Number

As Shown on A1
14/06/2019
183003/02D