


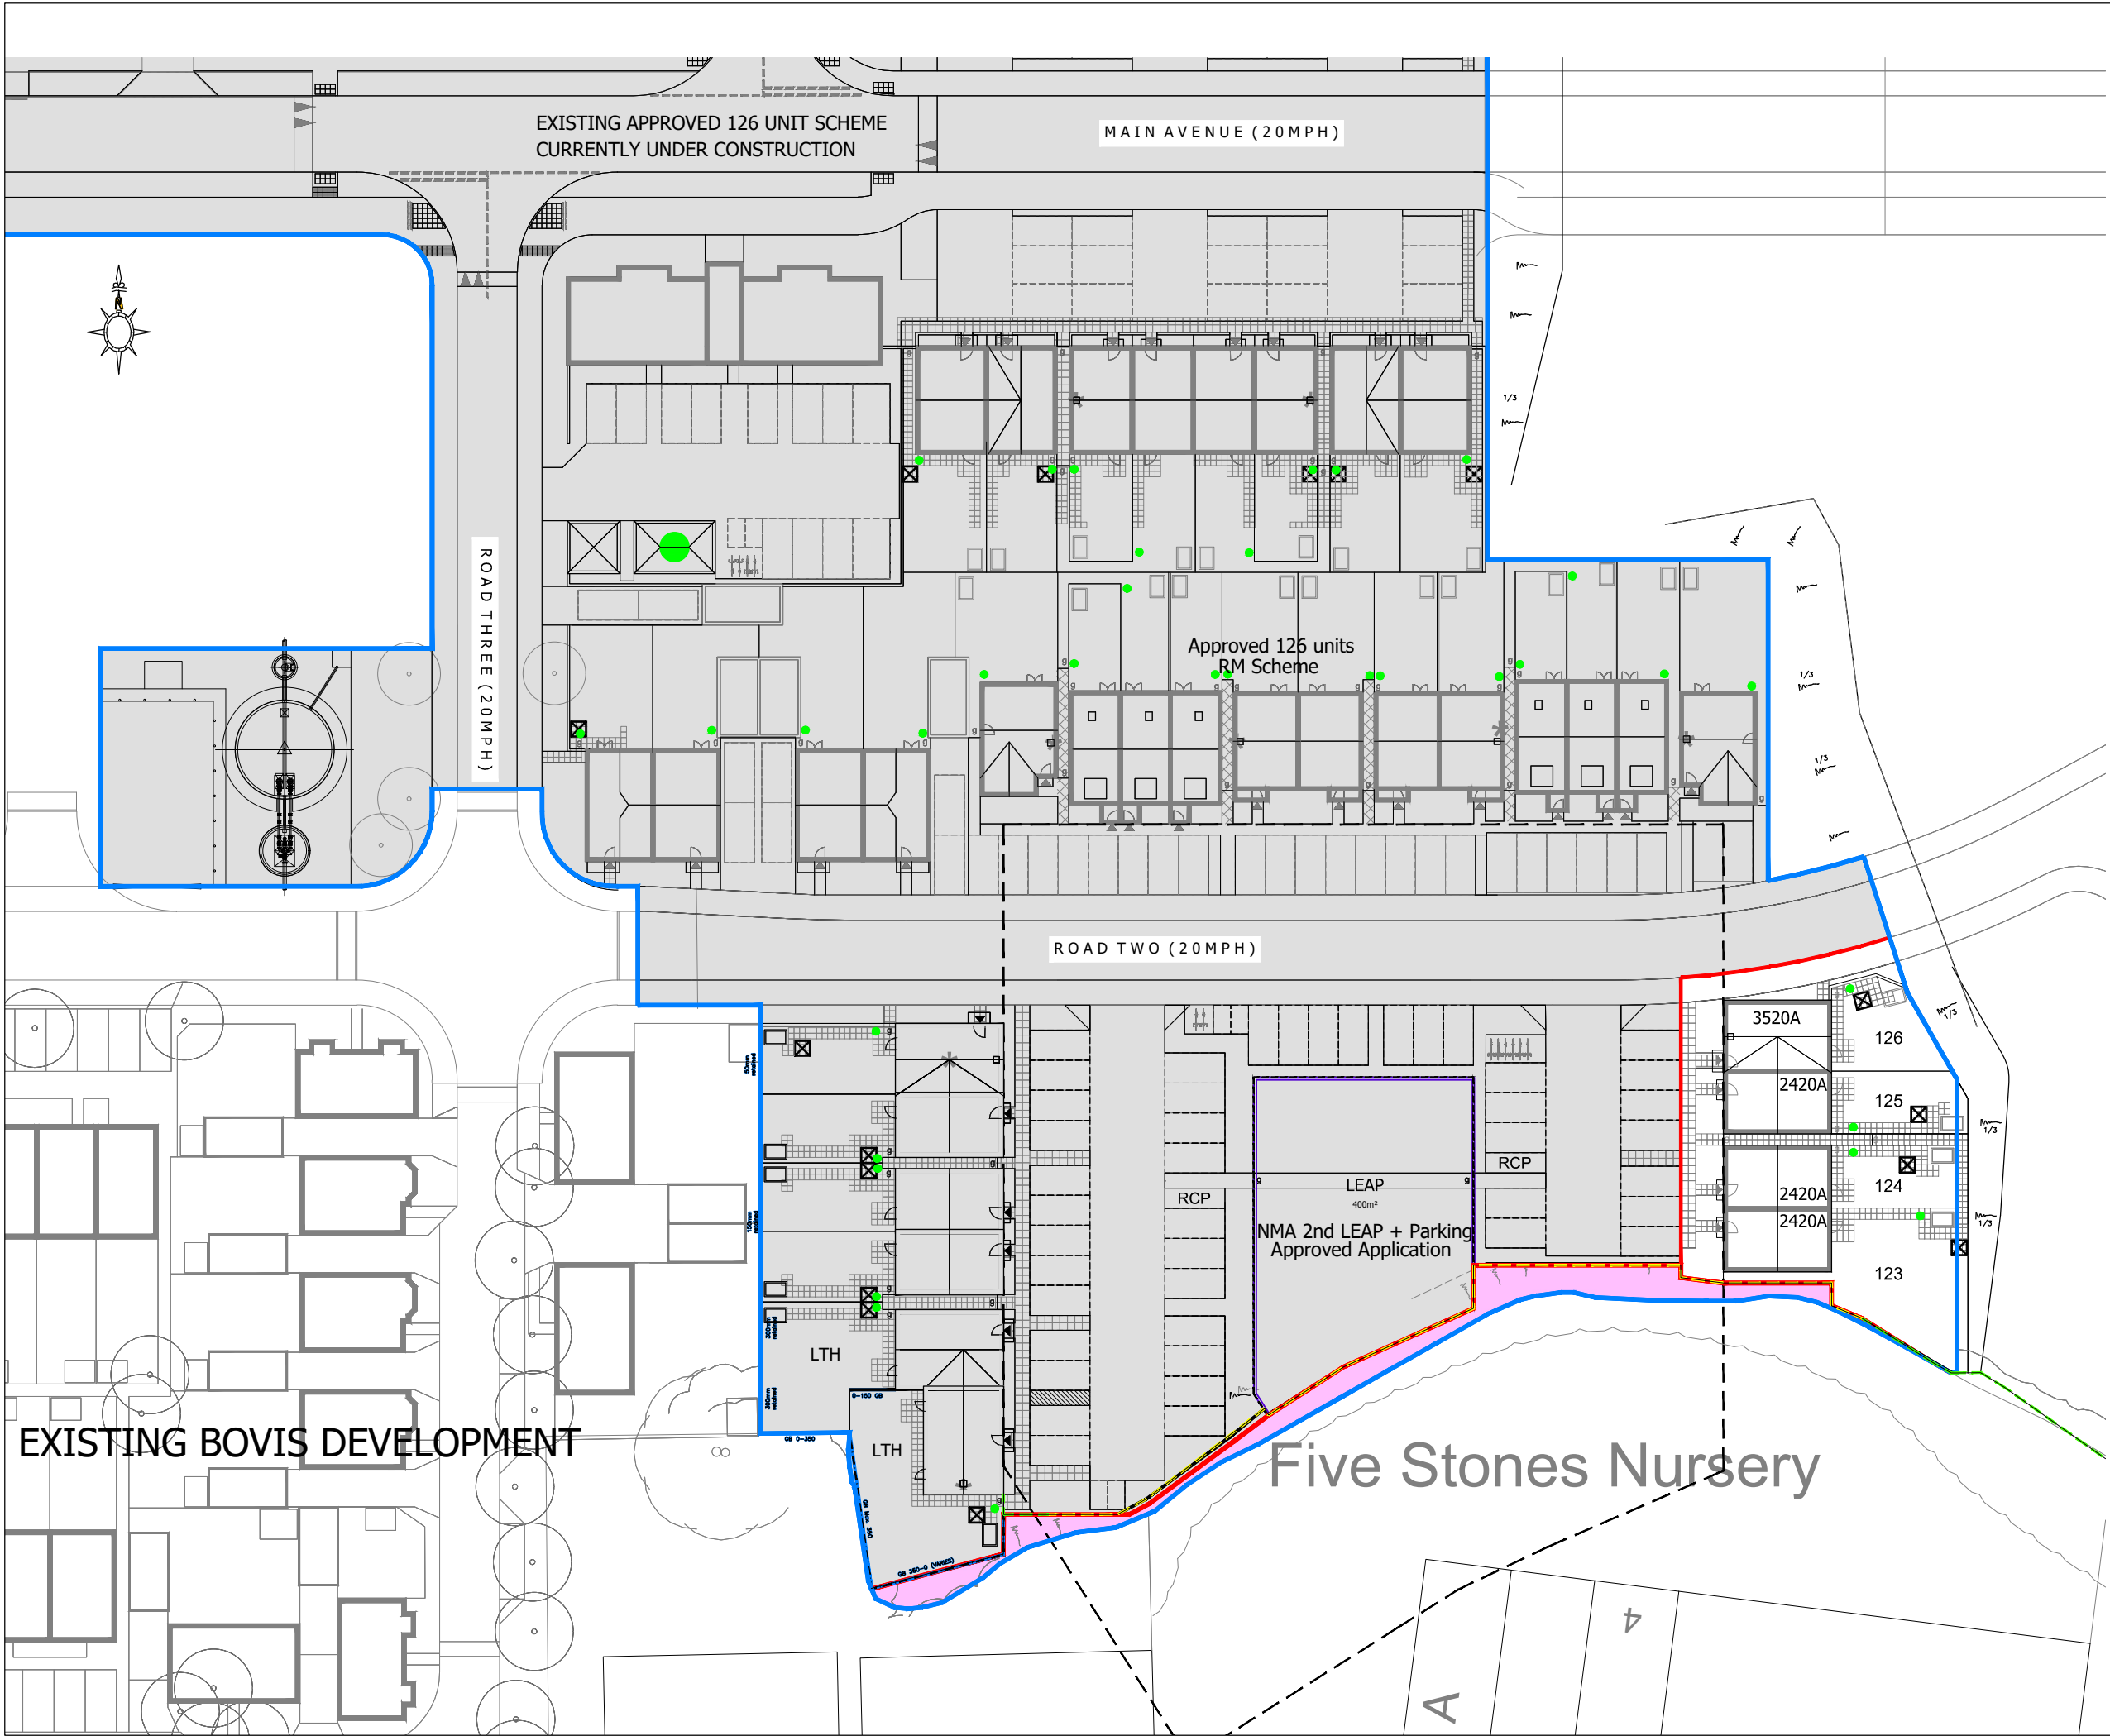

- LEGEND
- Proposed 3rd NMA Application Boundary
 - Redline Boundary
Pink hatched area indicates Revised boundary lines to rationalise southern edge in relation to levels and retaining wall/acoustic fence requirements.
 - Approved LU/121/17/RES Application Boundary
 - Location of Proposed 2.8m Acoustic Fence on retaining wall.
 - Location of Proposed 2.8m Acoustic Fence
 - Location of required gravel board - as per Engineer's details
 - Areas already Approved.



Scale
1:500

-	-	-
-	-	-
A	Application Redline Boundary revised to the rear of plots 123 - 125 As requested by LPA.	15.07.21
Rev		Date
 PERSIMMON Together, we make a home Persimmon Homes Thames Valley Persimmon House, Knoll Road, Camberley, Surrey GU15 3TQ Tel: 01276 808080		
Site:	Date:	
Phase 2 Littlehampton	Jan. 2021	
	Scale:	
	1:500 @ A3	
	Org No:	
	543_PL_APP3_100	
Drawing Title: 3rd NMA Application Site Layout - Plots 123 - 126		
Drawing Status: SUBMITTED	Drawn by:	Checked by:
	AT	ME/RC
	Rev:	A