



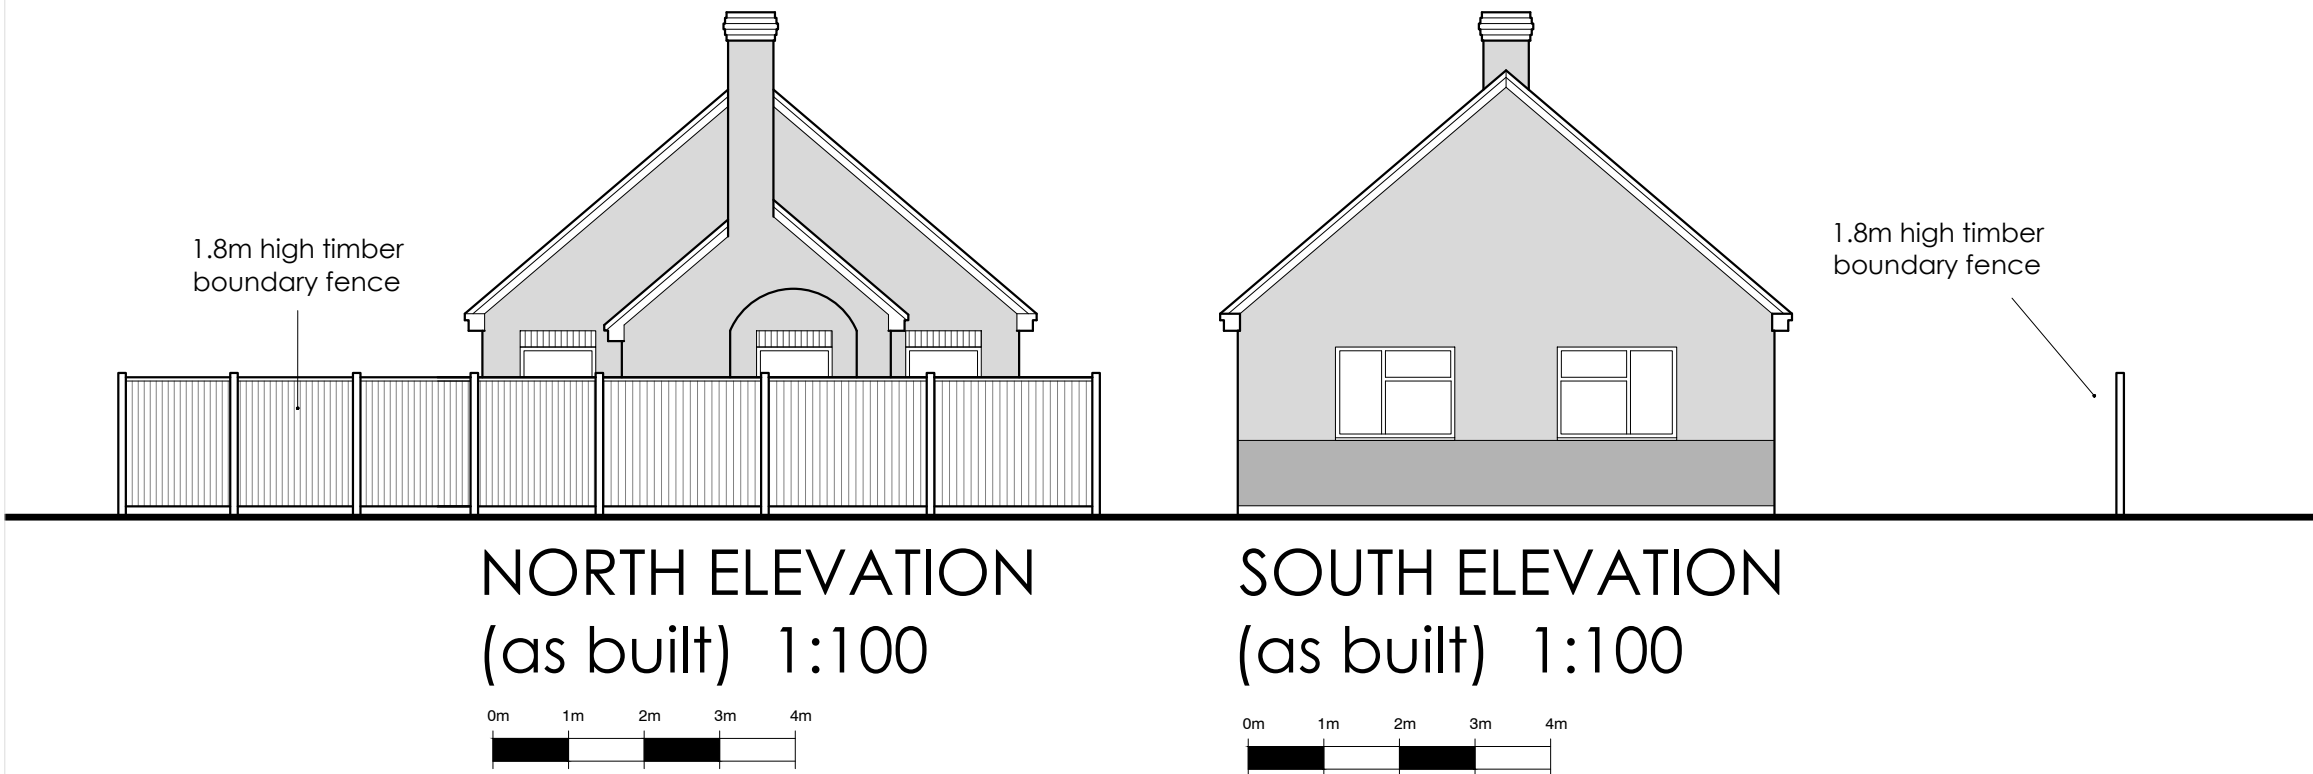

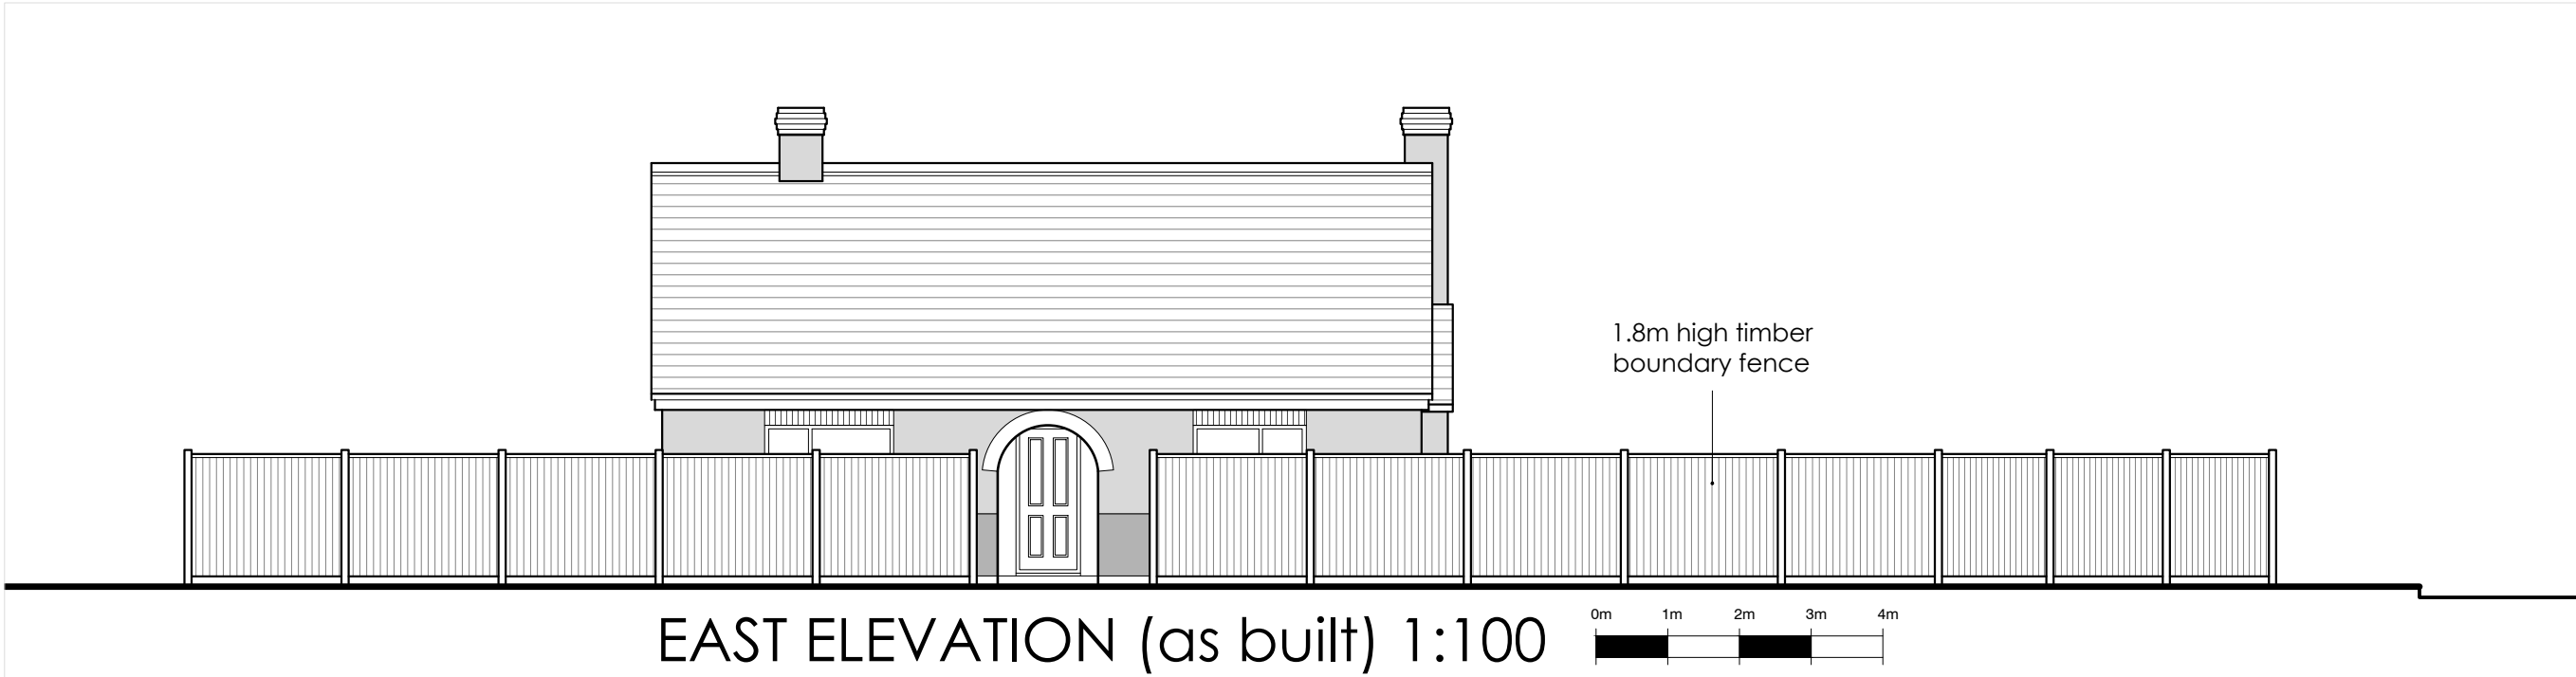

carl moore

— architectural design —

18 Parklands Avenue
Goring-By-Sea
West Sussex BN12 4NH

01903 533276
carl@cm-arch.co.uk

Address of Works:

97 ARUNDEL ROAD
LITTLEHAMPTON
BN17 7DT

Drawing Title:

PROPOSED BOUNDARY FENCE

Paper Size/ Scale:

A3

Date:

August 2026

Drawing Number:

AR-208-04

Revision:

Revision

- General Notes:
- 1:

Do not scale from these drawings (unless for planning purposes).
- 2:

Drawings to be read in conjunction with the structural calculations and the building notes provided.
- 3:

The client/ contractor is advised to read the separate notes and the details provided in the structural calculations regarding the CDM regulations.
- 4:

The property owner is reminded to serve a Party Wall Notice on any adjoining owner should they need to do so under the requirements of the Party Wall Act 1996.
- 5:

No work should be undertaken until all consents (Planning and Building Control) have been received and approved in writing. Any work undertaken without consent is done so at the clients risk.
- 6:

All dimensions to be checked on site prior to ordering any materials, kitchens or bathrooms.
- 7:

All existing foundations and lintels taking any additional loads are to be exposed and agreed with the Building Control Officer.