


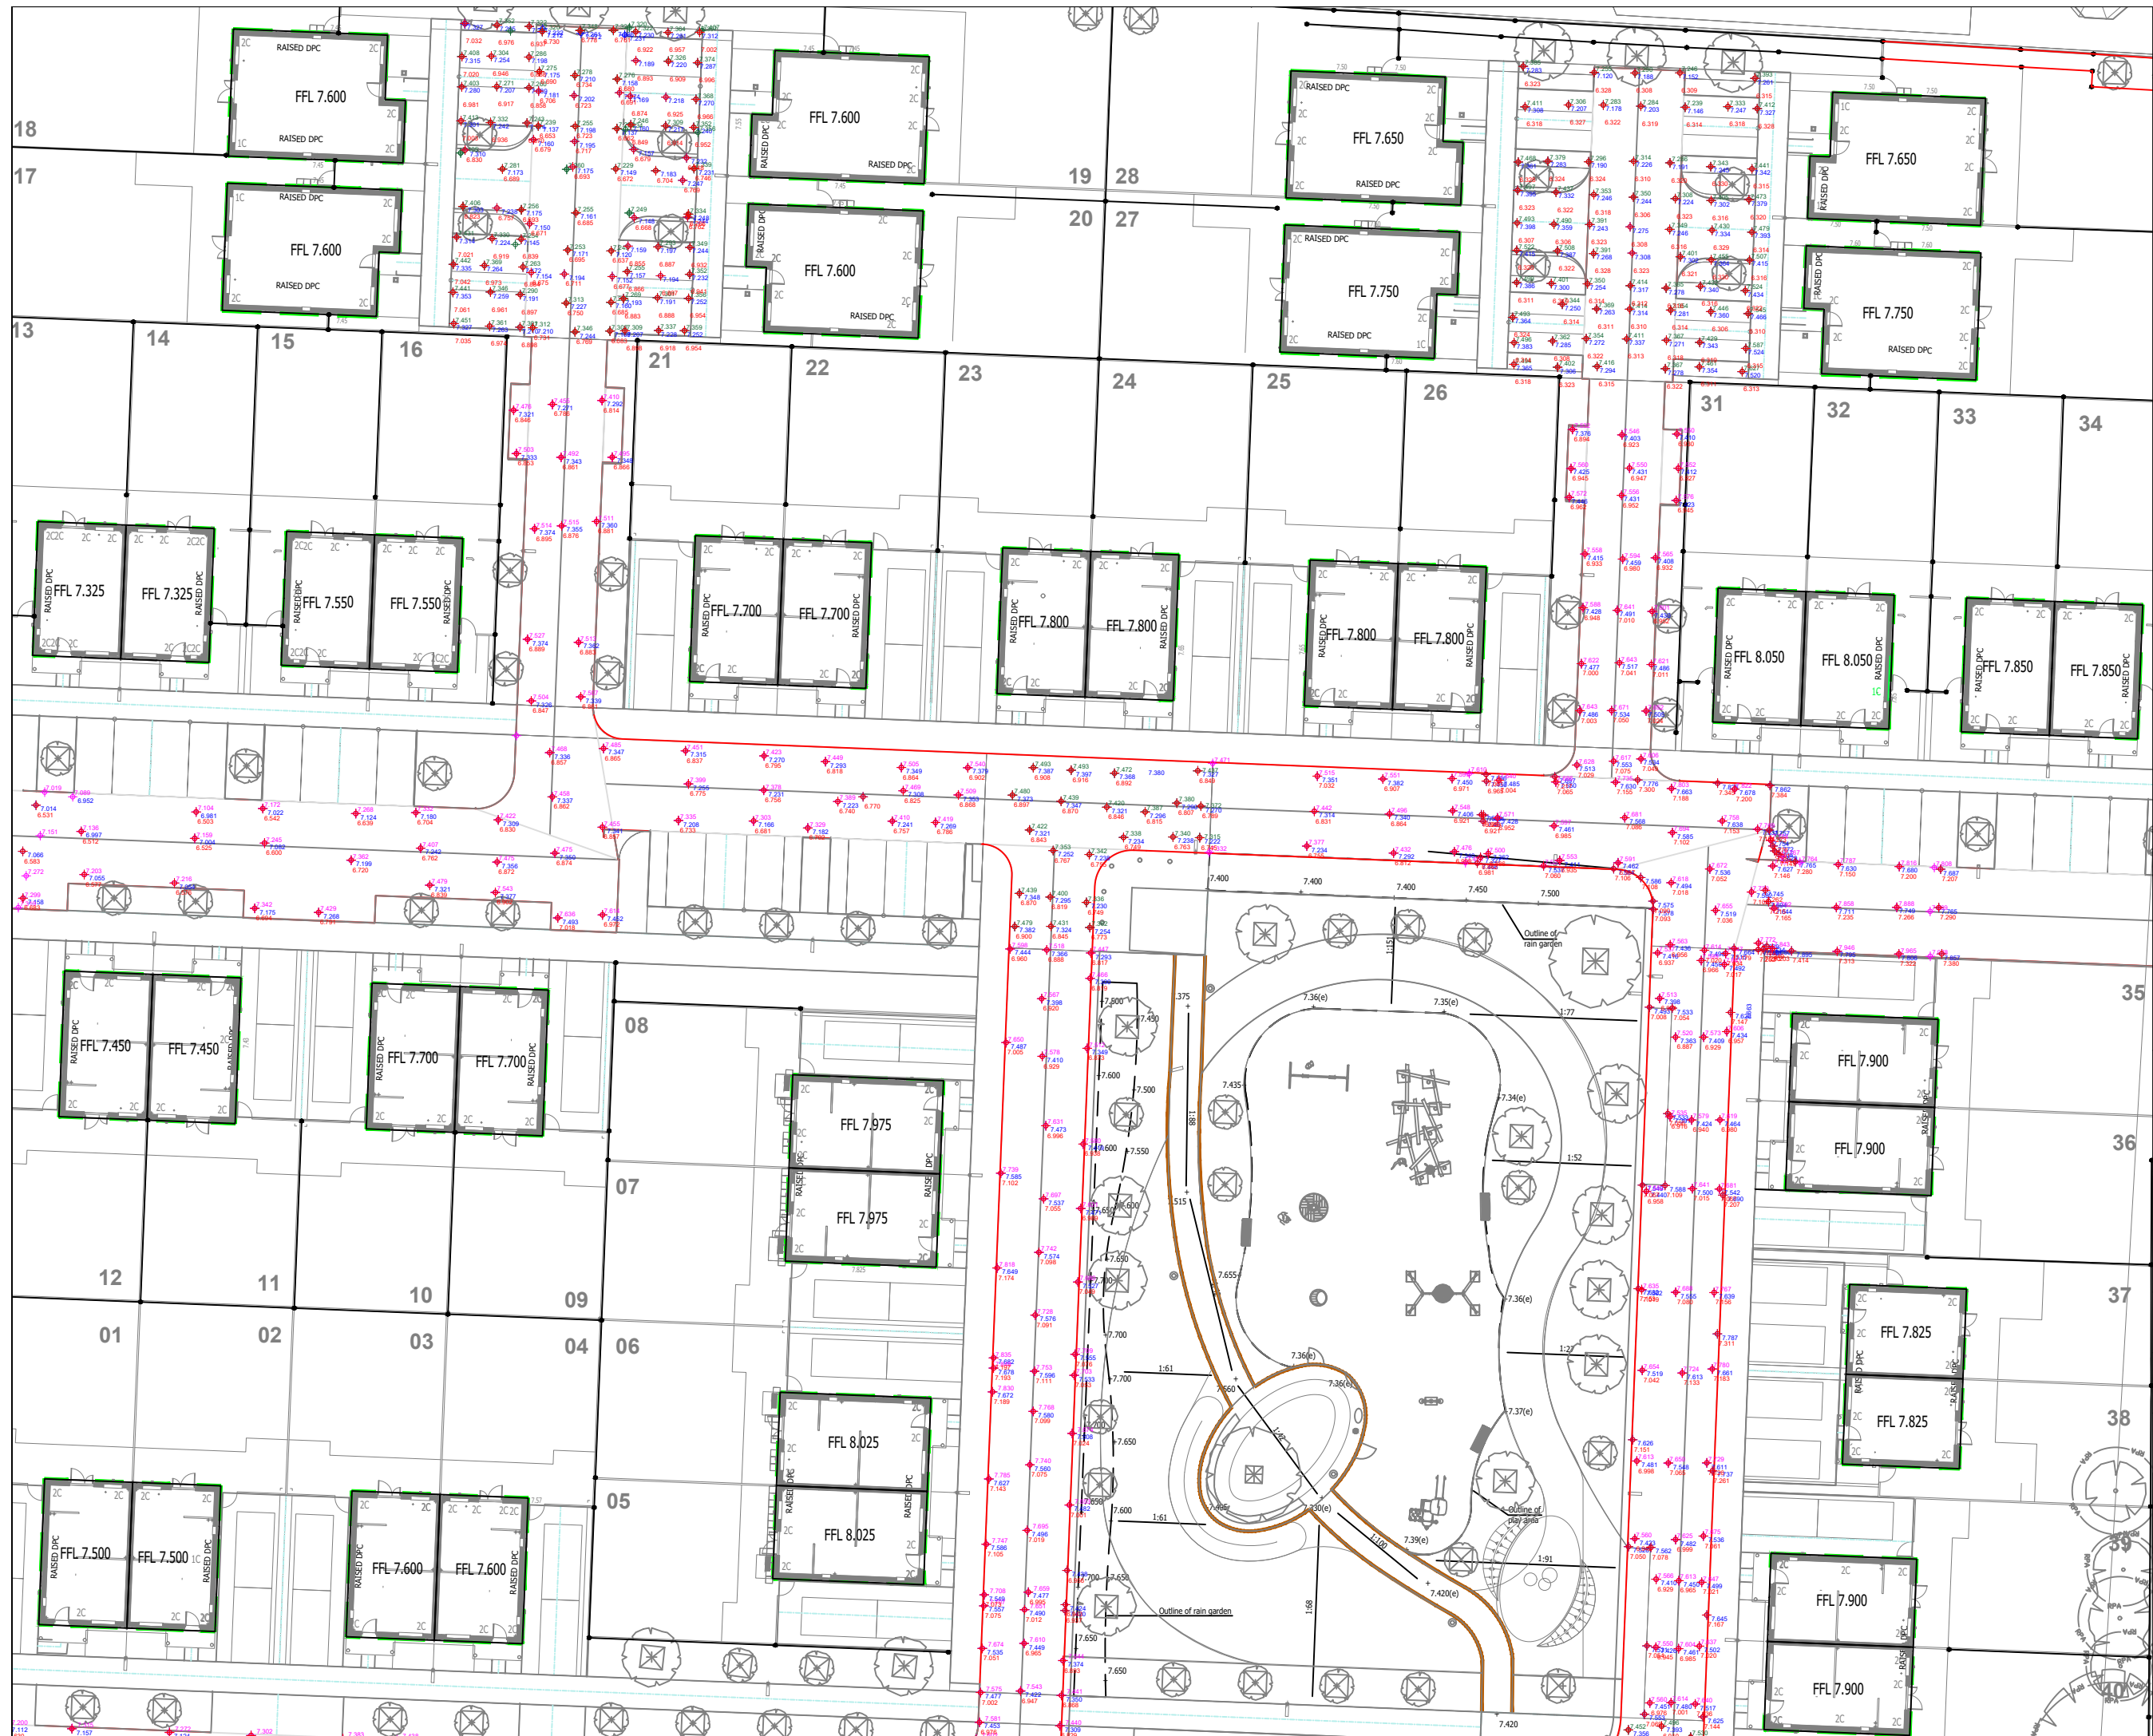

- Notes
- X.XXX - Formation Level
 - X.XXX - Type 1 Level
 - X.XXX - Base Level
 - X.XXX - Binder Level
 - X.XXX - Surface Level

Project Name:

Littlehampton North

Drawing Title:

Road As Built Survey
Sheet 1 of 4

Scale

1:400 at A3

Drawn

M MOSSOP

Checked

-

Project No:

PAR/468

Date

31/10/2025

PARCHOW
GROUNDWORKS LTD

New Down Lane, Cosham

Waterlooville. PO7 5SE

023 9237 8572

Drawing No:

PAR/468/S-101

Revision

01