
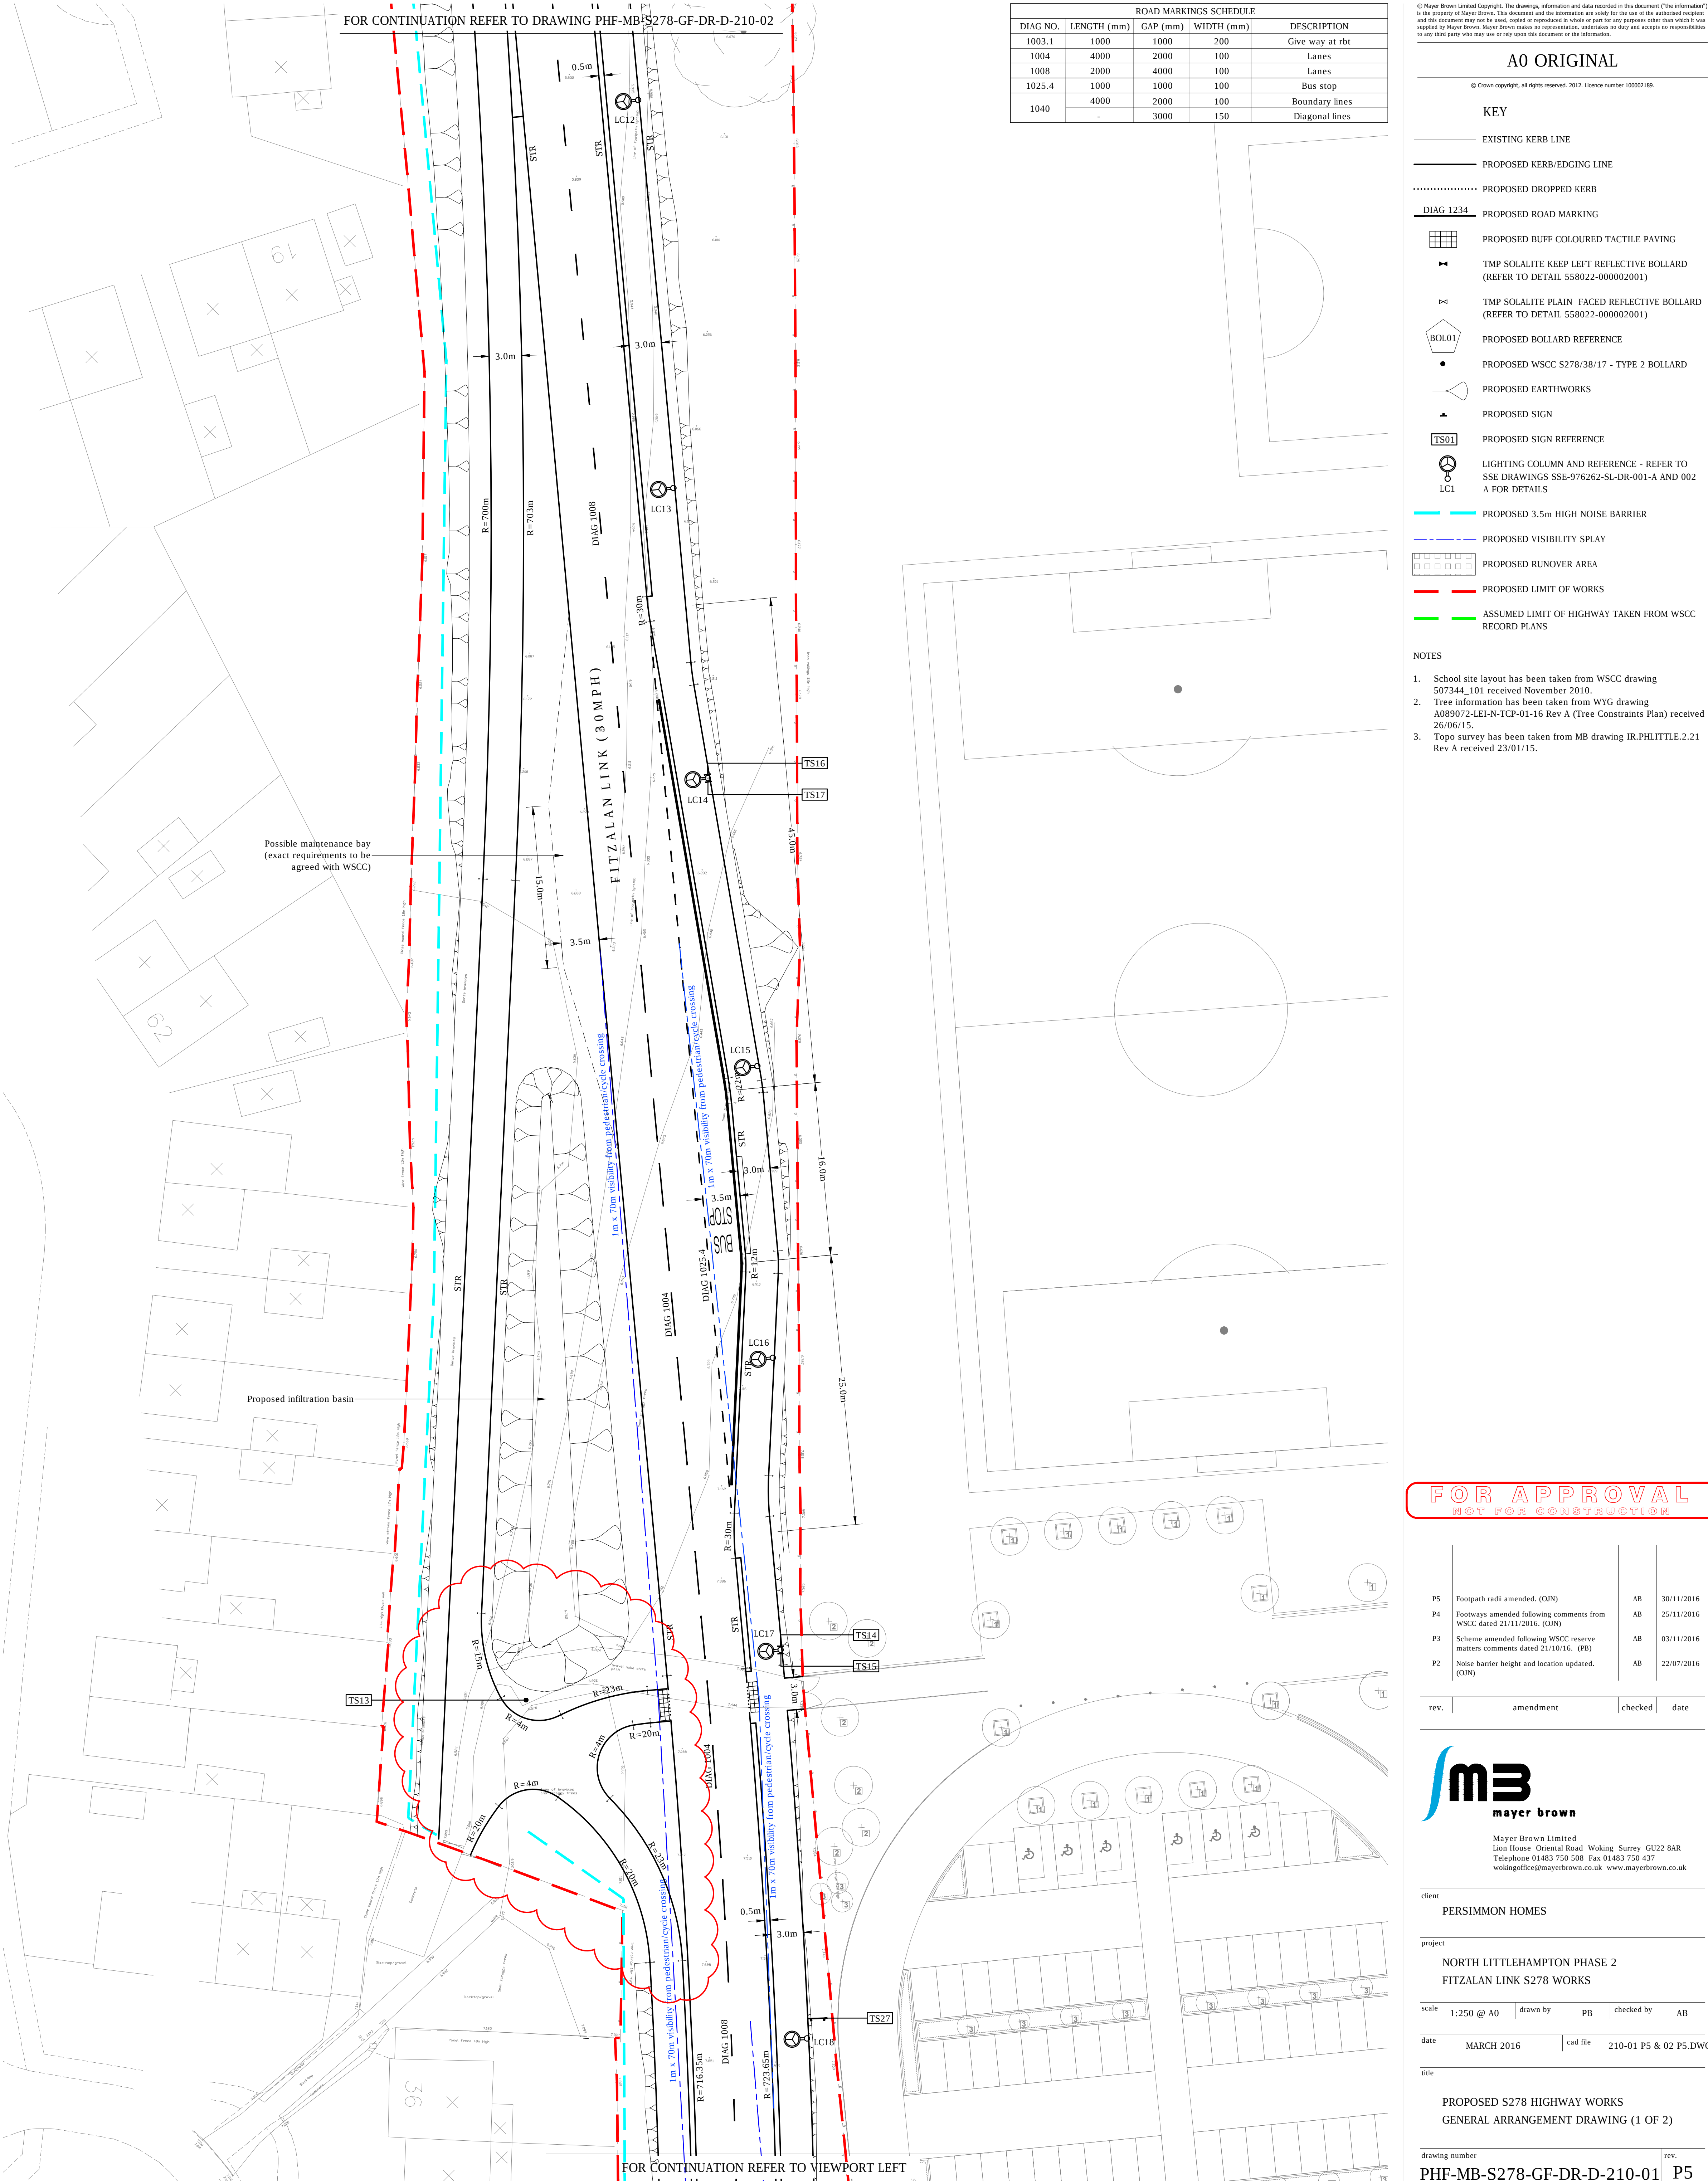


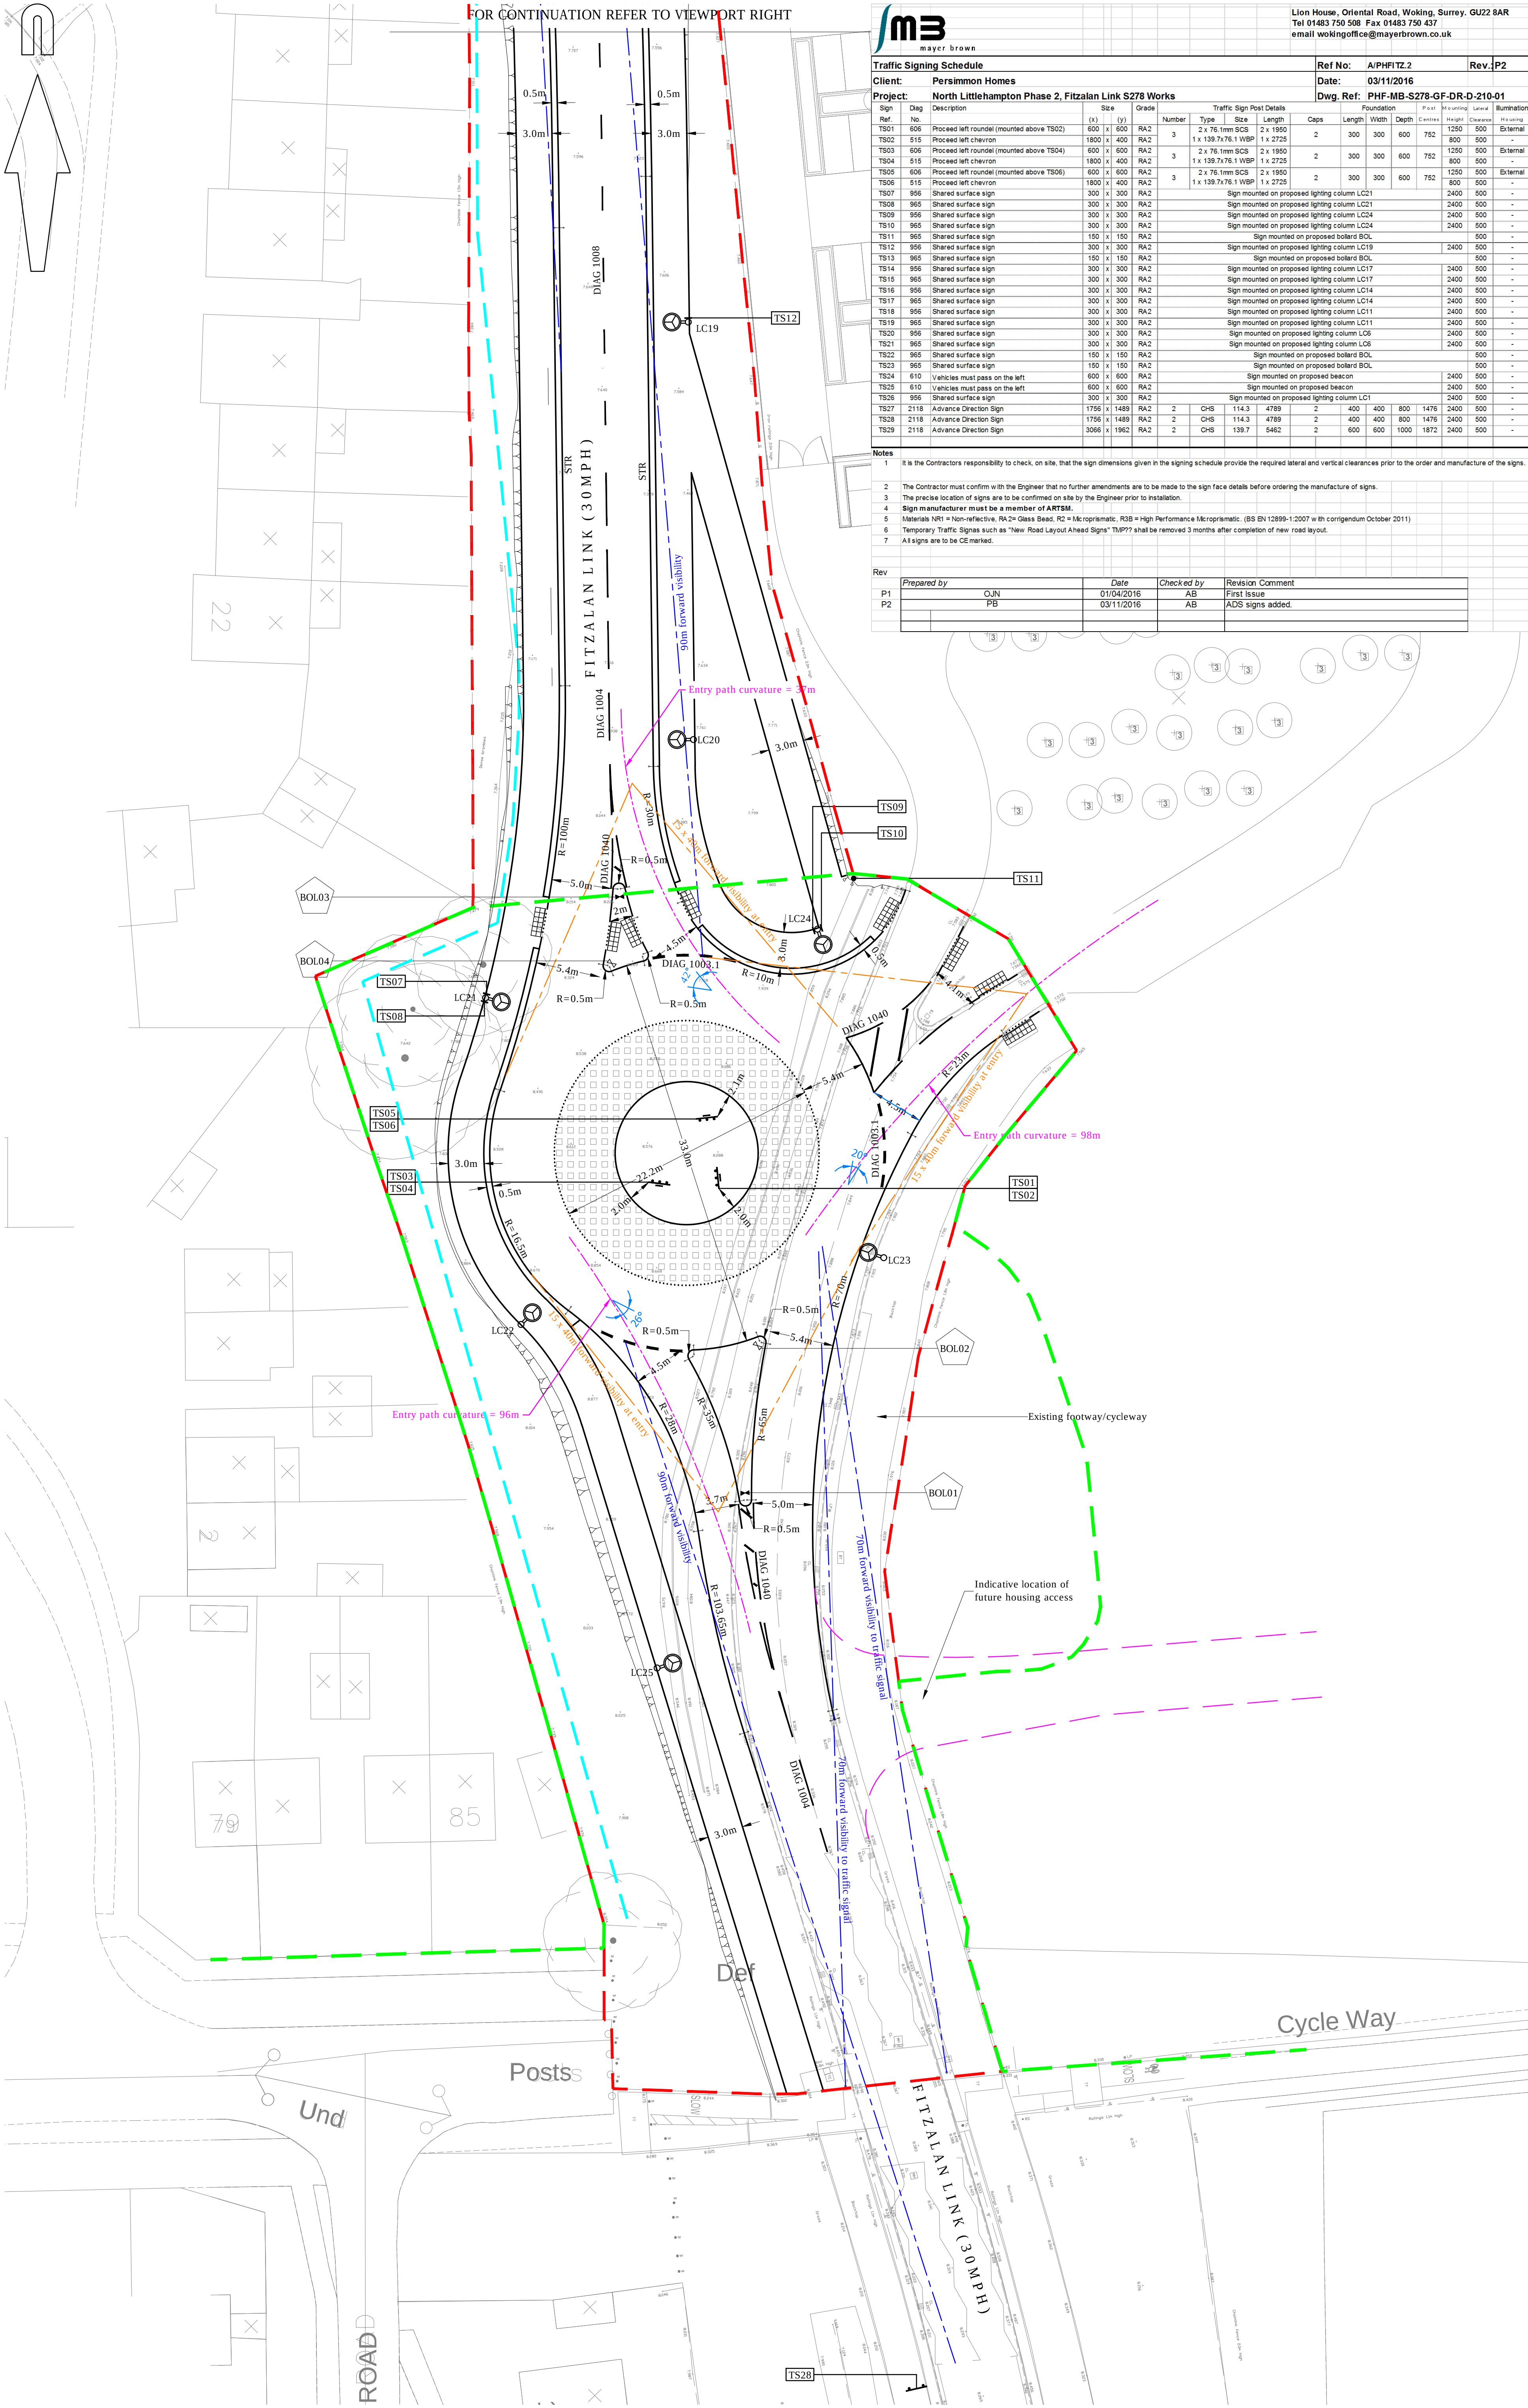

ROAD MARKINGS SCHEDULE				
DIAG NO.	LENGTH (mm)	GAP (mm)	WIDTH (mm)	DESCRIPTION
1003.1	1000	1000	200	Give way at rbt
1004	4000	2000	100	Lanes
1008	2000	4000	100	Lanes
1025.4	1000	1000	100	Bus stop
1040	4000	2000	100	Boundary lines
		3000	150	Diagonal lines

© Mayer Brown Limited Copyright. This drawing, information and data recorded in this document ("the information") is the property of Mayer Brown. This drawing and the information are made for the use of the authorized recipient and the recipient may not be used, copied or reproduced in whole or in part for any purpose other than that which was supplied by Mayer Brown. Mayer Brown makes no representation, warranty or guarantee as to the accuracy or completeness of any data, information or drawings supplied by Mayer Brown. Mayer Brown makes no representation, warranty or guarantee as to the accuracy or completeness of any data, information or drawings supplied by Mayer Brown.

A0 ORIGINAL

KEY

- EXISTING KERB LINE
- PROPOSED KERB/EDGING LINE
- PROPOSED DROPPED KERB
- PROPOSED ROAD MARKING
- PROPOSED BUFF COLOURED TACTILE PAVING
- TMP SOLALITE KEEP LEFT REFLECTIVE BOLLARD (REFER TO DETAIL 558022-000002001)
- TMP SOLALITE PLAIN FACED REFLECTIVE BOLLARD (REFER TO DETAIL 558022-000002001)
- PROPOSED BOLLARD REFERENCE
- PROPOSED WSCC S278/38/17 - TYPE 2 BOLLARD
- PROPOSED EARTHWORKS
- PROPOSED SIGN
- PROPOSED SIGN REFERENCE
- LIGHTING COLUMN AND REFERENCE - REFER TO SSE DRAWINGS SSE-976262-SI-DR-001-A AND 002 A FOR DETAILS
- PROPOSED 3.5m HIGH NOISE BARRIER
- PROPOSED VISIBILITY PLAY
- PROPOSED RUNOVER AREA
- PROPOSED LIMIT OF WORKS
- ASSUMED LIMIT OF HIGHWAY TAKEN FROM WSCC RECORD PLANS

NOTES

- School site layout has been taken from WSCC drawing 507344_101 received November 2010.
- Tree information has been taken from WYG drawing A080972-LEI-N-TCP-01-16 Rev A (Tree Constraints Plan) received 26/06/15.
- Topo survey has been taken from MB drawing IR.PH.LITTLE.2.21 Rev A received 23/01/15.

FOR APPROVAL
NOT FOR CONSTRUCTION

P5	Footpath radii amended. (GJN)	AB	30/11/2016
P4	Footways amended following comments from WSCC dated 21/11/2016. (GJN)	AB	25/11/2016
P3	Scheme amended following WSCC reserve matters comments dated 21/10/16. (PB)	AB	03/11/2016
P2	Noise barrier height and location updated. (GJN)	AB	22/07/2016

rev.	amendment	checked	date
------	-----------	---------	------

m3
mayer brown

Mayer Brown Limited
Lion House, Oriental Road, Woking, Surrey GU24 0AR
Telephone 01483 750 588 Fax 01483 750 437
woking@mbm.co.uk www.mayerbrown.co.uk

client
PERSIMMON HOMES

project
NORTH LITTLEHAMPTON PHASE 2
FITZALAN LINK S278 WORKS

scale
1:250 @ A0

drawn by
PB

checked by
AB

date
MARCH 2016

cd file
210-01 P5 & 02 P5.DWG

title
PROPOSED S278 HIGHWAY WORKS
GENERAL ARRANGEMENT DRAWING (1 OF 2)

drawing number
PHF-MB-S278-GF-DR-D-210-01

rev.
P5