


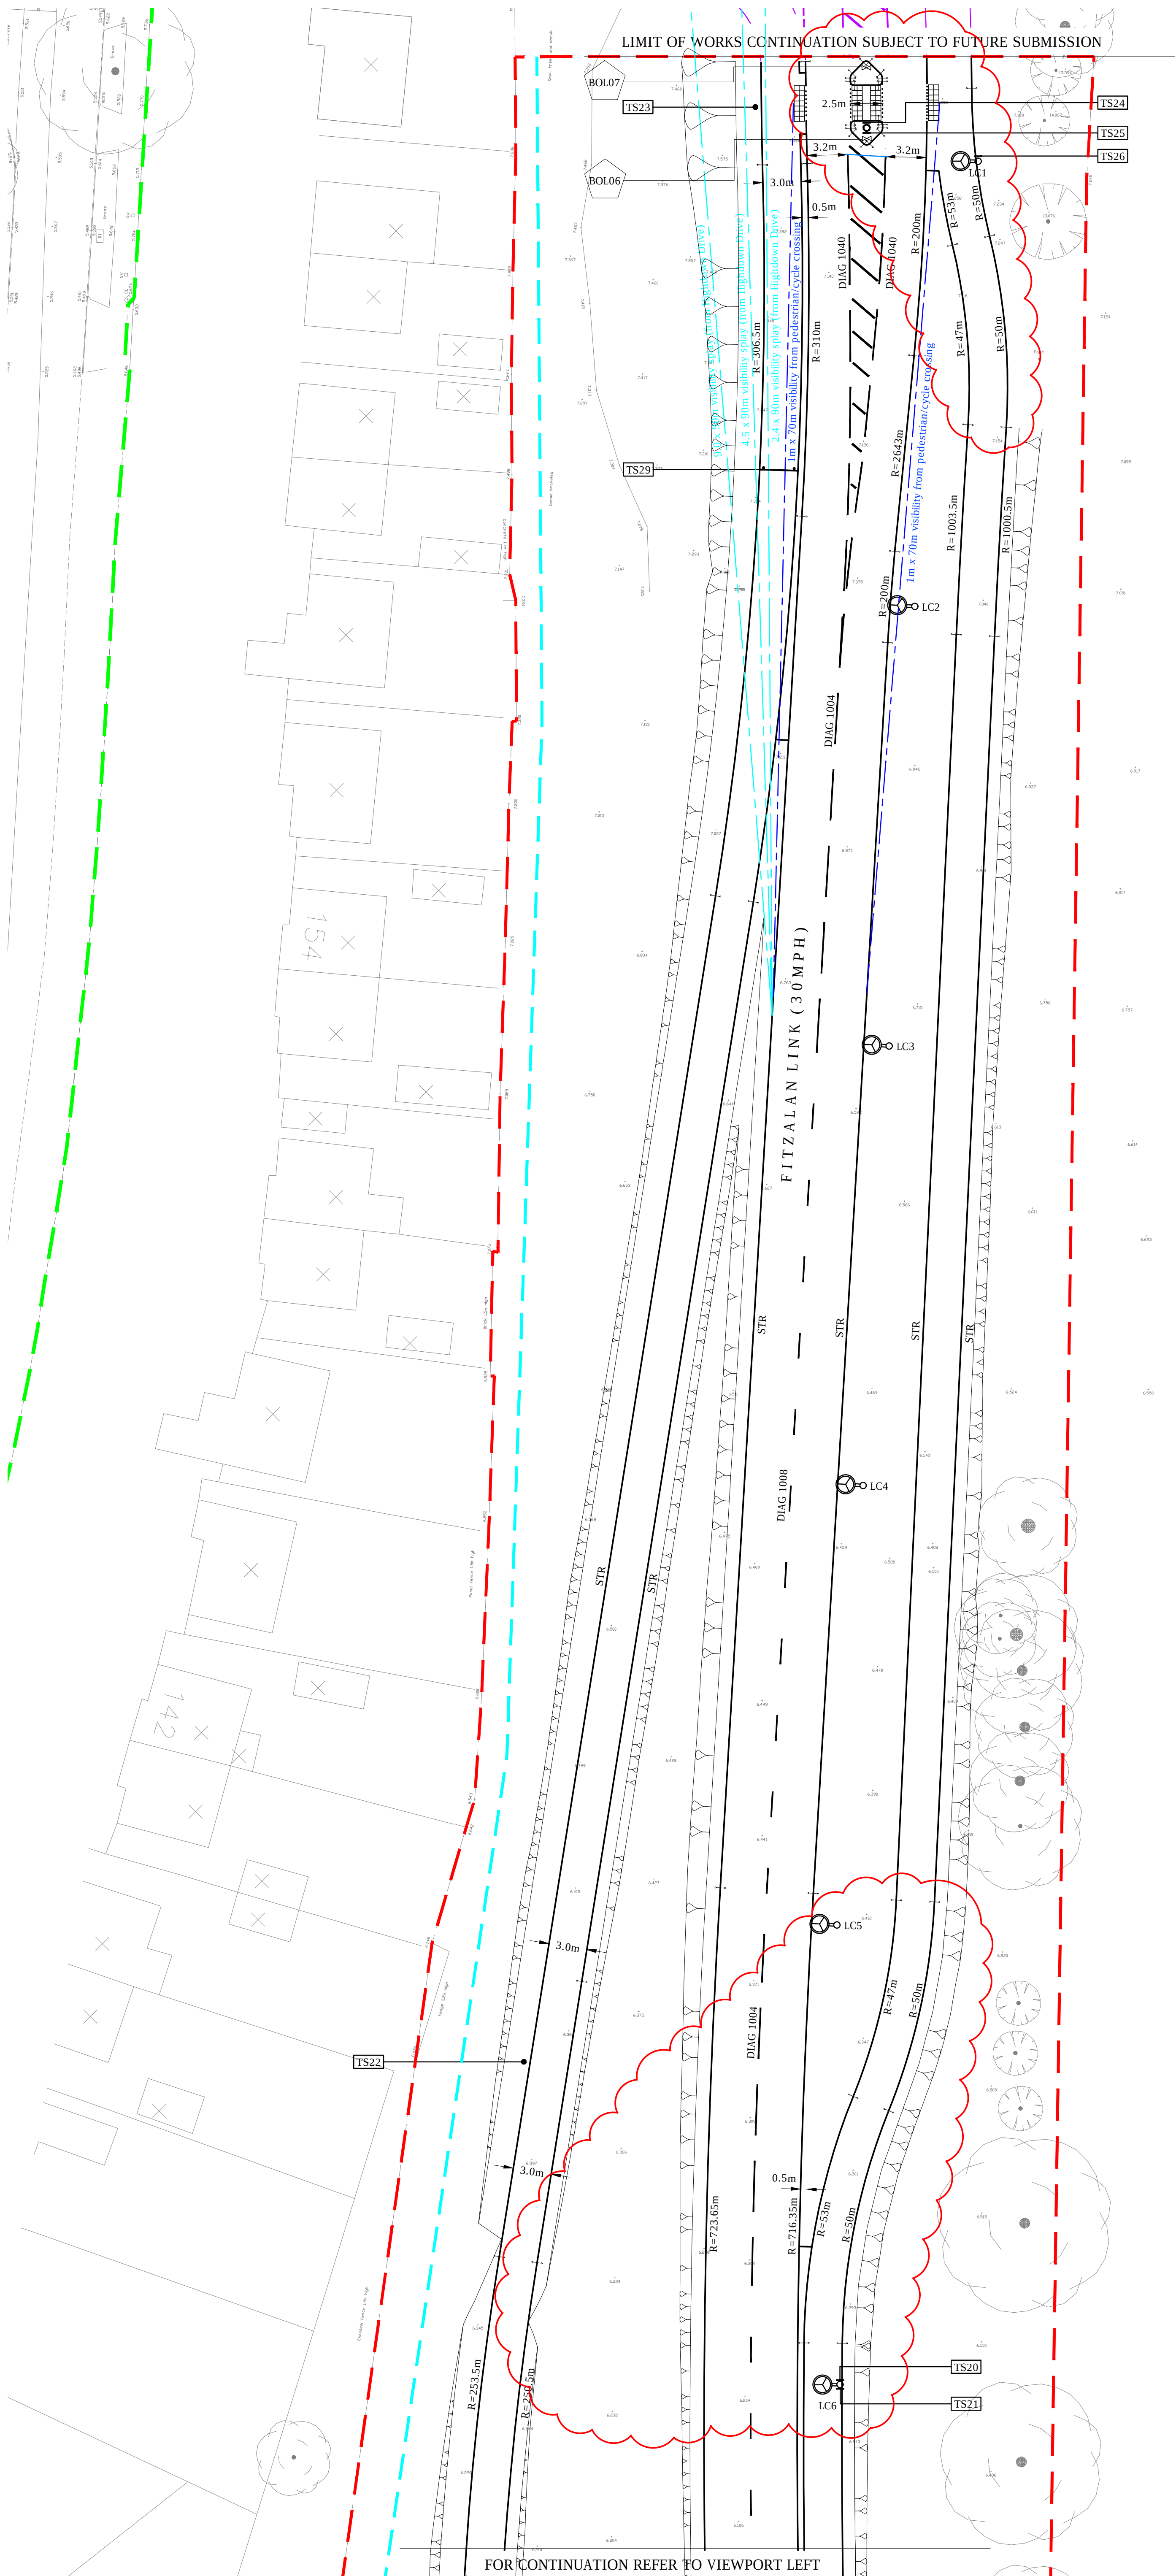

ROAD MARKINGS SCHEDULE				
DIAG NO.	LENGTH (mm)	GAP (mm)	WIDTH (mm)	DESCRIPTION
1003.1	1000	1000	200	Give way at rbt
1004	4000	2000	100	Lanes
1008	2000	4000	100	Lanes
1025.4	1000	1000	100	Bus stop
1040	4000	2000	100	Boundary lines
	-	3000	150	Diagonal lines

© Mayer Brown Limited Copyright. The drawings, information and data recorded in this document ("the information") is the property of Mayer Brown. This document and the information are solely for the use of the authorized recipient and this document may not be used, copied or reproduced in whole or in part for any purposes other than which it was supplied by Mayer Brown. Mayer Brown makes no representation, undertakes no duty and accepts no responsibilities to any third party who may see or rely upon this document or the information.

A0 ORIGINAL

© Crown copyright, all rights reserved. 2012. Licence number 100002189


KEY

EXISTING KERB LINE

PROPOSED KERB/EDGING LINE


PROPOSED DROPPED KERE

DIAG 1234

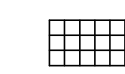

PROPOSED BUFF COLOURED TACTILE PAVING


TMP SOLALITE KEEP LEFT REFLECTIVE BOLLARD
(REFER TO DETAIL 558022-000002001)

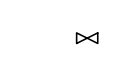

TMP SOLALITE PLAIN FACED REFLECTIVE BOLLARD
(REFER TO DETAIL 558022-000002001)



PROPOSED ROLLARD REFERENCE

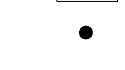

PROPOSED WSCC S278/3



PROPOSED EARTHWORKS



PROPOSED SIGN



PROPOSED SIGN REFERENCE



SEE DRAWINGS SSE-976262-SL-DR-001-A AND 00
A FOR DETAILS

PROPOSED 2.5-HIGH NOISE

PROPOSED LIST OF WORKS

RECORD PLANS

NOTES:

1. School site layout has been taken from WSCC drawing 507344_101 received November 2010.
2. Tree information has been taken from WYG drawing A089072-LEI-N-TCP-01-16 Rev A (Tree Constraints Plan) received 26/06/15.
3. Topo survey has been taken from MB drawing IR.PHLITTLE.2.21 Rev A received 23/01/15.

FOR APPROVAL
NOT FOR CONSTRUCTION

P5	Footway and pedestrian island amended following comments from WSCC dated 21/11/2016. (OIN)	AB	25/11/2016
P4	Earthworks updated after raising levels at the northern end of Fitzalan Link. (OIN)	AB	09/11/2016
P3	Scheme amended following WSCC reserve matters comments dated 21/10/16. (PB)	AB	03/11/2016
P2	Noise barrier bright and location updated. (OIN)	AB	22/07/2016

rev.	amendment	checked	date
------	-----------	---------	------



Mayer Brown Limited
Lion House Oriental Road Woking, Surrey GU22 8AR
Telephone 01483 750 508 Fax 01483 750 437
wokingoffice@mayerbrown.co.uk www.mayerbrown.co.uk

client
PERSIMMON HOMES

project

NORTH LITTLEHAMPTON PHASE 2
FITZALAN LINK S278 WORKS

scale	1:250 @ A0	drawn by	PB	checked by	AB
-------	------------	----------	----	------------	----

date	MARCH 2016	cad file	MASTER - FITZ.DWG
------	------------	----------	-------------------

title

PROPOSED S278 HIGHWAY WORKS
GENERAL ARRANGEMENT DRAWING (2 OF 2)

drawing number	rev.
PHF-MB-S278-GF-DR-D-210-02	P5