



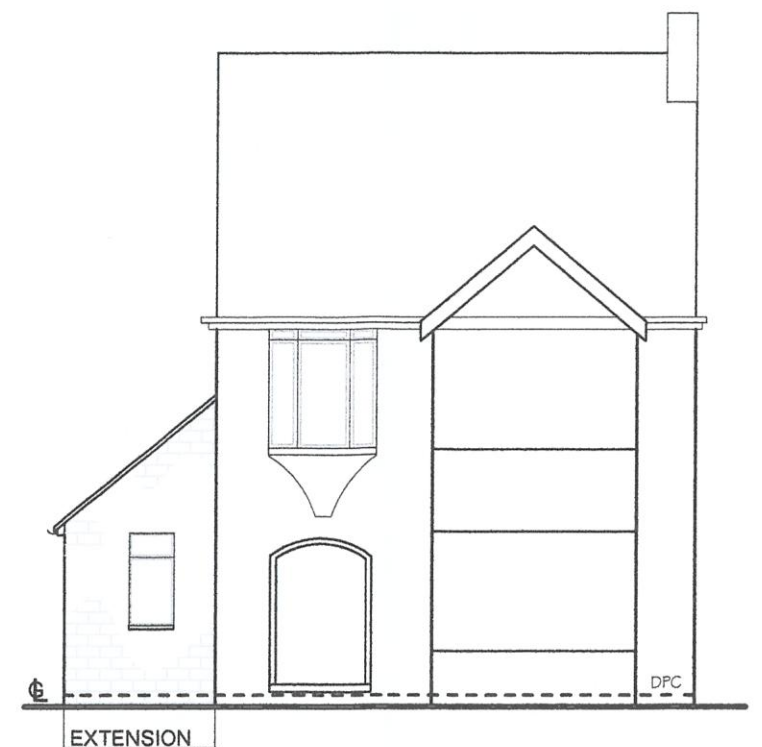


No change to this Elevation

PROPOSED NORTH ELEVATION
(AS BUILT)

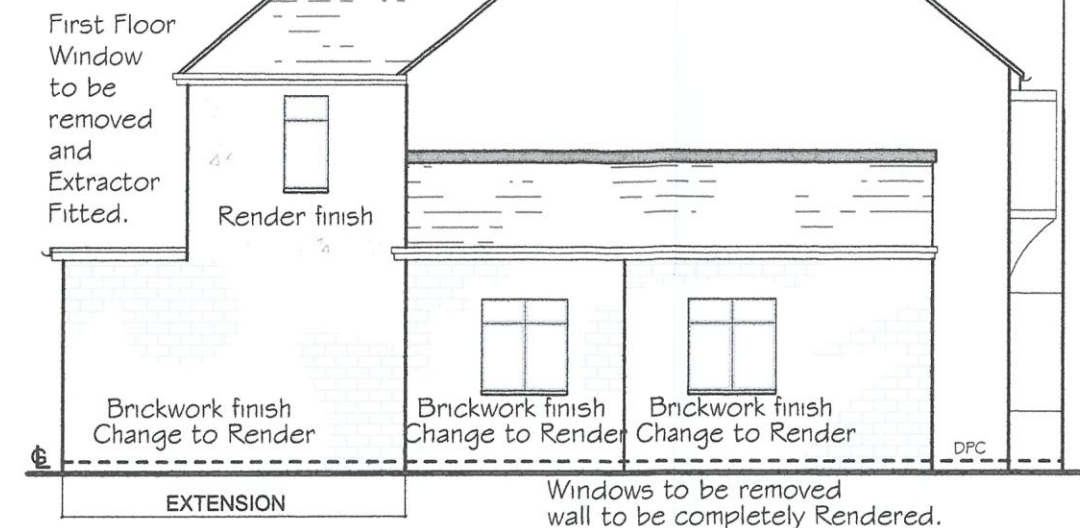

Windows to be removed
wall to be completely Rendered.
First Floor window to be removed
and extractor fitted.

PROPOSED EAST ELEVATION
(AS BUILT)

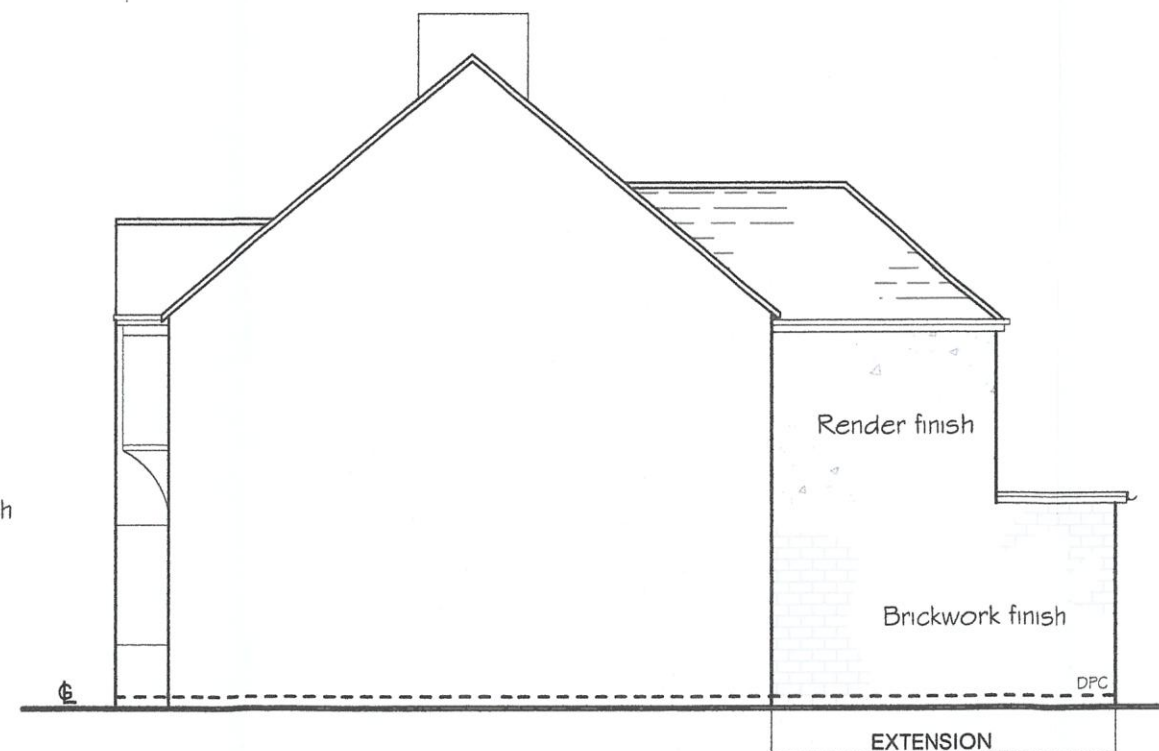

PROPOSED WEST ELEVATION
(AS BUILT)

Proposed extension as initially
submitted. Brick Finish to match
existing.

Client wishes to apply for
Retrospective
Planning amendment regarding
materials.

Material change requested is:
Blockwork and render finish.



PROPOSED SOUTH ELEVATION
(AS BUILT)

Proposed extension as initially
submitted. Brick Finish to match
existing.

Client wishes to apply for
Retrospective
Planning amendment regarding
materials.

Material change requested is:
Blockwork and render finish to
elevations.

Window to be removed and
Patio Doors
installed.

Window 1200mm x 1400mm
to be installed.

Notes

1. Do not scale from this drawing, except for planning purposes. Use figured dimensions only.
2. All dimensions must be checked on site prior to commencement of work.
3. Where applicable this drawing is to be read in conjunction with other consultants drawings.
4. This drawing is the copyright of HATTON ASSOCIATES.

REV	DATE	AMENDMENT	CHECK
-----	------	-----------	-------

HATTON ASSOCIATES

ARCHITECTURAL TECHNICIANS

TEL - Mobile - 07821 891752

email - smethman.hatton@gmail.com

CLIENT
MISS HARRIS

PROJECT
PARKFIELD
WORTHING ROAD
LITTLEHAMPTON
WEST SUSSEX
BN17 6JN

DRAWING
ELEVATIONS AS BUILT

SCALE
1:100
@ A3

DATE	OCT 2020	DRAWN	I.H	CHECKED
DRAWING NUMBER	02	REVISION		