


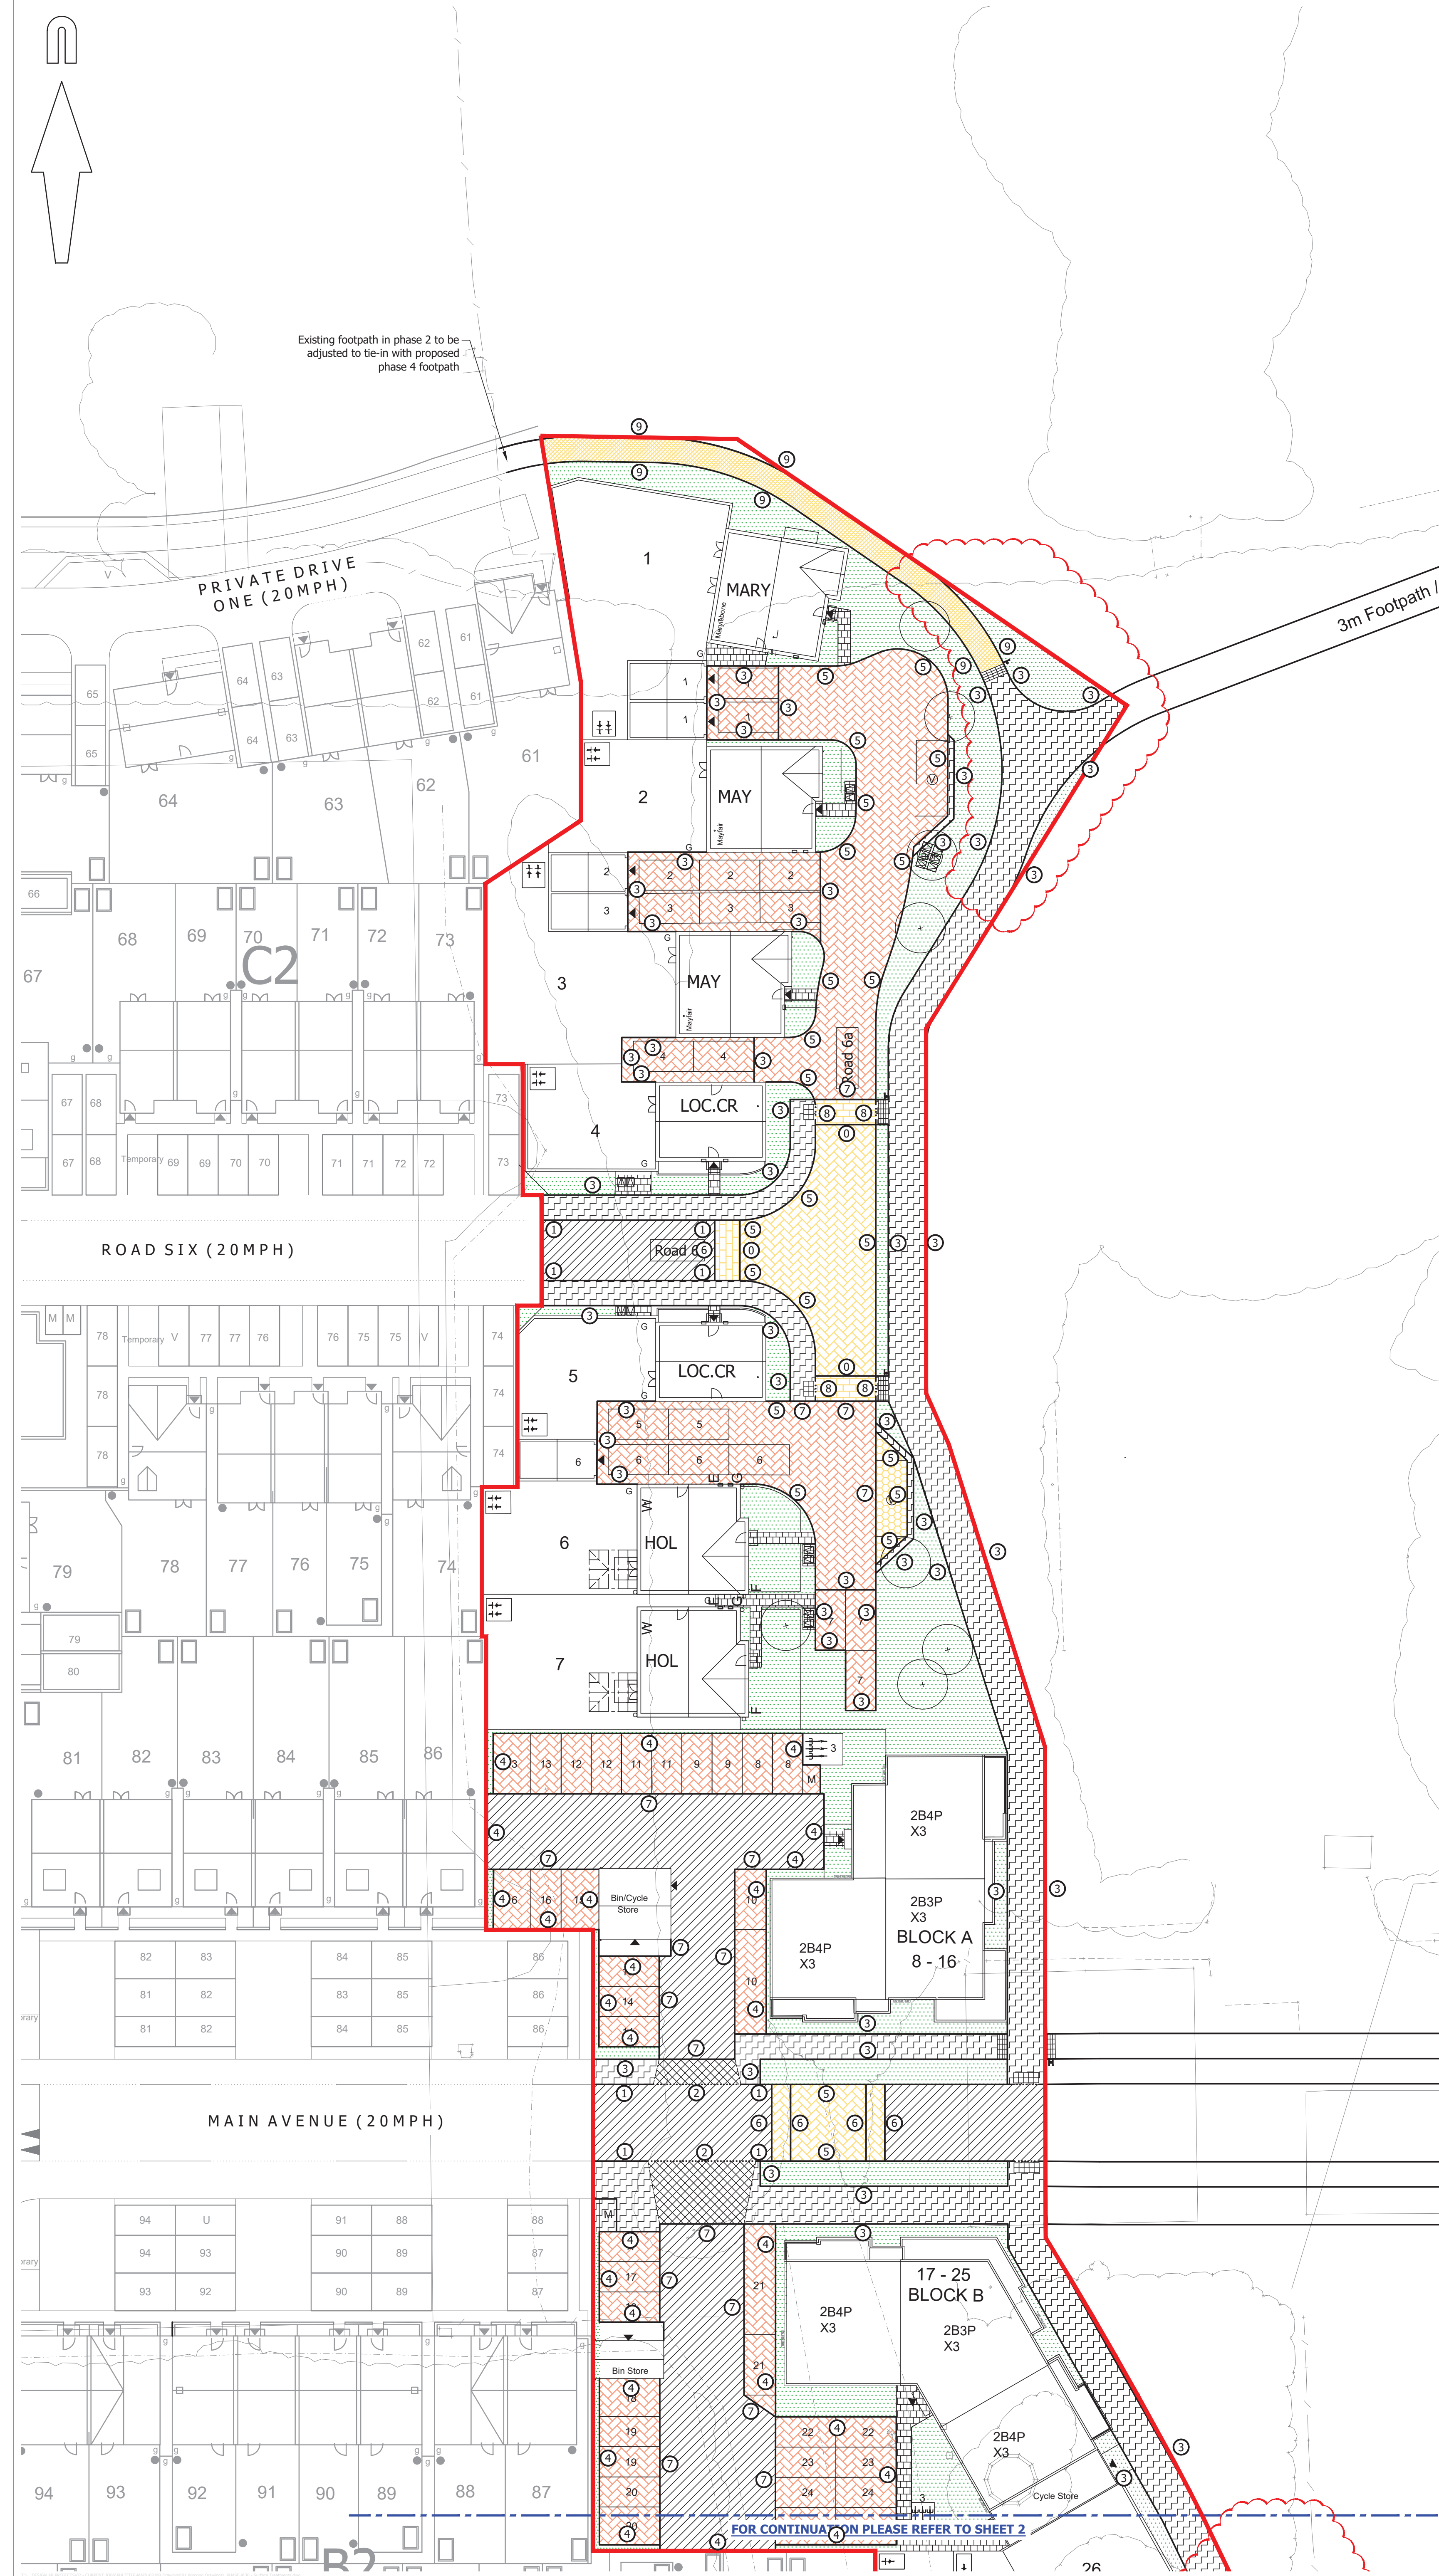

© Mayer Brown Limited Copyright. The drawings, information and data recorded in this document ("the information") is the property of Mayer Brown. This document and the information are solely for the use of the authorised recipient and this document may not be used, copied or reproduced in whole or part for any purposes other than which it was supplied by Mayer Brown. Mayer Brown makes no representation, undertakes no duty and accepts no responsibility to any third party who may use or rely upon this document or the information.

A1 ORIGINAL

© Crown copyright and database rights 2020. Ordnance Survey 0100031673.

KEY

- EXISTING KERB LINE
- PROPOSED KERB/EDGING LINE
- PROPOSED DROPPED KERB
- PROPOSED TACTILE PAVING
- PROPOSED CORDUROY PAVING
- PROPOSED TRAFFIC SIGN AND SIGN POST
- PROPOSED BITUMEN MACADAM CARRIAGEWAY SURFACING
- PROPOSED FULL DEPTH LOCAL DISTRIBUTOR RAISED TABLE CONSTRUCTION MAIN AVENUE
- PROPOSED MARSHALLS BLOCK PAVED CARRIAGEWAY SURFACING (BRINDLE) COLOUR LAID IN HERRINGBONE PATTERN
- PROPOSED MARSHALLS BLOCK PAVED RAMP (BRINDLE) CONSTRUCTION TYPE 5
- PROPOSED PERMEABLE PAVING (BRINDLE) COLOUR
- PROPOSED MARSHALLS BLOCK PAVED SHARED / PRIVATE DRIVE SURFACING (BRACKEN) COLOUR LAID IN HERRINGBONE PATTERN
- PROPOSED BUFF COLOURED SELF BINDING COMPACTED GRAVEL (BUFF) COLOUR WITH TIMBER EDGING
- PROPOSED MARSHALLS BUFF COLOURED SLAB PRIVATE FOOTWAY CONSTRUCTION
- PROPOSED BITUMEN MACADAM FOOTWAY CONSTRUCTION
- PROPOSED BITUMEN MACADAM FOOTWAY CROSSOVER TYPE 1
- PROPOSED SOFT LANDSCAPING (REFER TO LANDSCAPE ARCHITECT DRAWINGS)
- SITE BOUNDARY

KERB TYPES

- TYPE 0 - NO KERB
- TYPE 1 - HB2 - 125mm UPSTAND
- TYPE 2 - BN - 25mm UPSTAND (VEHICULAR CROSSOVER)
- TYPE 3 - EF - FLUSH
- TYPE 4 - HB2 - 100mm UPSTAND
- TYPE 5 - BN - 50mm UPSTAND (UPSTAND ON RAISED TABLE)
- TYPE 6 - MARSHALLS 'SPEEDCHECK' KERB (OR SIMILAR APPROVED)
- TYPE 7 - CS1 - FLUSH
- TYPE 8 - BN - 0-6mm FLUSH
- TYPE 9 - 40mm x 150mm TIMBER EDGING

NOTES:

- This drawing is not to be scaled.
- Drawing based on Persimmon Homes Thames Valley Architect's 'Site Layout' drawing reference 545_PL_101, received on 04/06/2020.
- Based on topographic survey by WYG drawing numbered GGL/A044029/LAY/01.
- This drawing is to be read in conjunction with all other relevant engineering and landscaping drawings. Any discrepancies are to be reported to the Engineer immediately for clarification.

FOR INFORMATION
NOT FOR CONSTRUCTION

P9	Junction between footpath linking phase 2 and 4, and cycleway amended to match revised Architect's layout received on 26/03/2021 (clouded). Red line boundary amended. (TC)	SF	30/03/21
P8	Footpath linking phase 2 and 4 amended to a constant 2m width. (TC)	SF	18/03/21
P7	Drawing updated following Stage 2 RSA comments dated 28/11/2020. Key updated. (TC)	SF	18/12/20
P6	Drawing updated following revised layout. Key Updated. (TC)	SF	02/10/20
P5	hatching in parking courts A & B and along the main avenue updated. (TC)	SF	09/06/20
P4	Drawing updated following revised layout. (TC)	SF	05/06/20
P3	Drawing updated following revised layout. (TC)	SF	14/04/20
P2	Drawing updated following revised layout. (TC)	SF	06/03/20
P1	Initial Issue. (TC)	SF	04/02/20

rev.	amendment	checked	date
------	-----------	---------	------



Mayer Brown Limited
Lion House Oriental Road Woking Surrey GU22 8AR
Telephone 01483 750 508 Fax 01483 750 437
wokingoffice@mayerbrown.co.uk www.mayerbrown.co.uk

client
PERSIMMON HOMES THAMES VALLEY

project
PHASE 4
LITTLEHAMPTON

scale
1:250

drawn by
TC

checked by
SF

date
FEBRUARY 2020

cad file
30.DWG

title
SURFACE TREATMENTS DRAWING
(SHEET 1 OF 3)

Mayer Brown Limited jobcode
suitability
revision
P9

drawing number
PHLITTLE P4-30-1