



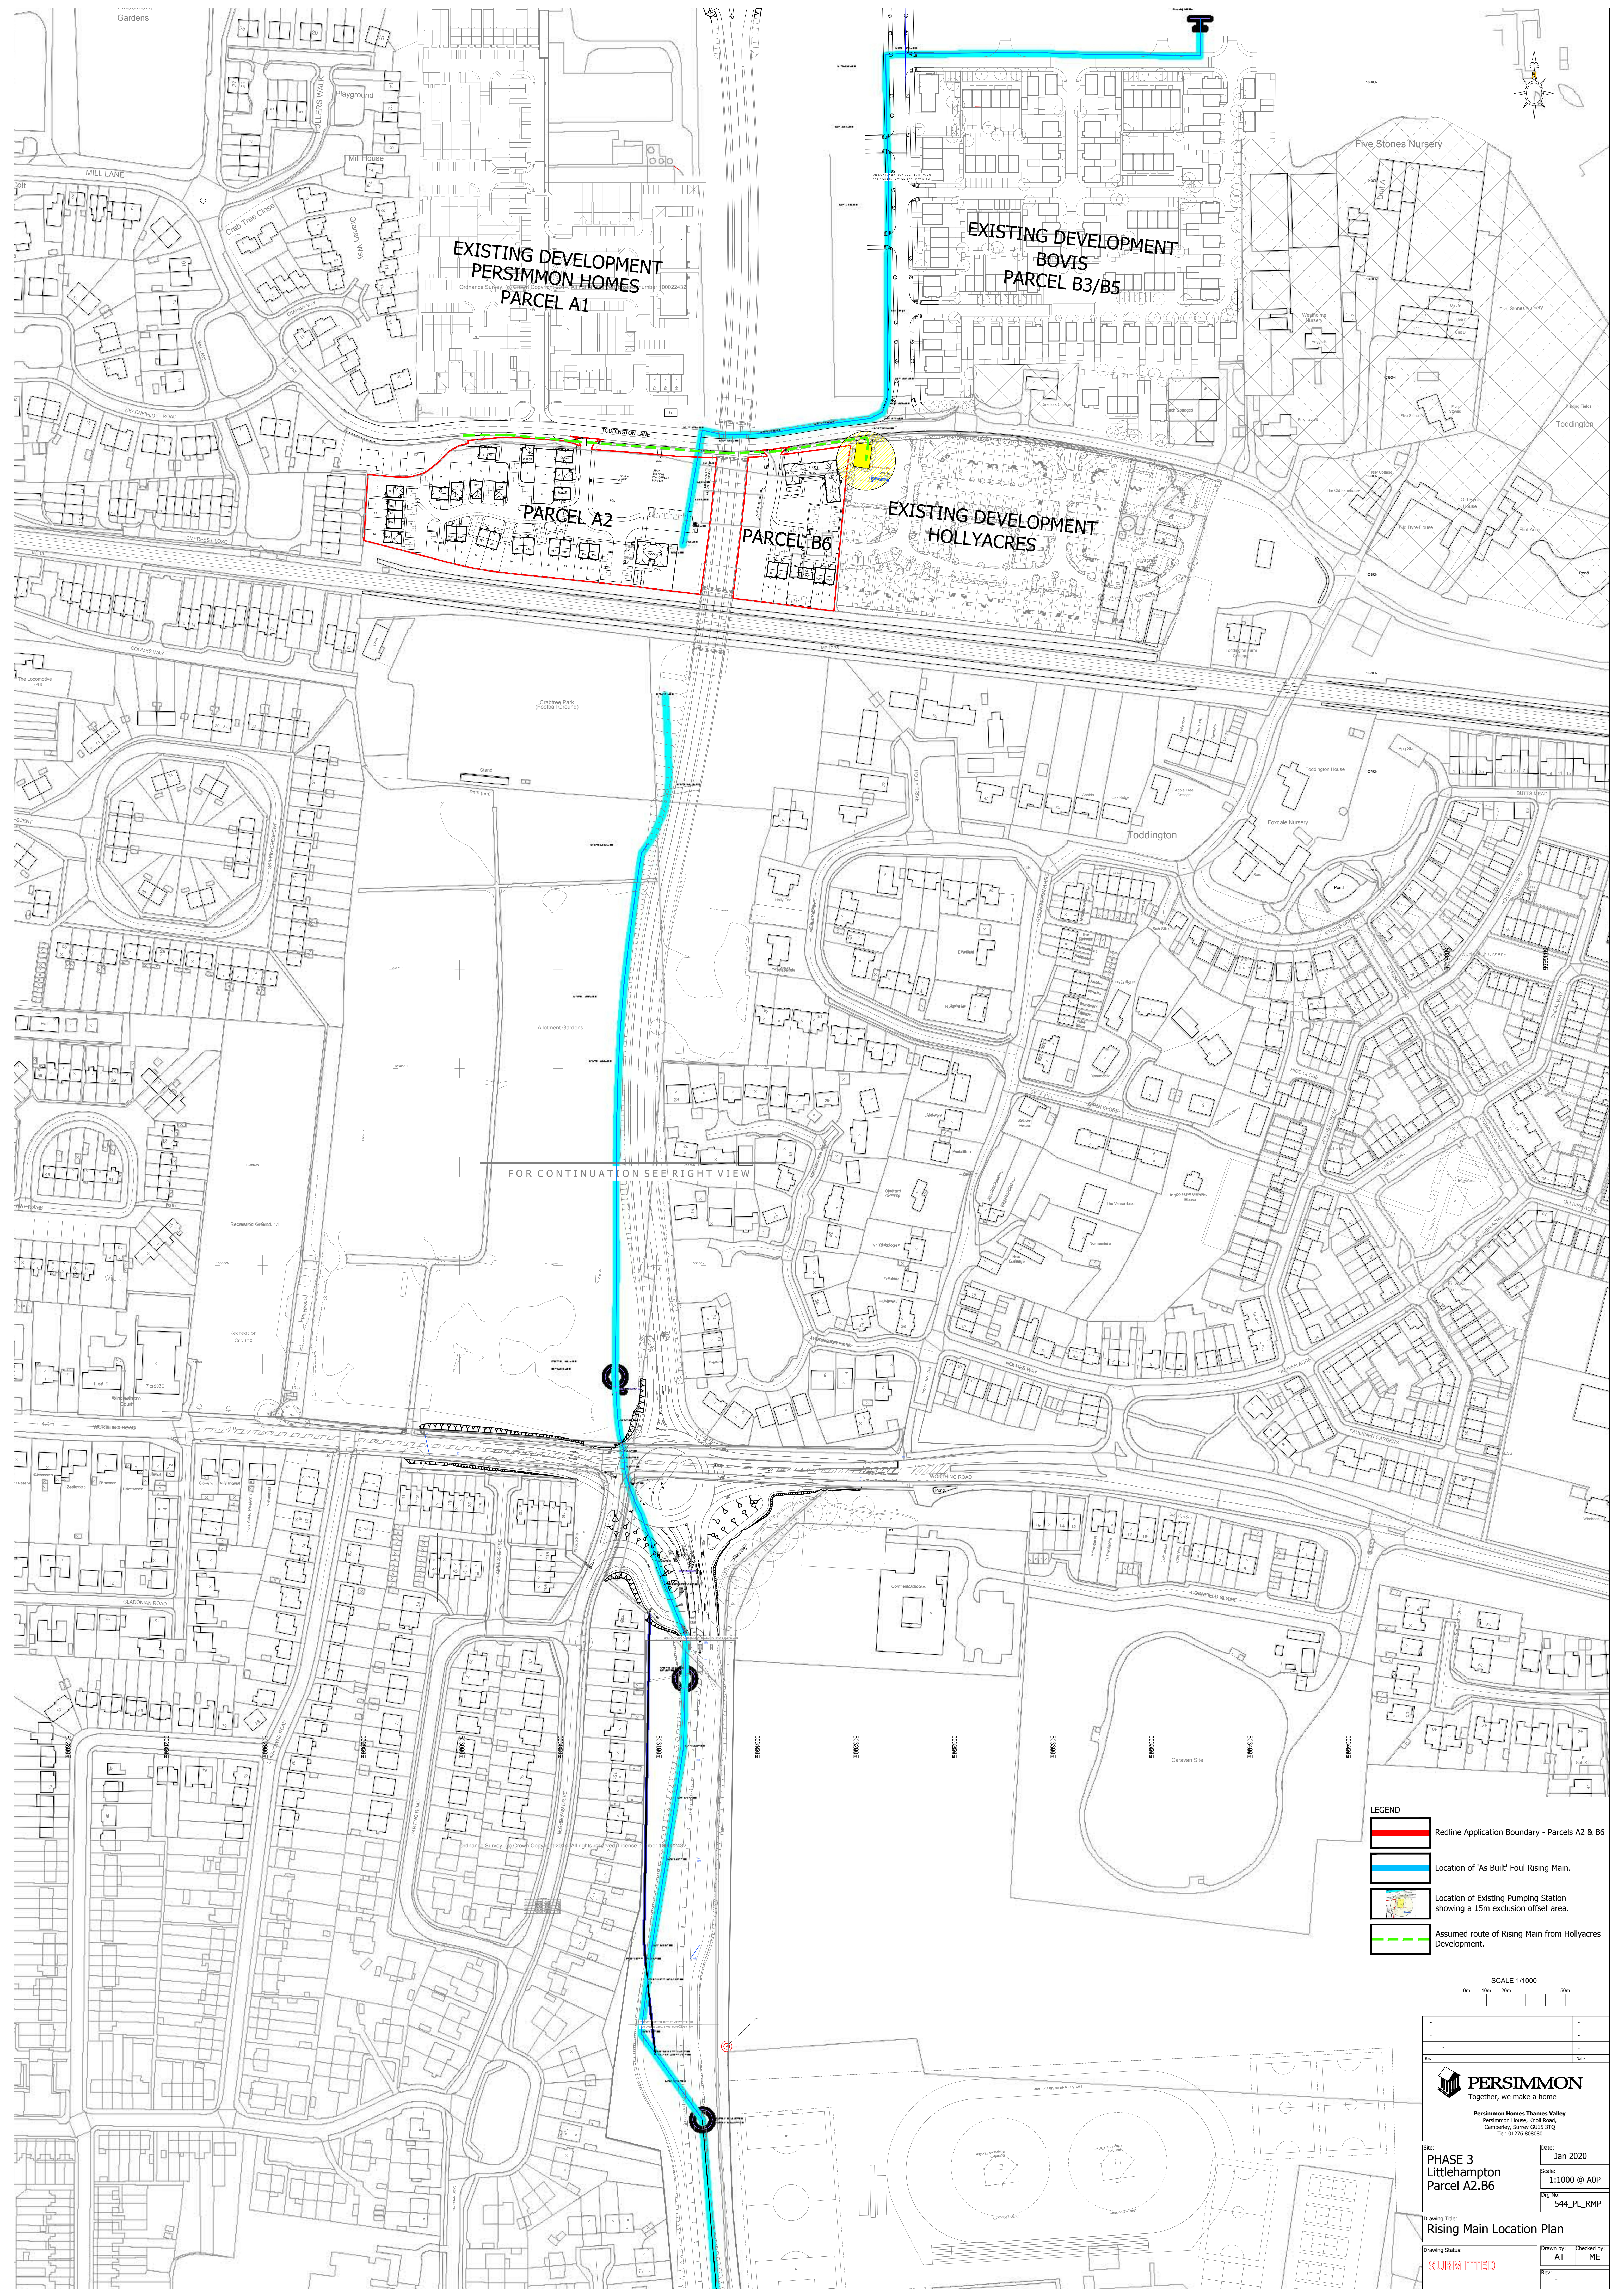

FOR CONTINUATION SEE RIGHT VIEW

- LEGEND
- Redline Application Boundary - Parcels A2 & B6
 - Location of 'As Built' Foul Rising Main.
 - Location of Existing Pumping Station showing a 15m exclusion offset area.
 - Assumed route of Rising Main from Hollyacres Development.

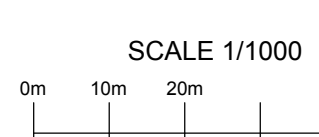

Persimmon Homes Thames Valley
Persimmon House, Kest Road,
Cannock, Staffs SN1 2JQ
Tel: 01276 808890

Site: PHASE 3 Littlehampton Parcel A2,B6
Date: Jan 2020
Scale: 1:1000 @ AOP
Dwg No: 544_PL_RMP

Drawing Title: Rising Main Location Plan

Drawing Status: SUBMITTED
Drawn by: AT
Checked by: ME
Rev: